


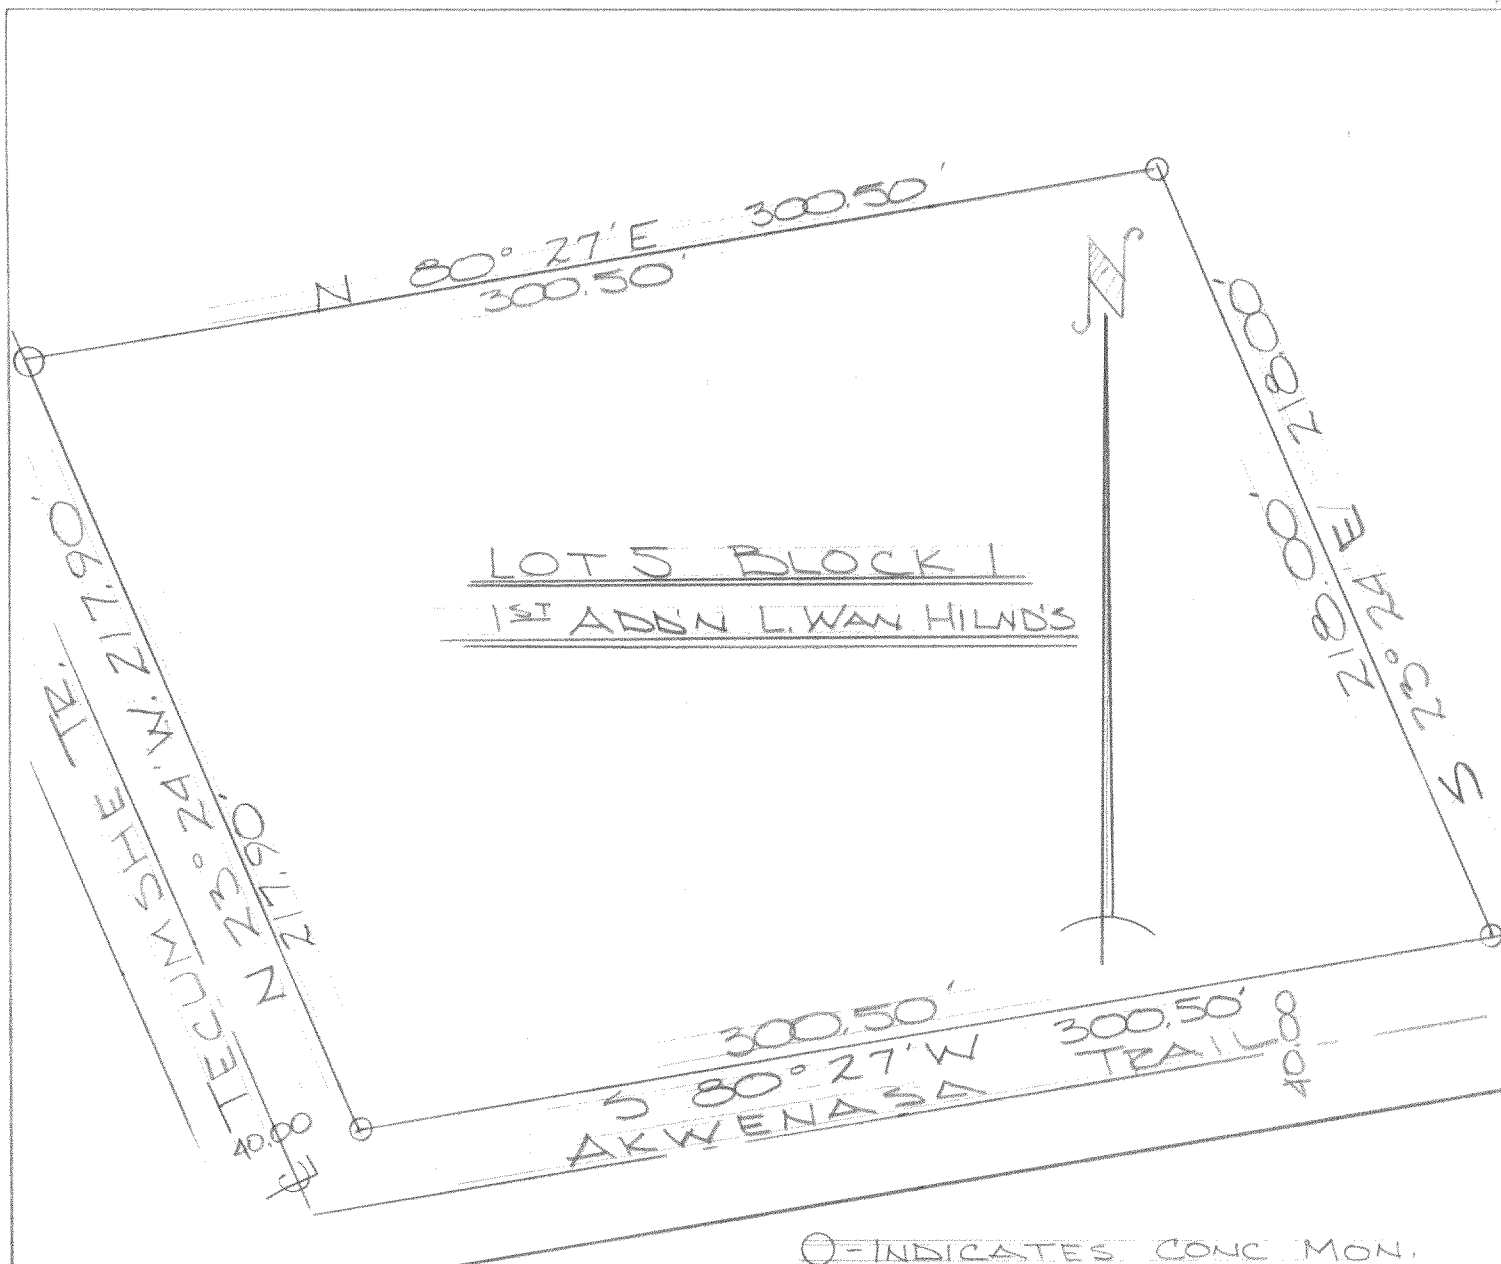


DESCRIPTION:

Lot 5, Block 1; Lake Wandawega Highlands, First Addition,
a subdivision of a portion of the N.E. $\frac{1}{4}$ of Section 11,
Town 3 north, Range 16 east, Sugar Creek, Walworth County,
Wisconsin.

Certificate:

I, James F. Biagi, surveyor, do hereby certify that I
have surveyed the property hereon described

Signed:
August 15th 1967.

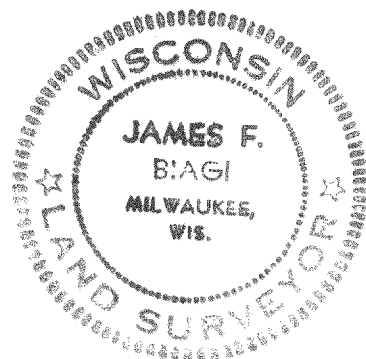

James F. Biagi
James F. Biagi. RLS 272
Elkhorn, Wisconsin.