



#112-68

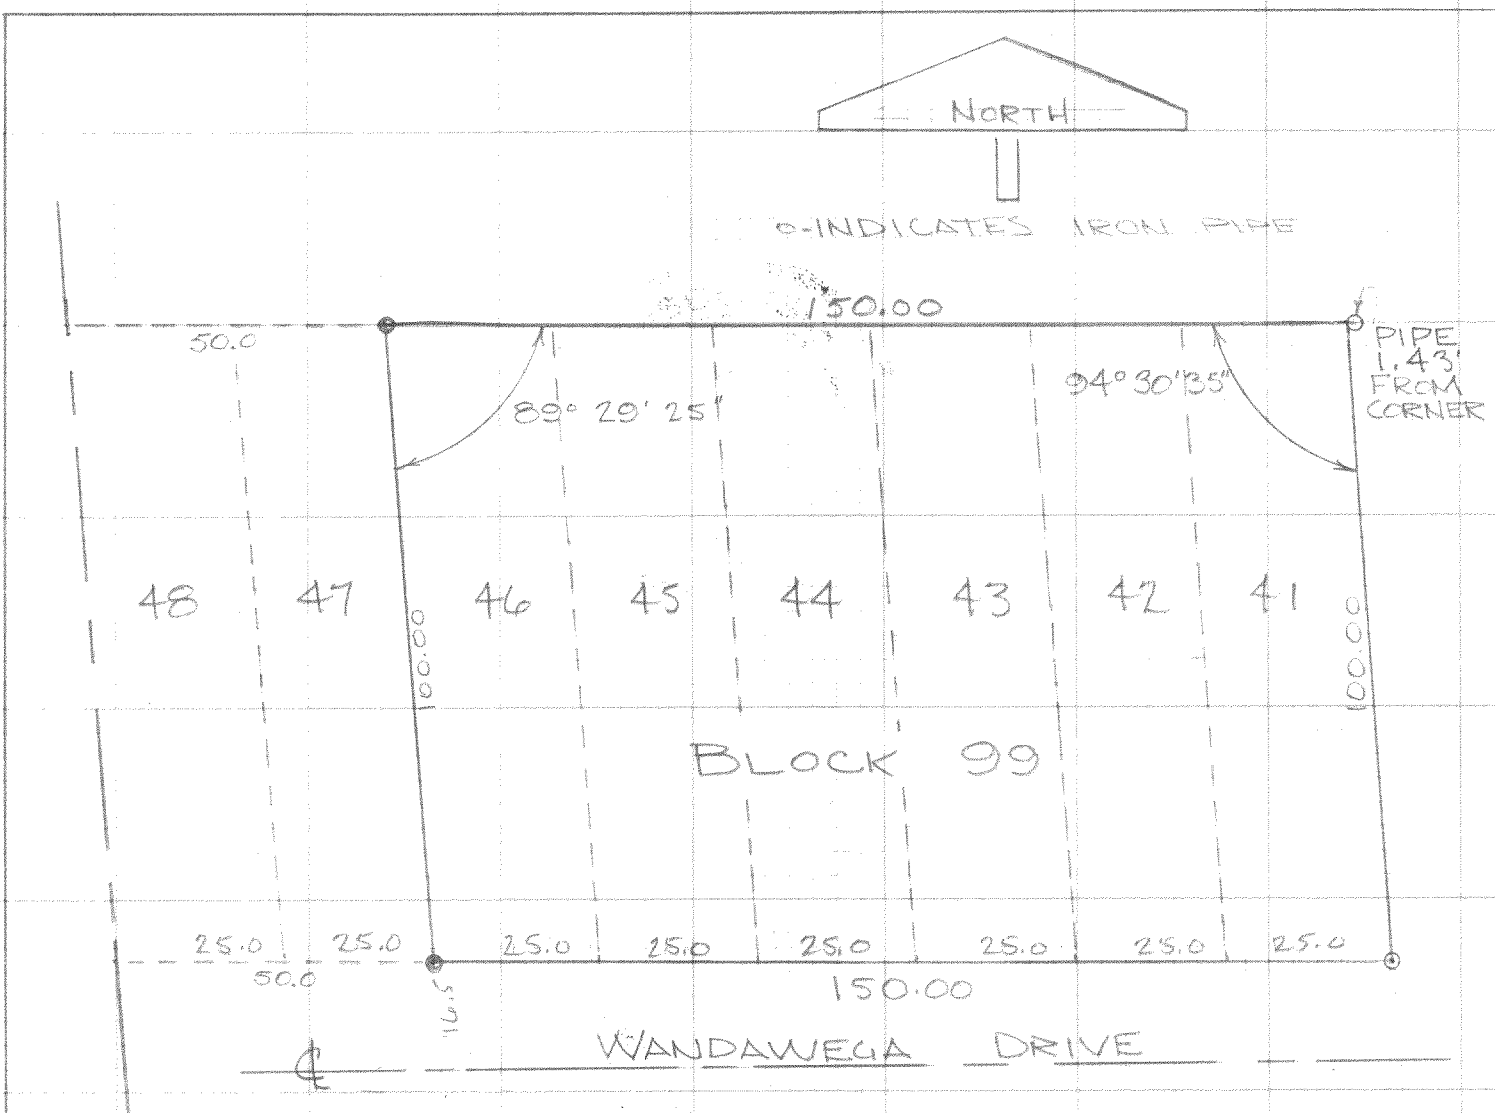

DESCRIPTION: Lots 41, 42, 43, 44, 45, & 46 of Block 99 of Lake Wandauega Subdivision located in Section 1, T. 3 N., R. 16 E., Walworth County, Wisconsin.

CERTIFICATE: I, James F. Biagi, surveyor, do hereby certify that I have surveyed the property hereon described.

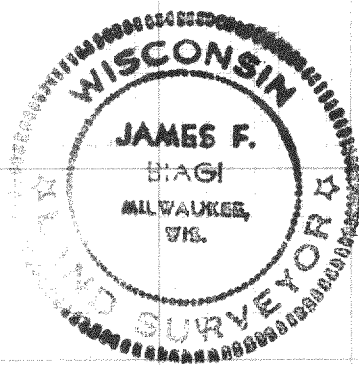

James F. Biagi
James F. Biagi RLS 272

August 19, 1968

316-74B