


116-62

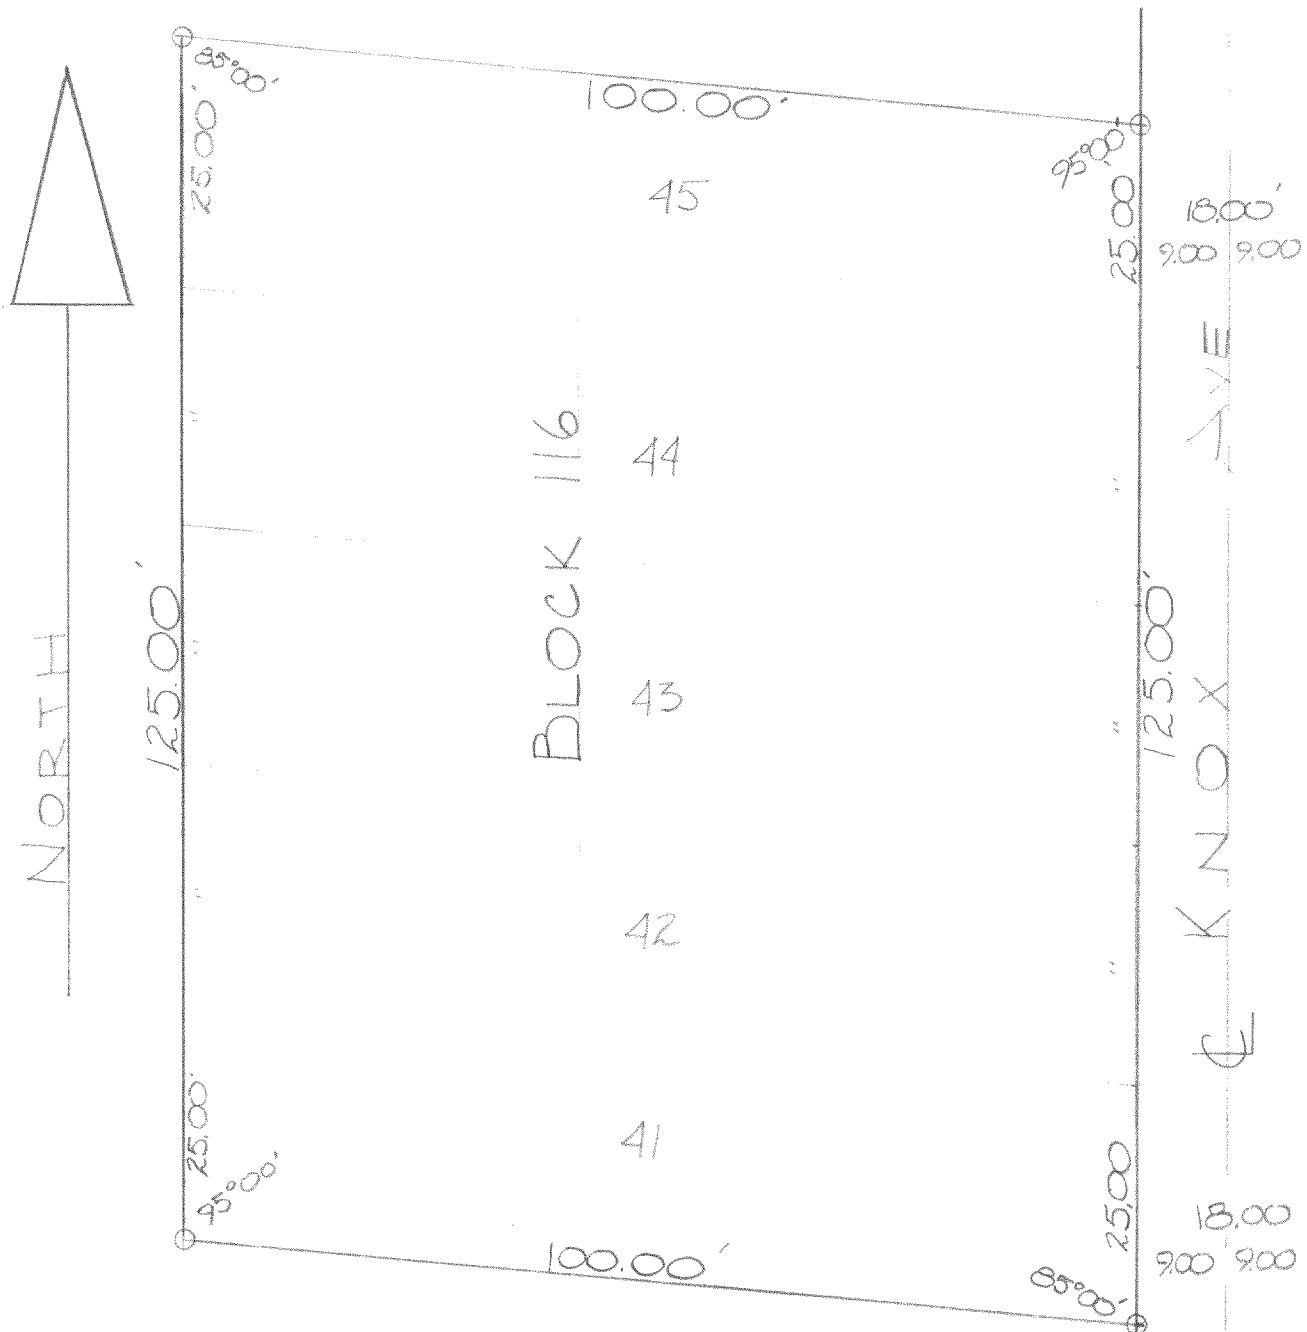


DESCRIPTION:

Lots 41, 42, 43, 44, 45, Block 116, Lake Wandawega Subdivision of a portion of Section 1, Township 3 north, Range 16 east of the 4th Principal Meridian, Sugar Creek Township, Walworth County Wisconsin.

CERTIFICATE:

I, James F. Biagi, Surveyor, do hereby certify that I have on this the 20th day of June 1962. surveyed the above described property.

SIGNED AND SEALED ON THIS 21st DAY OF JUNE, 1962.

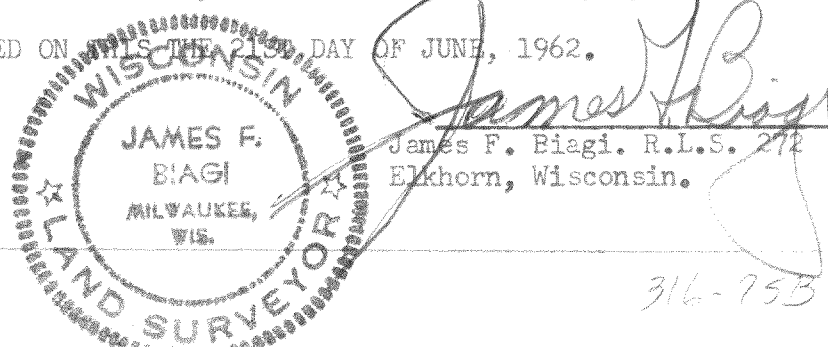

62W 346

316-753