


18' SUGAR CREEK LANE

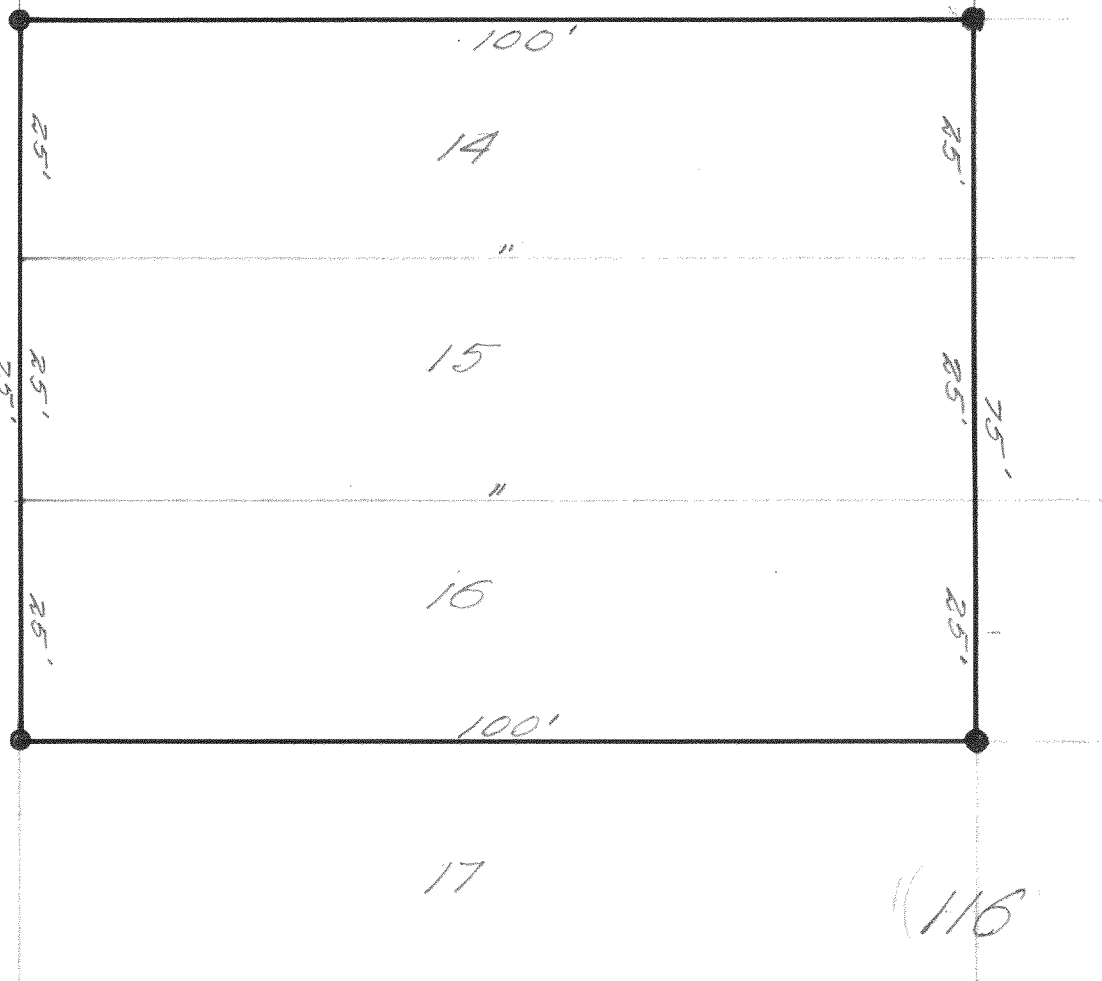

DESCRIPTION: Lots 14, 15, and 16, Lake Wandawega Subdivision of Sections 1 and 2, Town 3 north Range 6 east of the 4th P. M.

CERTIFICATE: I hereby certify that I have on this the 30th day of June 1945 surveyed the above described property according to the official records on file in the office of the Recorder of Deeds in and for Walworth County Wisconsin and find that no encroachments exist and that the plat hereon portrayed is an exact reproduction of the conditions found at the site on this day.

SIGNED AND SEALED THIS 31st DAY OF JUNE 1945.

Joseph M. Biagi
Joseph M. Biagi Professional Engineer.
Elkhorn Wisconsin.