


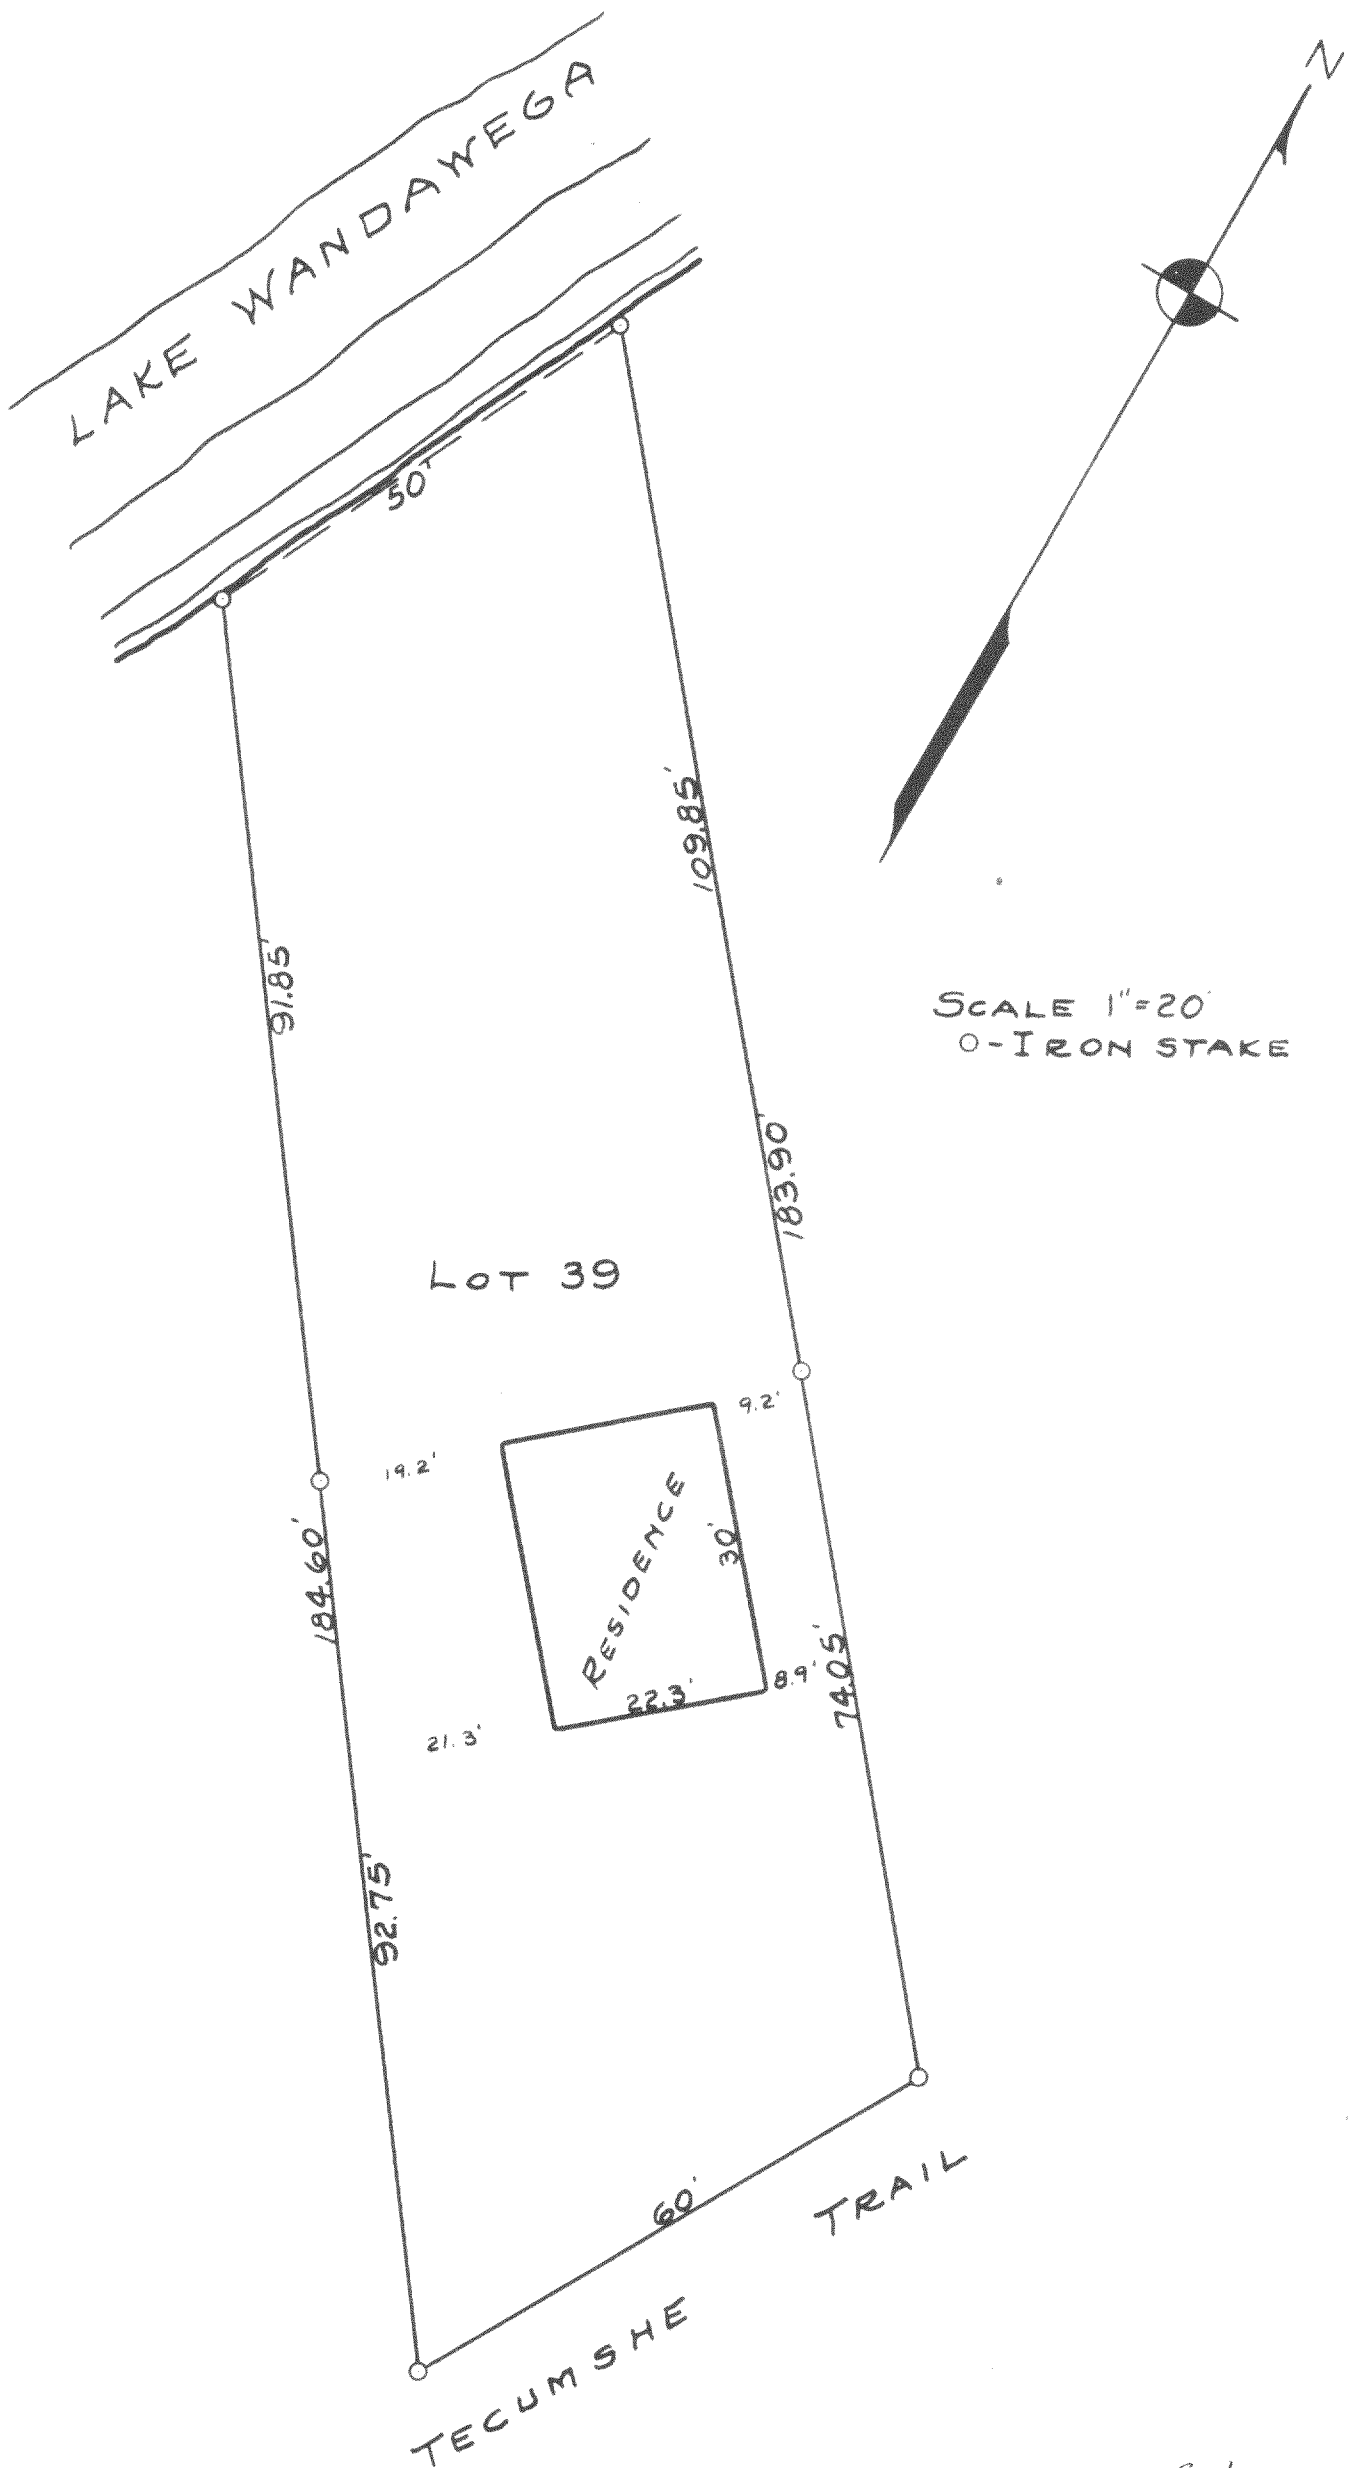

SCALE 1"=20'
O-IRON STAKE

316-8.1

PLAT OF SURVEY OF LOT 39 OF BLOCK I
OF LAKE WANDAWEGA HIGHLANDS, A SUBD-
IVISION LOCATED IN SECTIONS 11 AND 12
OF T3N R16E OF WALWORTH COUNTY WISCONSIN.

OCT. 1945

Lloyd L. Jensen
COUNTY SURVEYOR