


WISCONSIN - STREET



A parcel of land located in Block 104 of the Lake Wandawega Subdivision lying in the Southeast 1/4 of Section 2, Township 3 North, Range 16 East, Walworth County, Wisconsin, more particularly described as follows: All of Lots 1, 2, 3 and 4 in the above described Subdivision and all of that portion of Lot 5 lying northerly of a line commencing at the Southwest Corner of said Lot 5, being 1" diameter iron pipe, Lot 5, and ending at the Northeast corner of said Lot 5, being a 1/4' rebar.

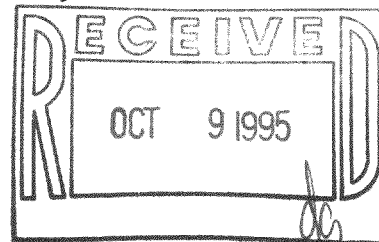

THIS SURVEY IS MADE FOR THE USE OF THE PRESENT OWNERS OF THE PROPERTY, AND ALSO THOSE WHO PURCHASE, MORTGAGE, OR GUARANTEE THE TITLE THERETO WITHIN ONE (1) YEAR FROM DATE HEREON.

August 1, 1995

DATE 7/1/72 JOB NUMBER - 95128
NOTE: THIS IS NOT A CERTIFIED COPY UNLESS SEALED.

$$\mathcal{N}$$

SCALE 1"=20'

LEGEND

GLW-261

316-808