


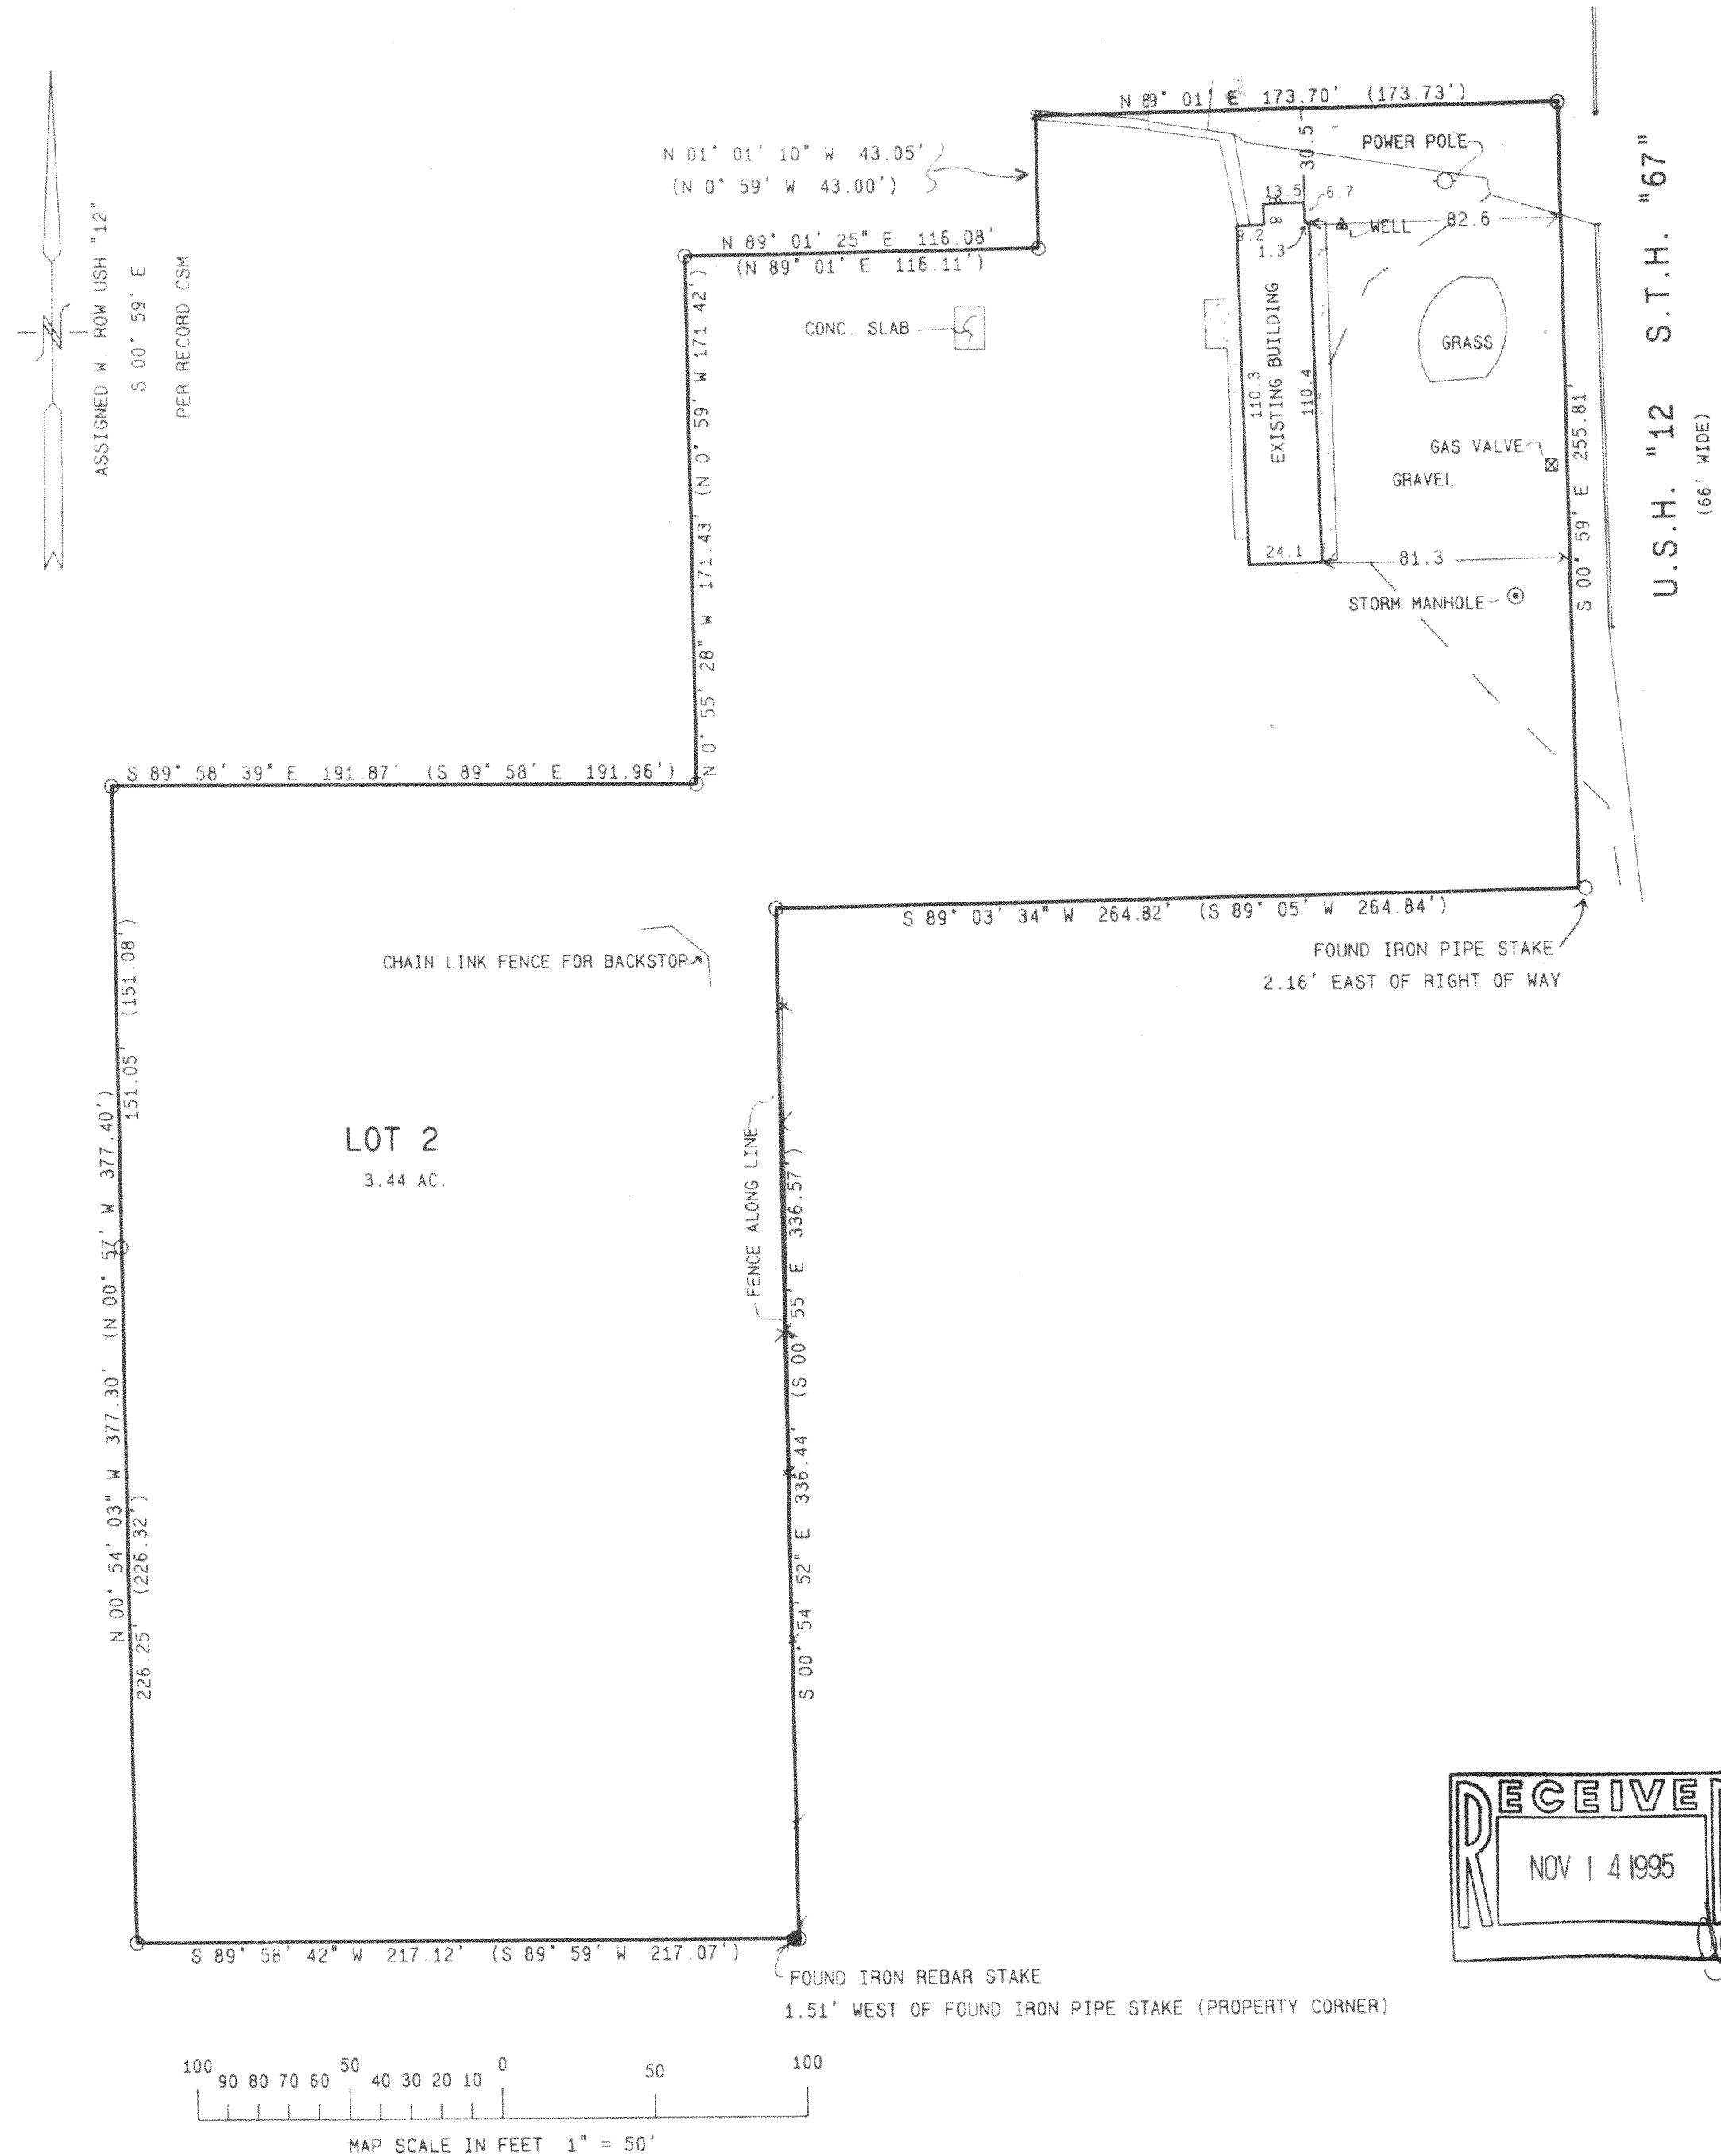

PLAT OF SURVEY LOT 2 OF CERTIFIED SURVEY MAP NO. 881

RECORDED IN VOL. 4, ON PAGE
NO. 92, AS DOCUMENT NO. 41736
OF WALWORTH COUNTY CERTIFIED
SURVEY MAPS; LOCATED IN THE NE
1/4 OF SECTION 13, TOWN 3
NORTH, RANGE 16 EAST, WALWORTH
COUNTY, WISCONSIN

- = FOUND IRON PIPE STAKE
- = FOUND IRON REBAR STAKE
- * = FOUND CHISELED "X" IN CONCRETE
- (X X) = RECORDED AS

NOTE: COPIES OF THIS MAP TO WHICH THE FOLLOWING CERTIFICATE WILL
APPLY ARE BLUE LINE PRINTS SHOWING SURVEYOR'S ORIGINAL SEAL AND
SIGNATURE IN BLACK INK. COPIES BY ANY OTHER MEANS MAY HAVE
ALTERATIONS WHICH DO NOT REPRESENT THE SURVEYOR'S WORK PRODUCT.

I HEREBY CERTIFY THAT THE ABOVE DESCRIBED PROPERTY HAS BEEN
SURVEYED UNDER MY DIRECTION AND THAT THE ABOVE MAP IS A TRUE
REPRESENTATION THEREOF AND SHOWS THE SIZE AND LOCATION OF THE
PROPERTY AND ITS EXTERIOR BOUNDARIES. THIS SURVEY IS MADE FOR
THE USE OF THE PRESENT OWNERS OF THE PROPERTY, AND ALSO THOSE WHO
PURCHASE, MORTGAGE, OR GUARANTEE THE TITLE THERETO WITHIN ONE
YEAR FROM THE DATE HEREOF.

DATED: 11-08-95

PETER S. GORDON R.L.S. 2101



WORK ORDERED BY: S. S. & B.
INVESTMENTS
STEVE STILLING
N6411 HWY 12
ELKHORN, WI

FARRIS, HANSEN & ASSOCIATES, INC.
Engineering, Architecture, Surveying
7 Ridgway Court, P.O. Box 437
ELKHORN, WISCONSIN 53121
Office: (414) 723-2098
Fax: (414) 723-5886

REVISIONS

PROJECT NO.
4422
DATE
11/08/95
SHEET NO.
1 OF 1

GA-881-2
316-815