


DUNHAM SURVEYING, S.C.
SURVEYING & SUBDIVIDING
DELAVER, WISCONSIN 53115

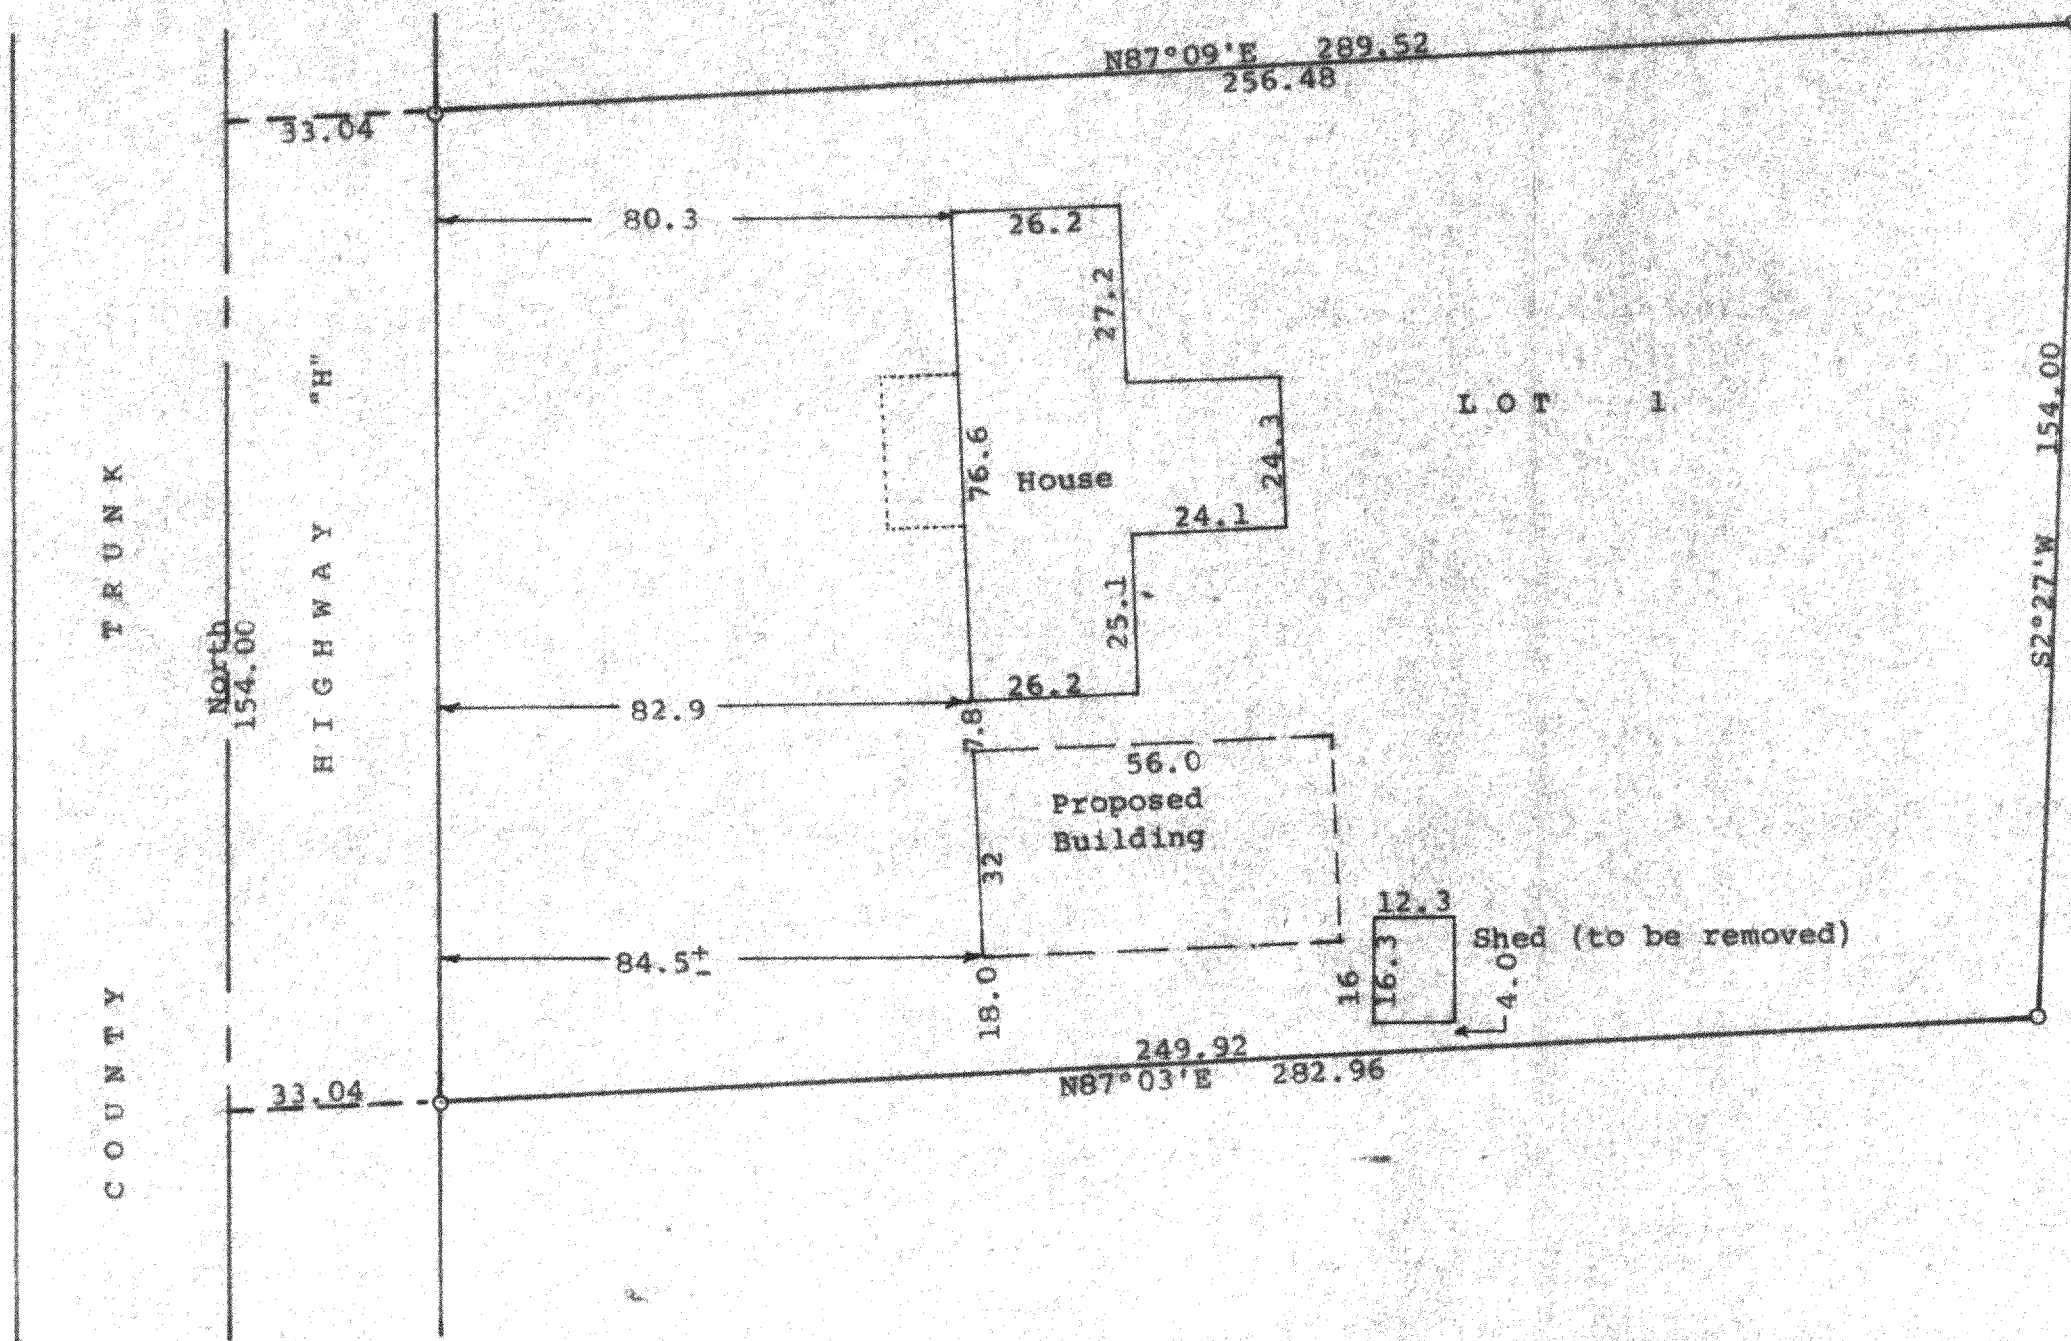

N

Scale - 1" = 30'
O = Iron Pipe Found
Bearings are those on the recorded plat of
Certified Survey No. 442
Survey ordered by: Derald Pontel
N6130 Hwy H
Elkhorn, WI 53121



STATE OF WISCONSIN)
COUNTY OF WALWORTH) SS

I, George T. Dunham, Surveyor, certify that I have surveyed the property described as follows:

Lot 1 of Certified Survey No. 442, recorded in Volume 2 of Certified Surveys, Document No. 685632, in the Office of the Register of Deeds, in and for Walworth County, Wisconsin, being a parcel of land located in the Southwest 1/4 of Section 14, T 3 N, R 16 E, Walworth County, Wisconsin,

and that the plat shown hereon is a correct representation thereof and shows the size and location of the property, its exterior boundaries, the location of all visible structures and dimensions of all principal buildings thereon, boundary fences, apparent easements, roadways and visible encroachments, if any, and that I have surveyed the property described hereon, according to the official records, to the best of my knowledge and belief.
April 19, 1995

George T. Dunham
George T. Dunham, Surveyor

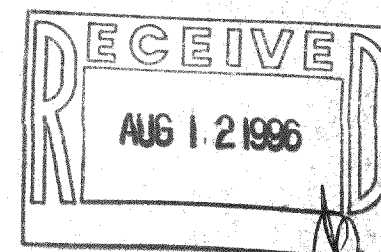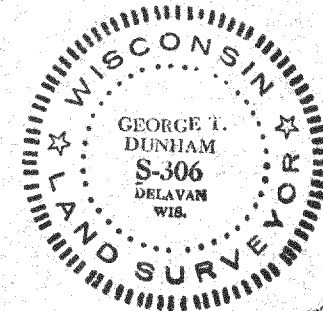

GA-442-1
316-838