


GEORGE T. DUNHAM
SURVEYING & SUBDIVIDING
DELAVER, WISCONSIN

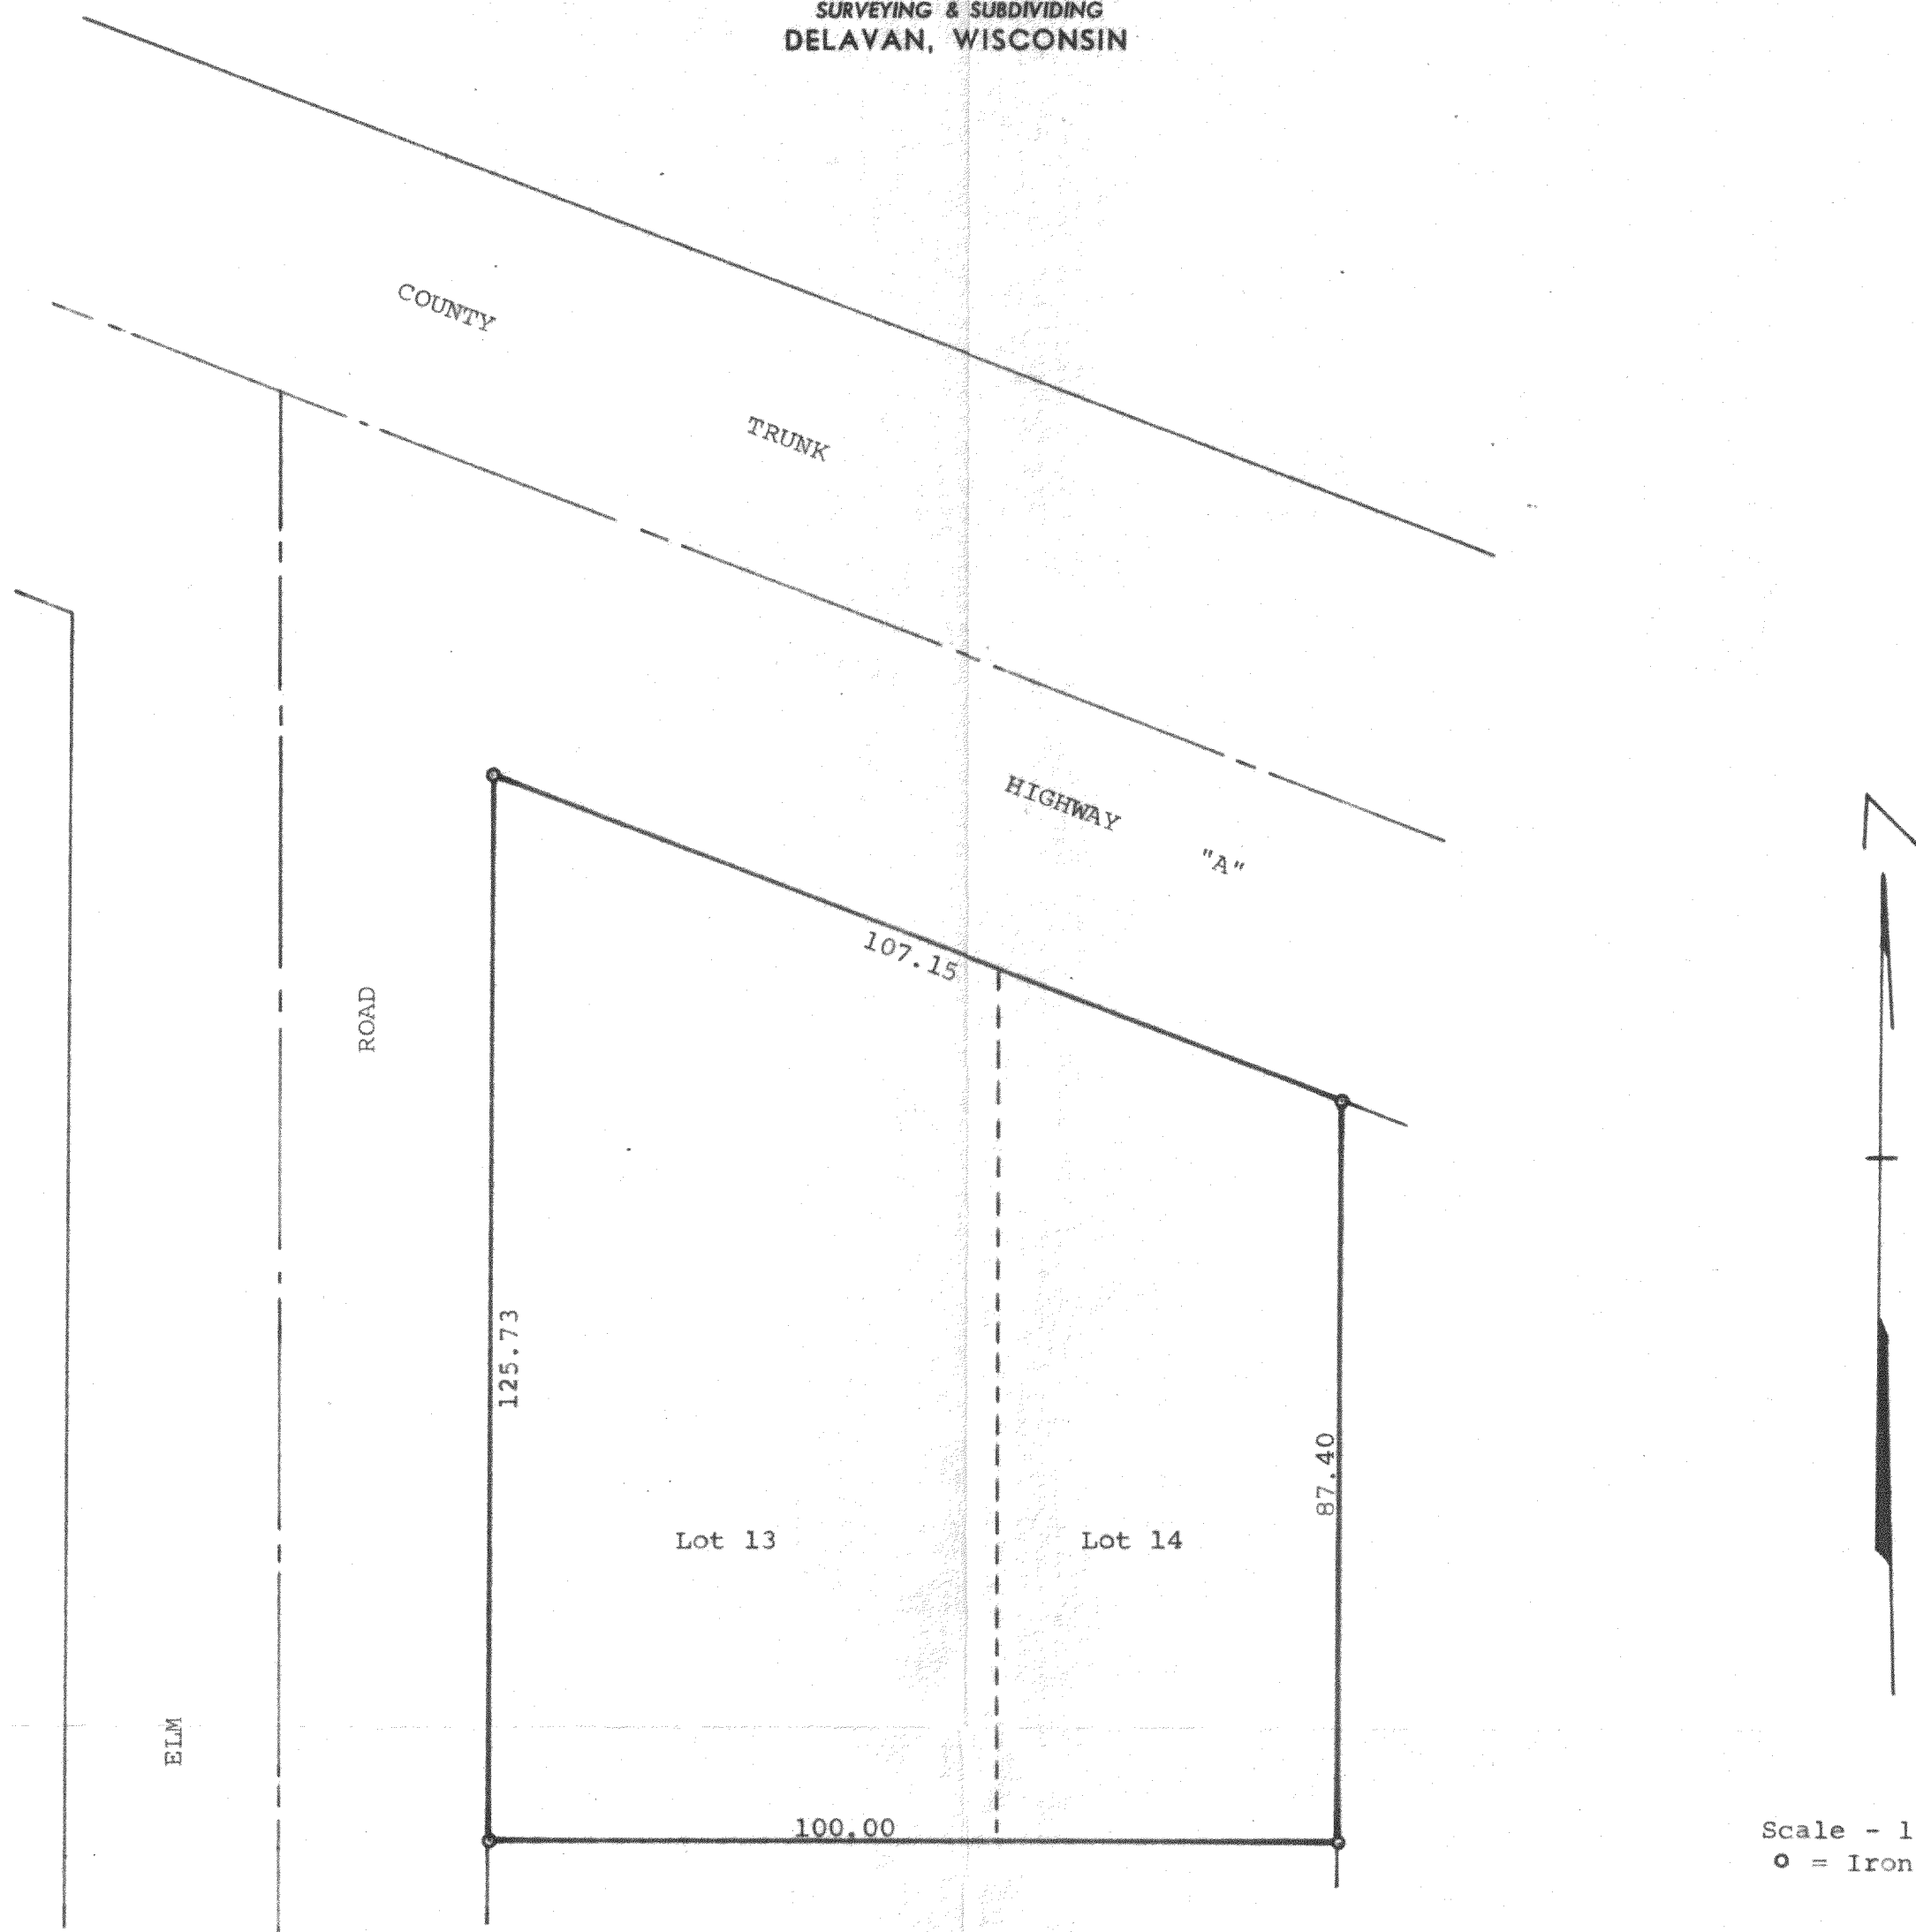

Plat of survey of Lots 13 and 14 in Block 6 of Interlaken,
a subdivision located in Section 11, T 3 N, R 16 E, Walworth
County, Wisconsin.
May 4, 1972

George T. Dunham
George T. Dunham, Surveyor

