

ABERNATHY and ASSOCIATES

Kenneth B. Abernathy Jr.

Wisconsin Registered Land Surveyor S-1594

Rt. 3, Box 273
Elkhorn, Wisconsin 53121
Phone: (414) 723-4260 (office)
(414) 723-7209 (FAX)



PLAT OF SURVEY

LOT 24 OF BLOCK 5 OF LAKE WANDAWEGA HIGHLANDS
FIRST ADDITION SUBDIVISION, LOCATED IN SECTIONS 11
AND 12, TOWN 3 NORTH, RANGE 16 EAST, WALWORTH
COUNTY, WISCONSIN.

OWNER: BOB HIBLER
N6825 AVATAIA TRAIL
ELKHORN, WI. 53121

STREET VACATION SEE VOL. 638 P. 4278
DOC. NO. 319760


ALSO KNOWN AS AVATAIA TRAIL
AKWENASA TRAIL 40' WIDE

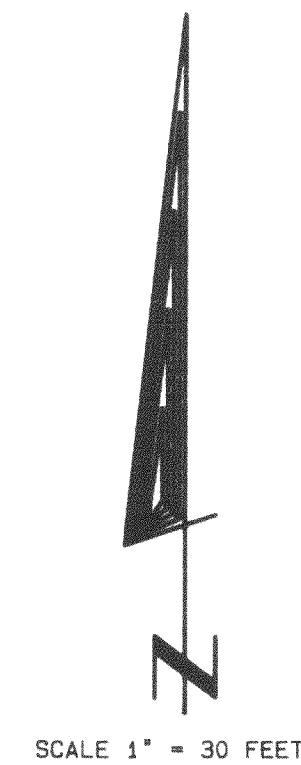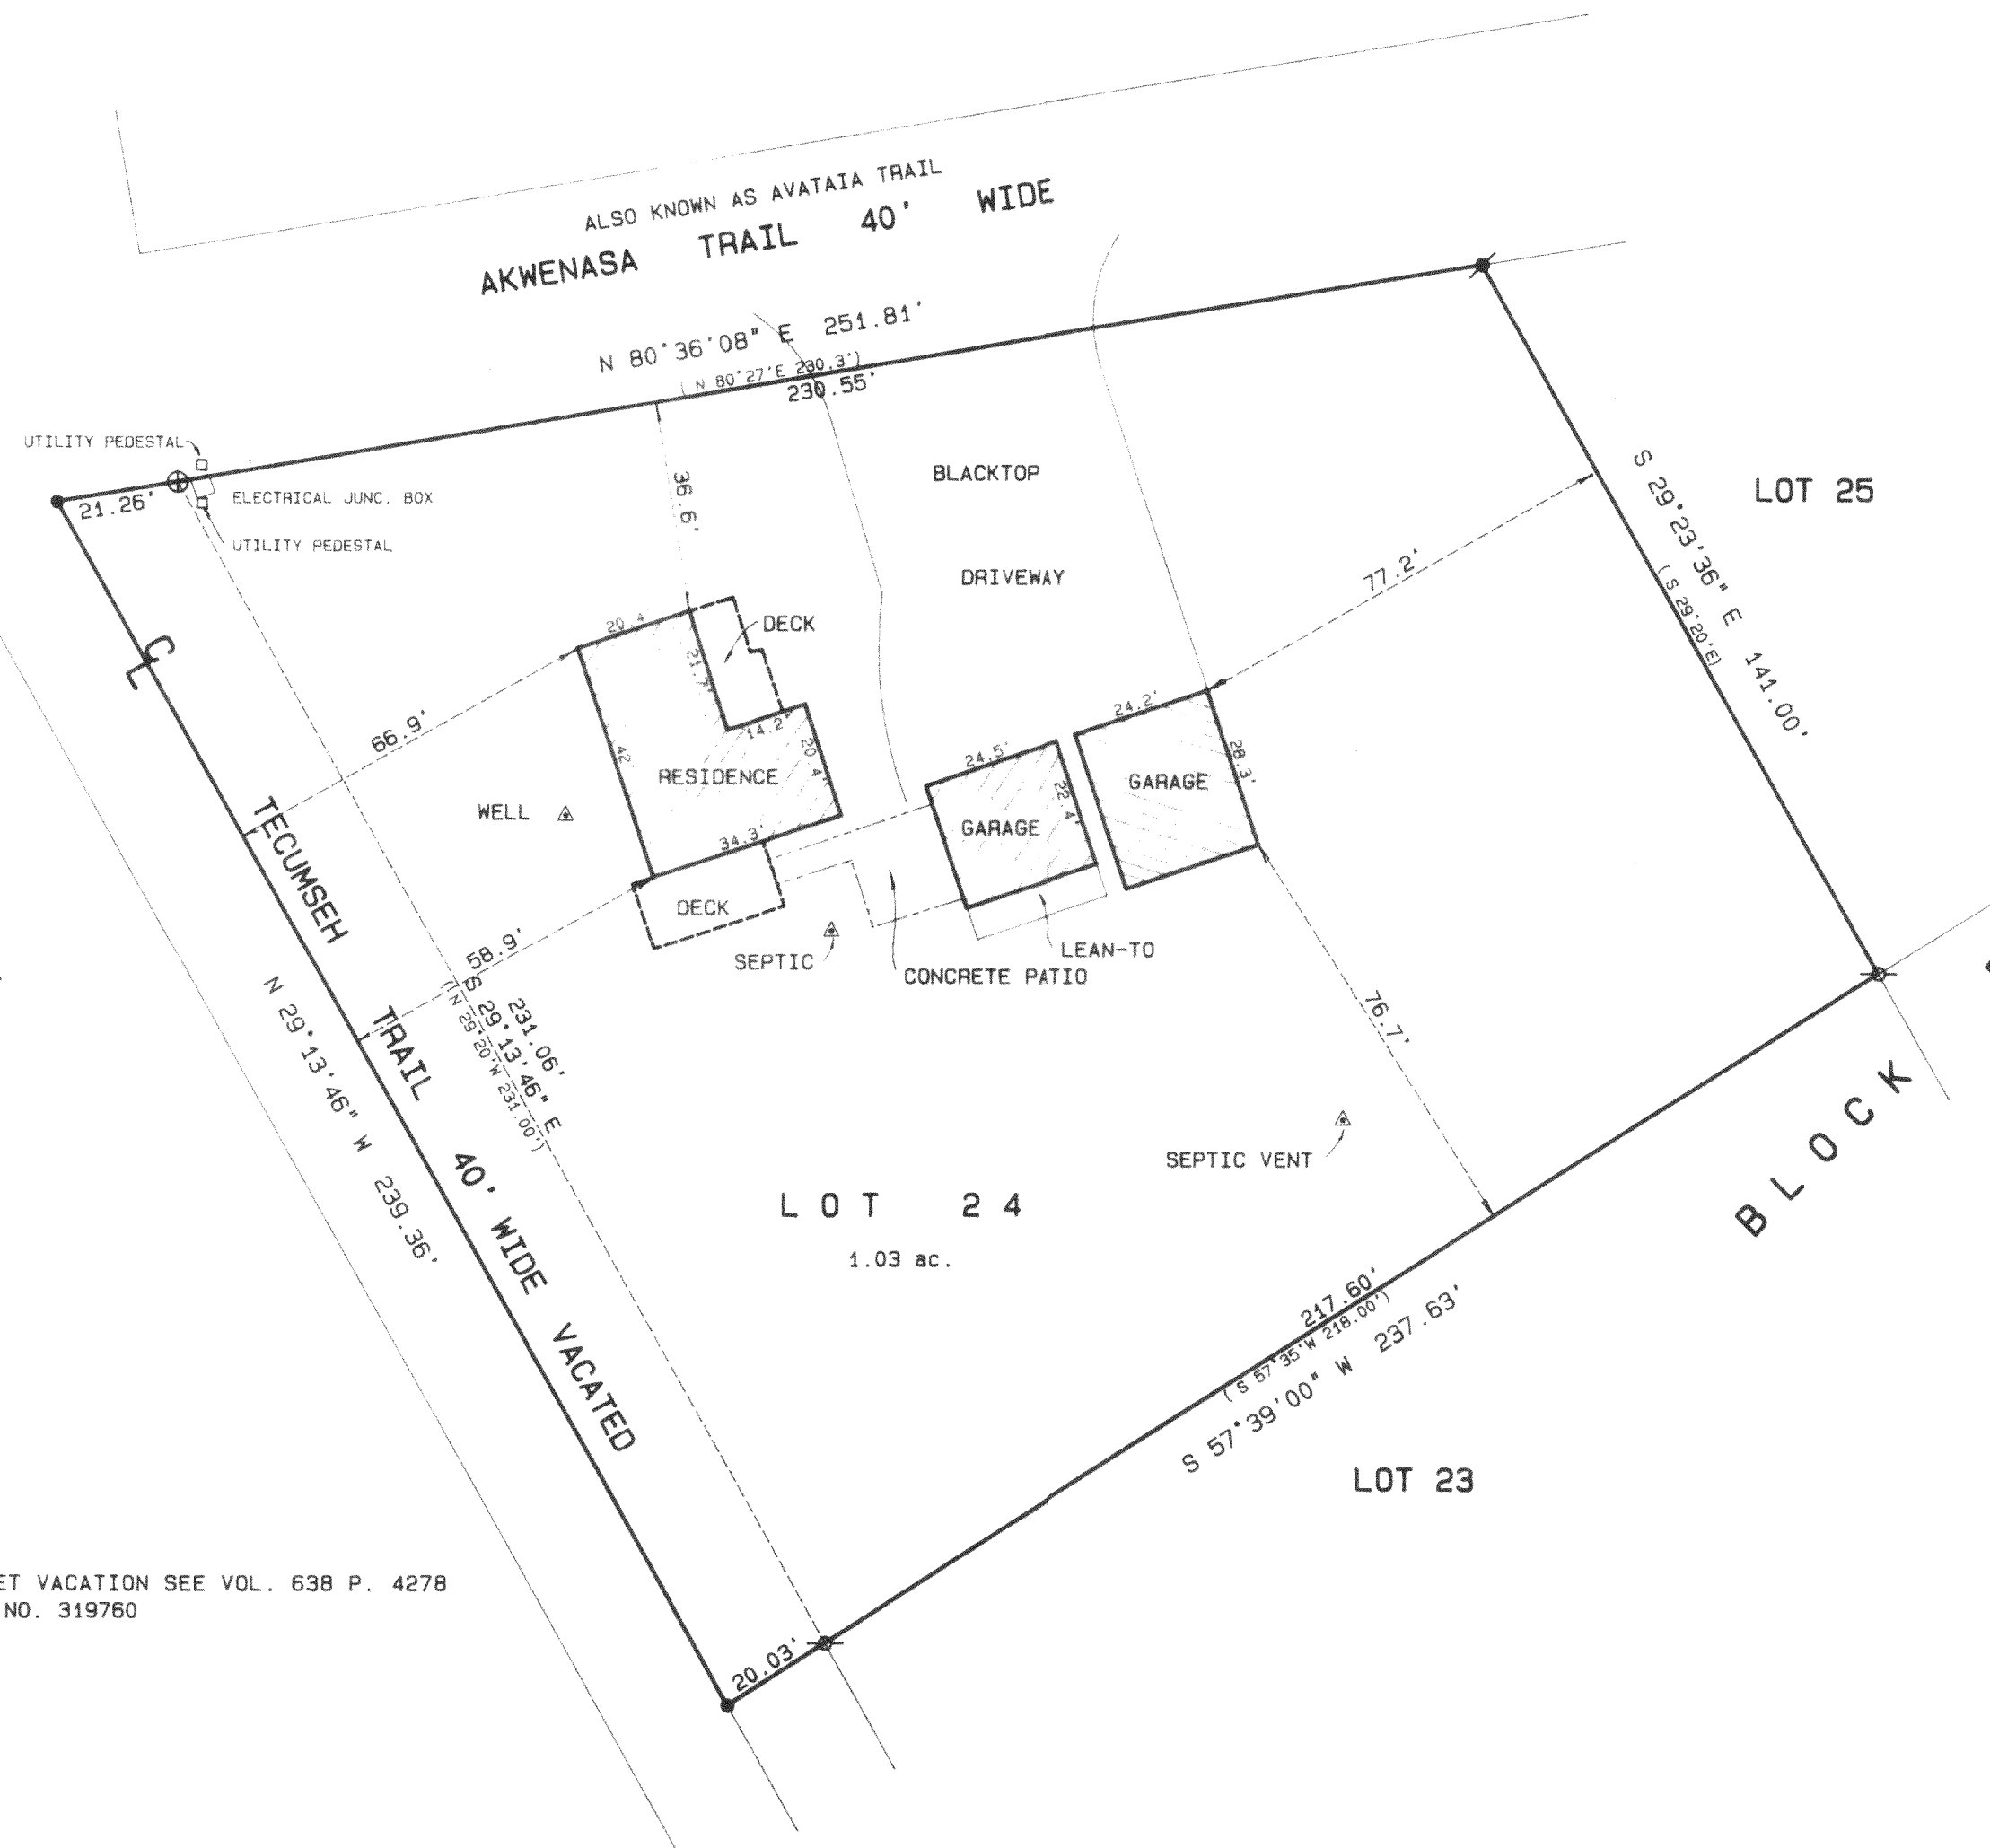

BEARINGS ARE REFERENCED TO SURVEYS OF
RECORD.

Legend

- FOUND IRON PIPE
- FOUND IRON ROD
- FOUND BRASS CAPPED MONUMENT
- FOUND CONCRETE MONUMENT
- + CHISEL CUT IN CONCRETE
- SET IRON ROD, 24" LONG, WEIGHING 1.5 LBS./LINEAL FT., 3/4" DIA.
- SET IRON ROD, 30" LONG, WEIGHING 4.5 LBS./LINEAL FT., 1-11/16" DIA.
- (xx) RECORDED AS DIMENSION
- - - - - EXISTING FENCE

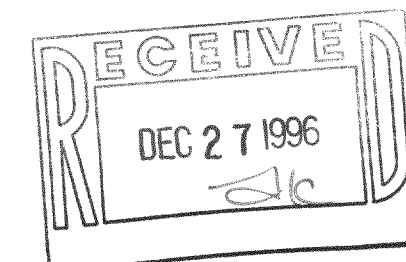

SCALE: 1" = 30 FEET

"I hereby certify that the above described property has been surveyed by me or under my direction and that the above map is a true representation thereof and shows the size and location of the property, its exterior boundaries, the location of all visible structures and dimensions of all principal buildings thereon, boundary fences, apparent easements, roadways and visible encroachments, if any."
"This survey is made for the use of the present owners of the property, and also those who purchase, mortgage, or guarantee the title thereto within one year from date hereof."



Kenneth B. Abernathy, Jr.
WISCONSIN REGISTERED LAND SURVEYOR,
S-1594

Date: DEC. 4, 1996 Job No. 96.1202

GWAH-95
316-888