




ORDERED BY: REALTY CENTER BETTER HOMES & GARDENS
32 S. WISCONSIN STREET
ELKHORN, WI 53121

PLAT OF SURVEY OF

LOT 8, CHARL-MAR SUBDIVISION, LOCATED IN
T3N, R16E, WALWORTH COUNTY, WISCONSIN.

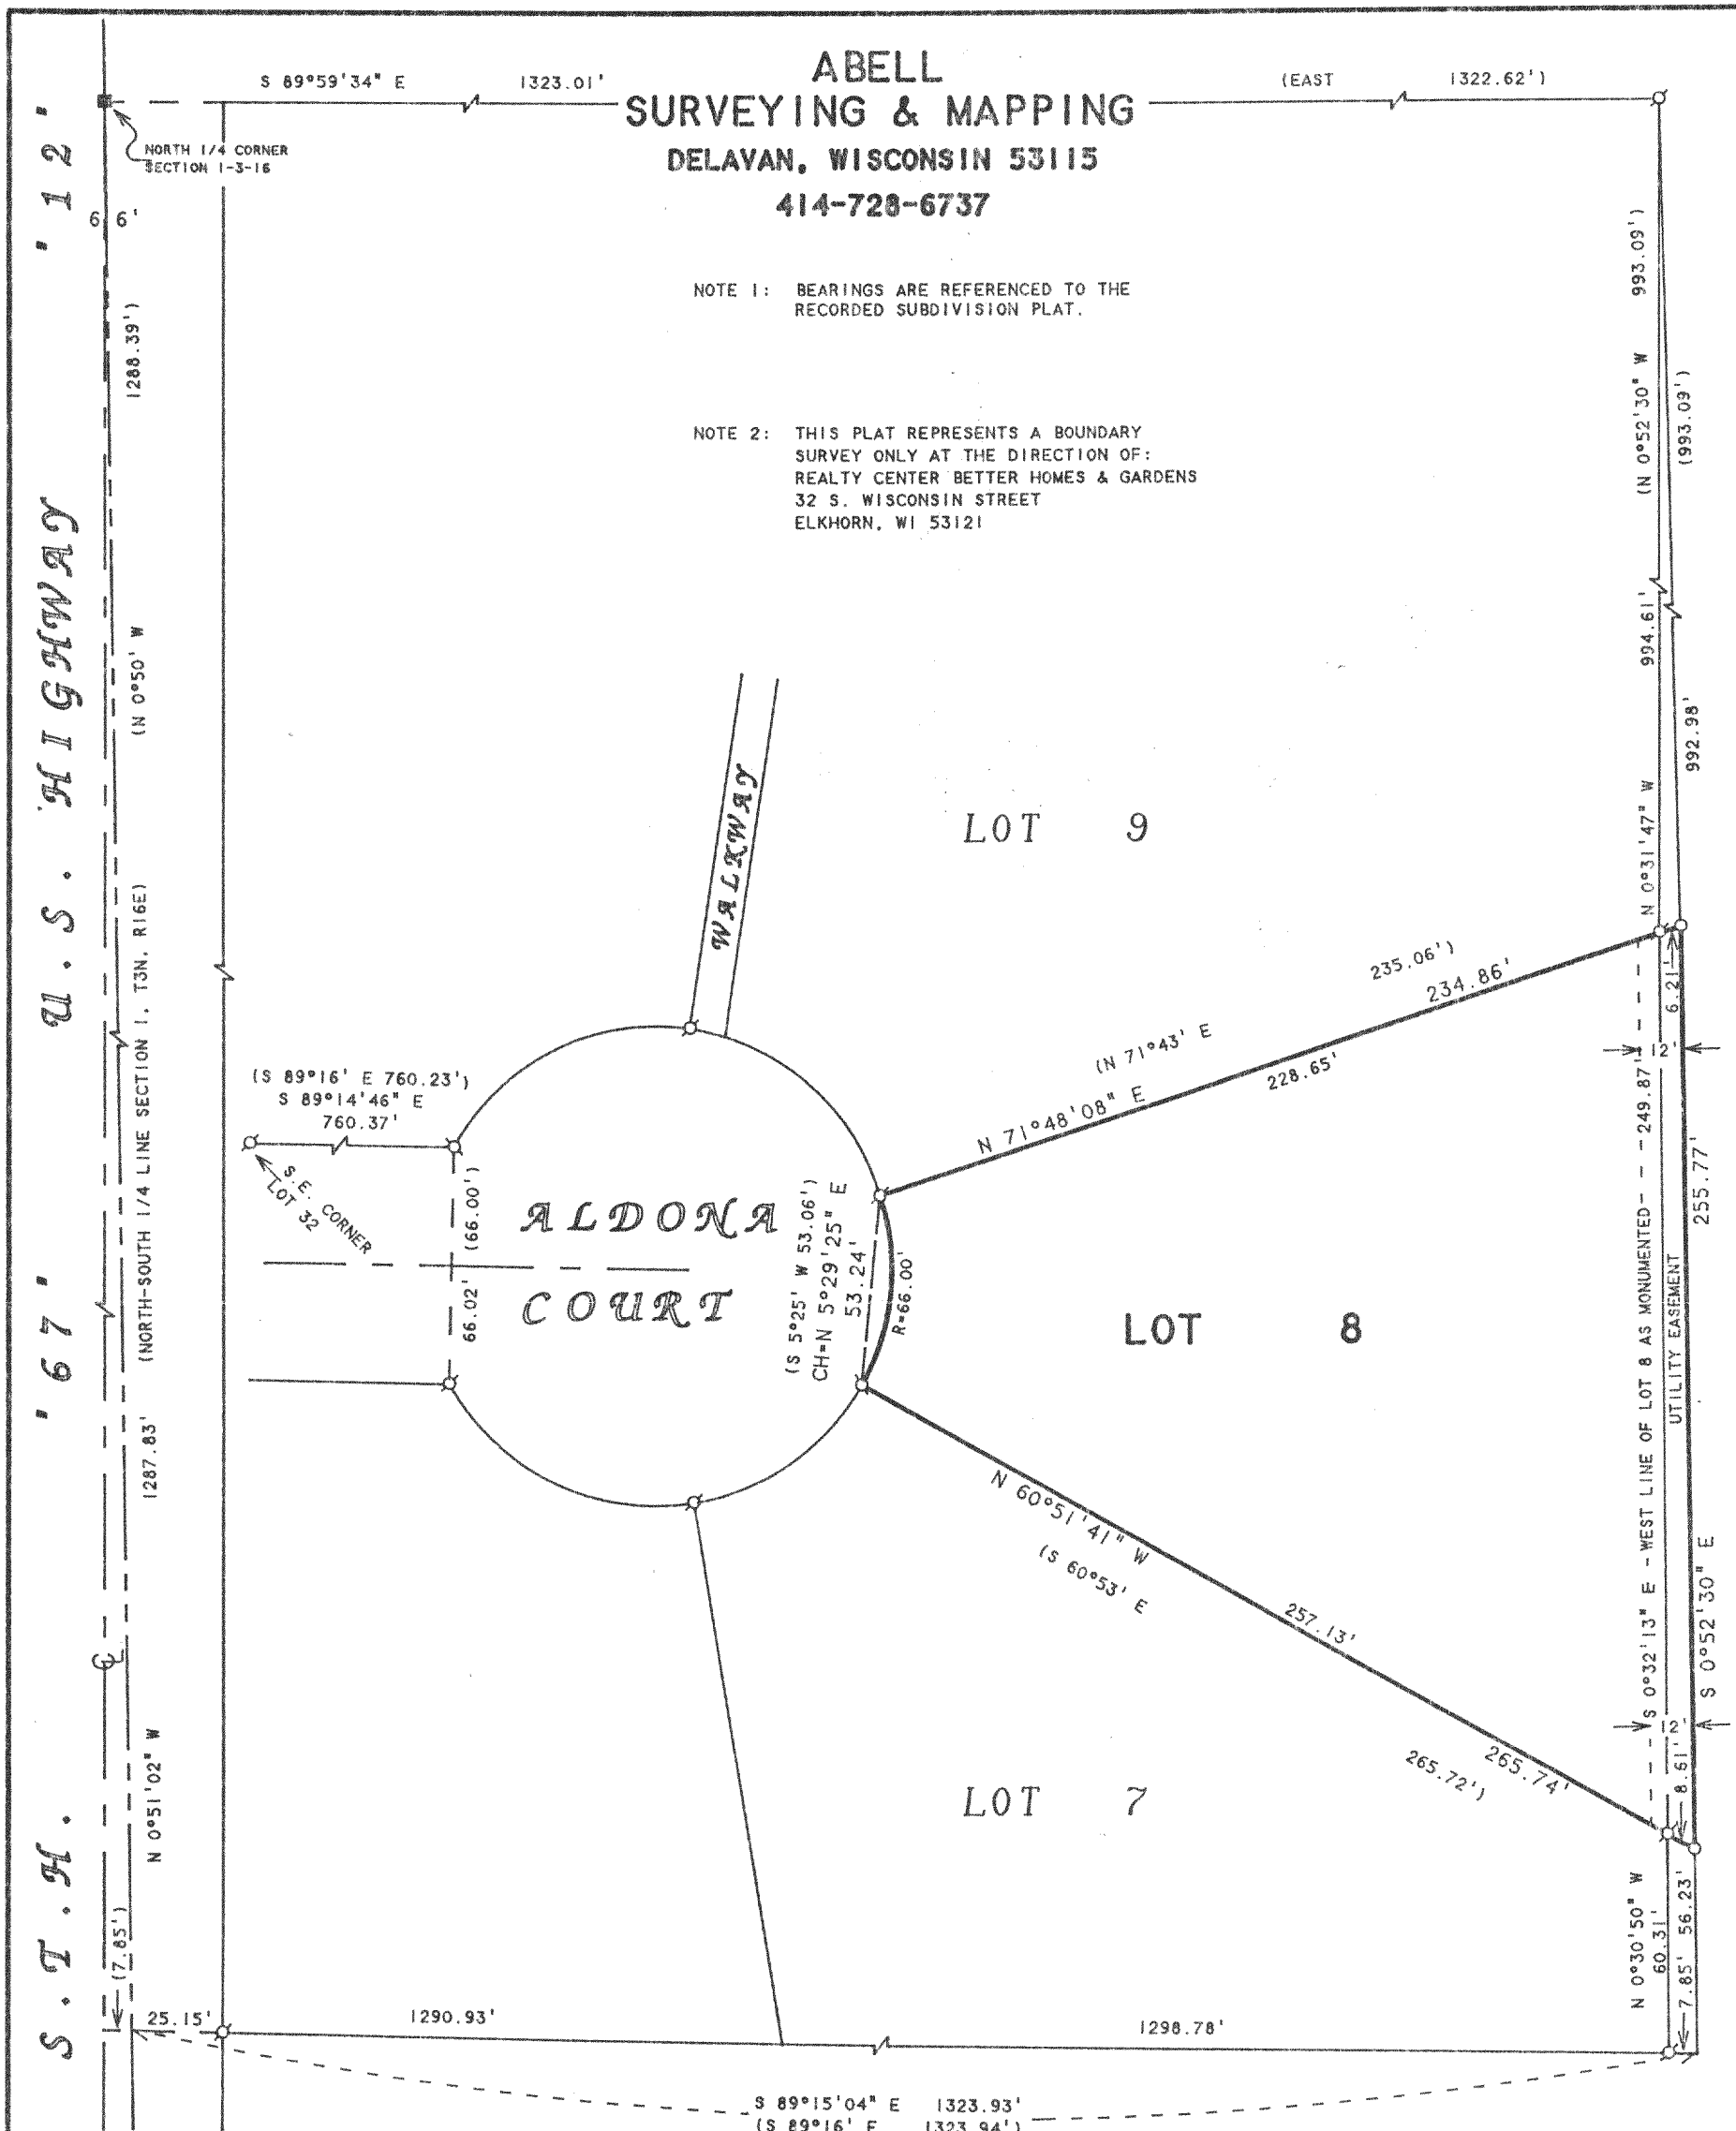

SCALE 1"=50'

LEGEND

- - IRON PIPE FOUND
- - CONCRETE MONUMENT FOUND
- - IRON PIPE SET
- () - RECORDED AS


I, DAVID F. ABELL, DO HEREBY CERTIFY THAT I HAVE SURVEYED THE PROPERTY HEREON DESCRIBED ACCORDING TO THE OFFICAL RECORDS AND THAT THE PLAT HEREON IS A CORRECT REPRESENTATION OF THE PROPERTY LINES TO THE BEST OF MY KNOWLEDGE AND BELIEF.

David F. Abell

DAVID F. ABELL
WISCONSIN REGISTERED LAND SURVEYOR, S-1596

October 14, 1996

DATE JOB NUMBER - 96186
NOTE: THIS IS NOT A CERTIFIED COPY UNLESS SEALED.

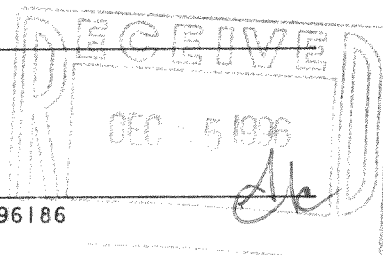

6CH-8
316-892