

FARRIS, HANSEN & ASSOCIATES, INC.

7 RIDGEWAY COURT, P.O. BOX 437
ELKHORN, WISCONSIN 53121

PLAT OF SURVEY

PHONE: (414) 723-2098
FAX: (414) 723-5888


LOCATION: LOT 4 OF C.S.M. # 639
REC. VOL. 3 PG. 116 DOC. # 12794
N. 1/2 SEC. 12, T. 3 N., R. 16 E.
WALWORTH COUNTY, WI.

WORK ORDERED BY: NORMAN BRUMMEL
RT 2, BOX 256
ELKHORN, WI.

MAP LEGEND

- - IRON PIPE STAKE FOUND
- - IRON PIPE STAKE SET
- - IRON ROD STAKE FOUND
- - IRON ROD STAKE SET
- - - CONCRETE MONUMENT FOUND
- - - RECORD DIMENSION

(XXXXX)

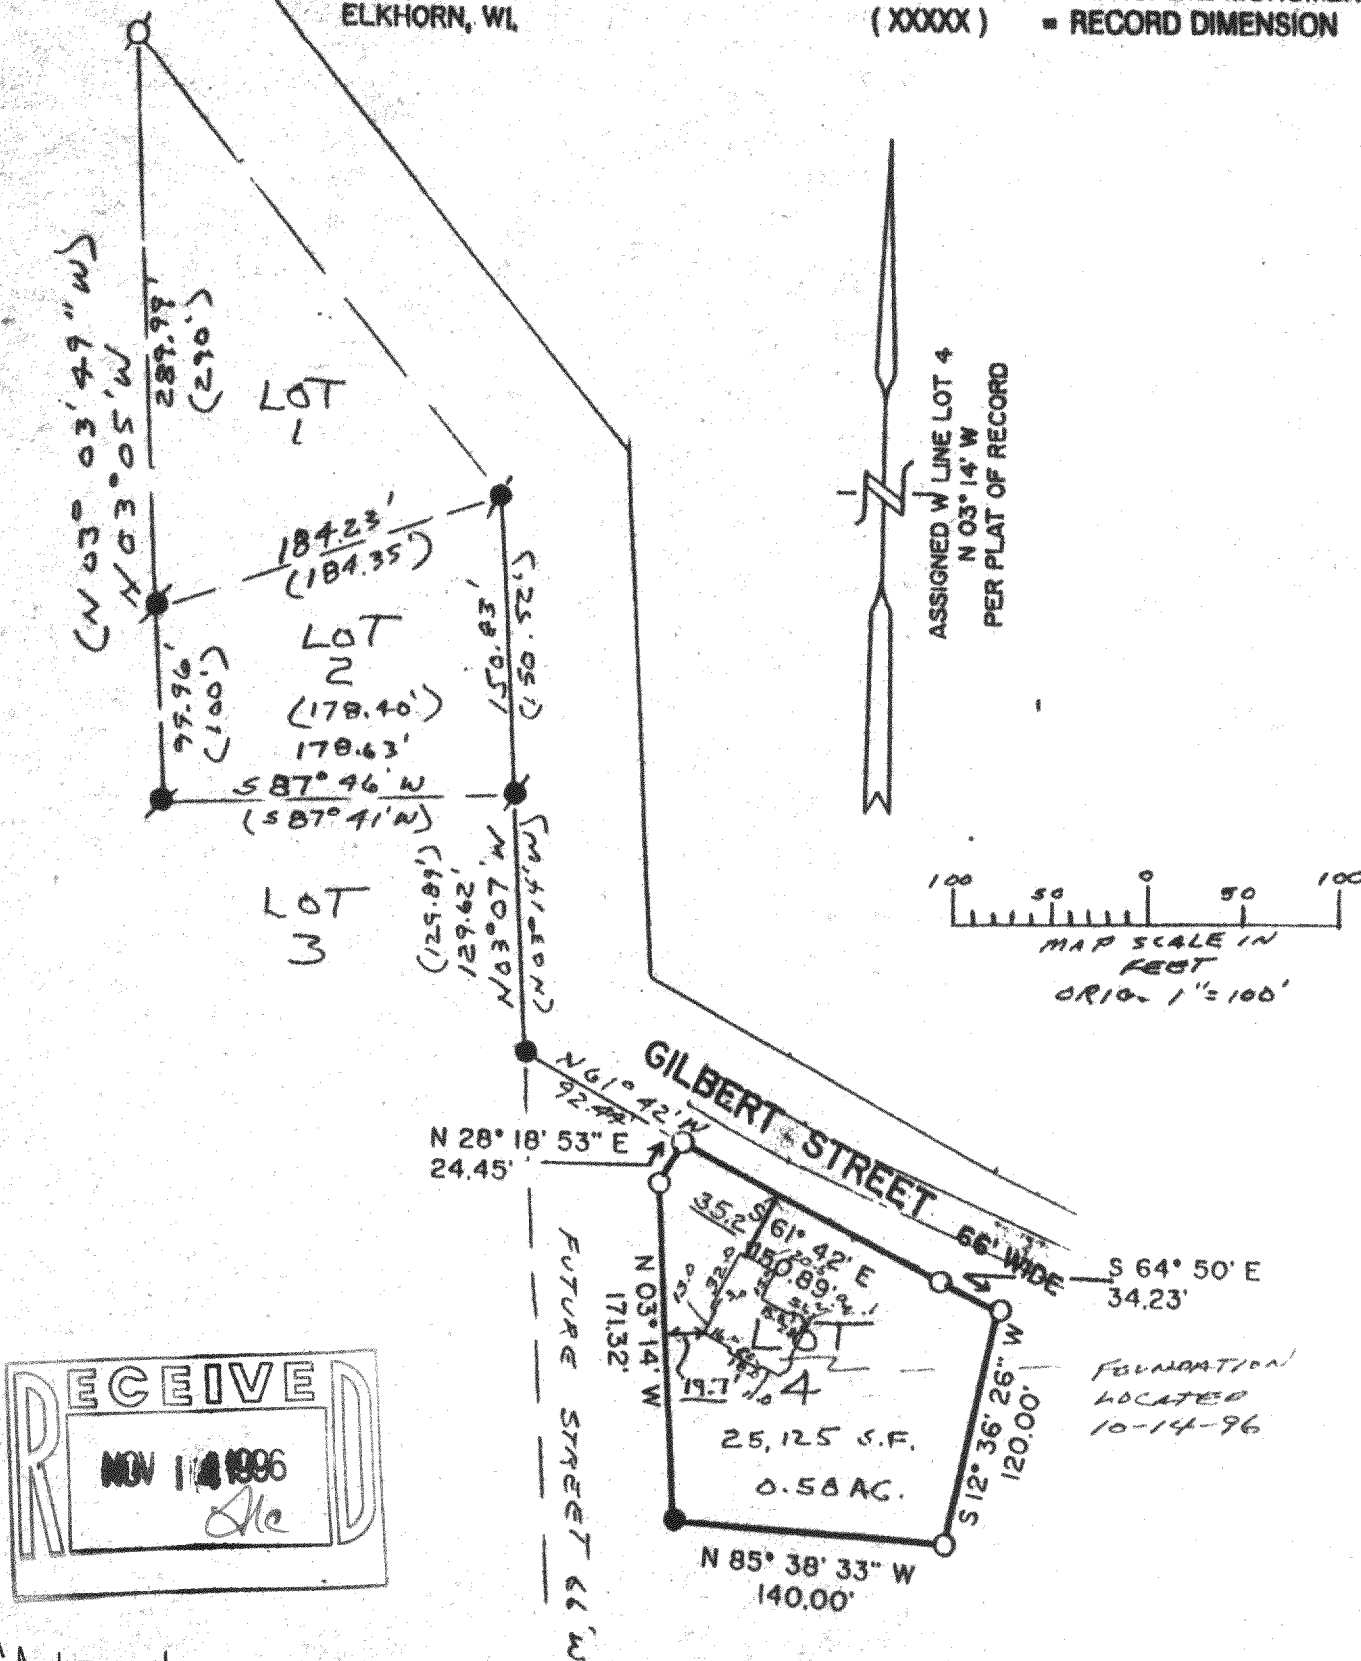

GA-639-4 316-896

NOTE: COPIES OF THIS MAP TO WHICH THE FOLLOWING CERTIFICATE WILL APPLY ARE BLUE LINE PRINTS SHOWING SURVEYOR'S ORIGINAL SEAL AND SIGNATURE IN BLACK INK. COPIES BY ANY OTHER MEANS MAY HAVE ALTERATIONS WHICH DO NOT REPRESENT THE SURVEYOR'S WORK PRODUCT.

I HEREBY CERTIFY THAT THIS PLAT OF SURVEY IS A TRUE AND ACCURATE REPRESENTATION OF THE BOUNDARY LINES OF THE SUBJECT PARCEL TO THE BEST OF MY KNOWLEDGE AND BELIEF. THIS SURVEY IS MADE FOR THE USE OF THE PRESENT OWNERS OF THE PROPERTY, AND ALSO THOSE WHO PURCHASE, MORTGAGE, OR GUARANTEE THE TITLE THERETO WITHIN ONE YEAR FROM THE DATE HEREOF.

DATED: 05/06/1993

PETER S. GORDON RLS 2101

PROJECT NO. 3827

REVISED 10/14/96
TO SHOW SIZE + LOCATION OF FOUNDATION AS BUILT

