

ABERNATHY and ASSOCIATES

Kenneth B. Abernathy Jr.

Wisconsin Registered Land Surveyor S-1594


Rt. 3, Box 273
Elkhorn, Wisconsin 53121
Phone: (414) 723-4260 (office)
(414) 723-7209 (FAX)

PLAT OF SURVEY

LOTS 14 - 19 AND LOTS 35 - 36 OF BLOCK
"E" OF NORTH LAKE BEACH TRACT NO. 1,
LOCATED IN SECTION 5, TOWN 3 NORTH, RANGE
16 EAST, TOWN OF SUGAR CREEK, WALWORTH
COUNTY, WISCONSIN.

ORDERED BY: SHARPE BUILDERS

OWNER: THOMAS F. KELLY
C/O ST. ANTHONY'S CHURCH
2525 SKYWAY RD.
BARTONVILLE, IL. 61607

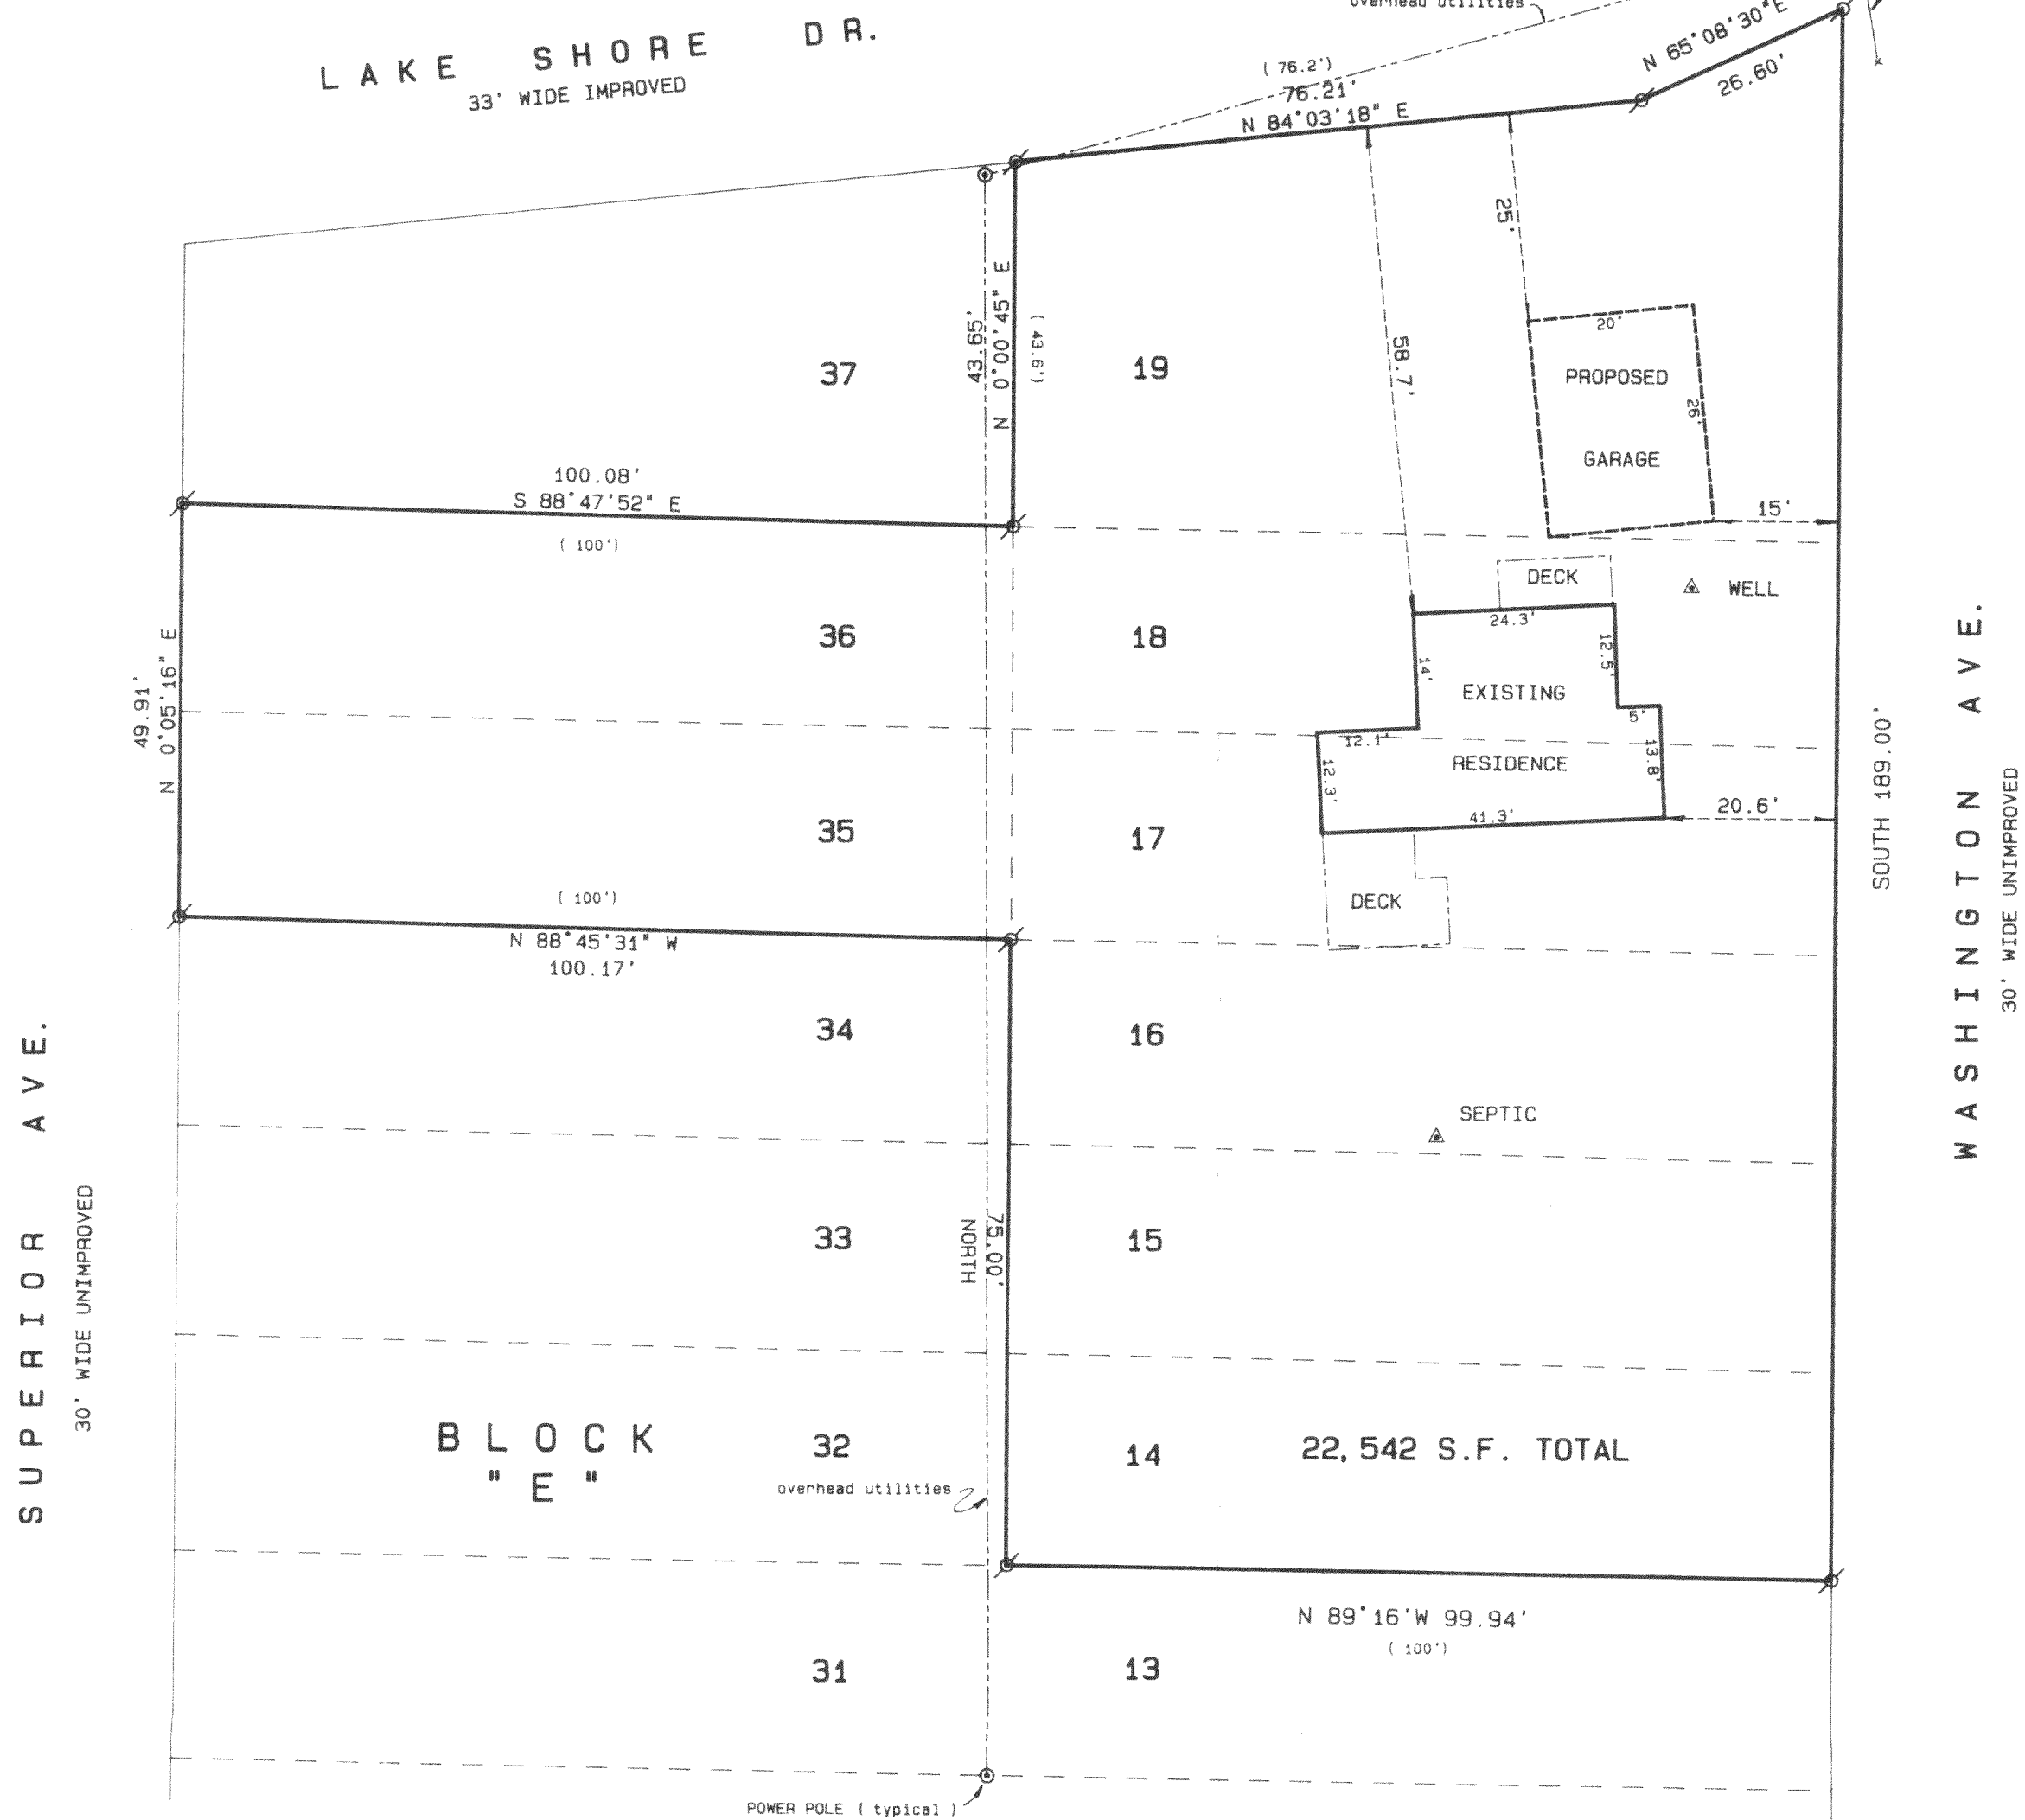


SCALE 1" = 20 FEET

THE EAST LINE OF BLOCK
"E" WAS ASSUMED TO BEAR
NORTH.


THIS SURVEY RETRACES A
PREVIOUS SURVEY BY GEO.
DUNHAM DATED JULY 27,
1979.

Legend

- FOUND IRON PIPE
- FOUND IRON ROD
- FOUND BRASS CAPPED MONUMENT
- FOUND CONCRETE MONUMENT
- CHISEL CUT IN CONCRETE
- SET IRON ROD, 24" LONG, WEIGHING
1.5 LBS., LINEAL FT., 3/4" DIA.
- SET IRON ROD, 30" LONG, WEIGHING
4.5 LBS., LINEAL FT., 1-11/16" DIA.
- (XX) RECORDED AS DIMENSION
- EXISTING FENCE

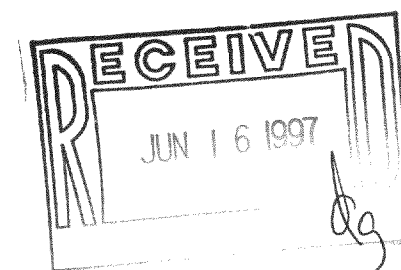

SCALE: 1" = 20 FEET

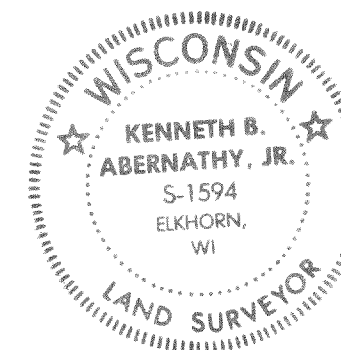

"I hereby certify that the above described property has been surveyed
by me or under my direction and that the above map is a true
representation thereof and shows the size and location of the property, its
exterior boundaries, the location of all visible structures and dimensions of
all principal buildings thereon, boundary fences, apparent easements,
highways and visible encroachments, if any."
"This survey is made for the use of the present owners of the property,
and also those who purchase, mortgage, or guarantee the title thereto within
one year from date hereof."

KENNETH B. ABERNATHY, JR.
WISCONSIN REGISTERED LAND SURVEYOR,
S-1594

Date: MAY 13, 1997 Job No. 97423

GNLB-60
GNLB-67
316-928