


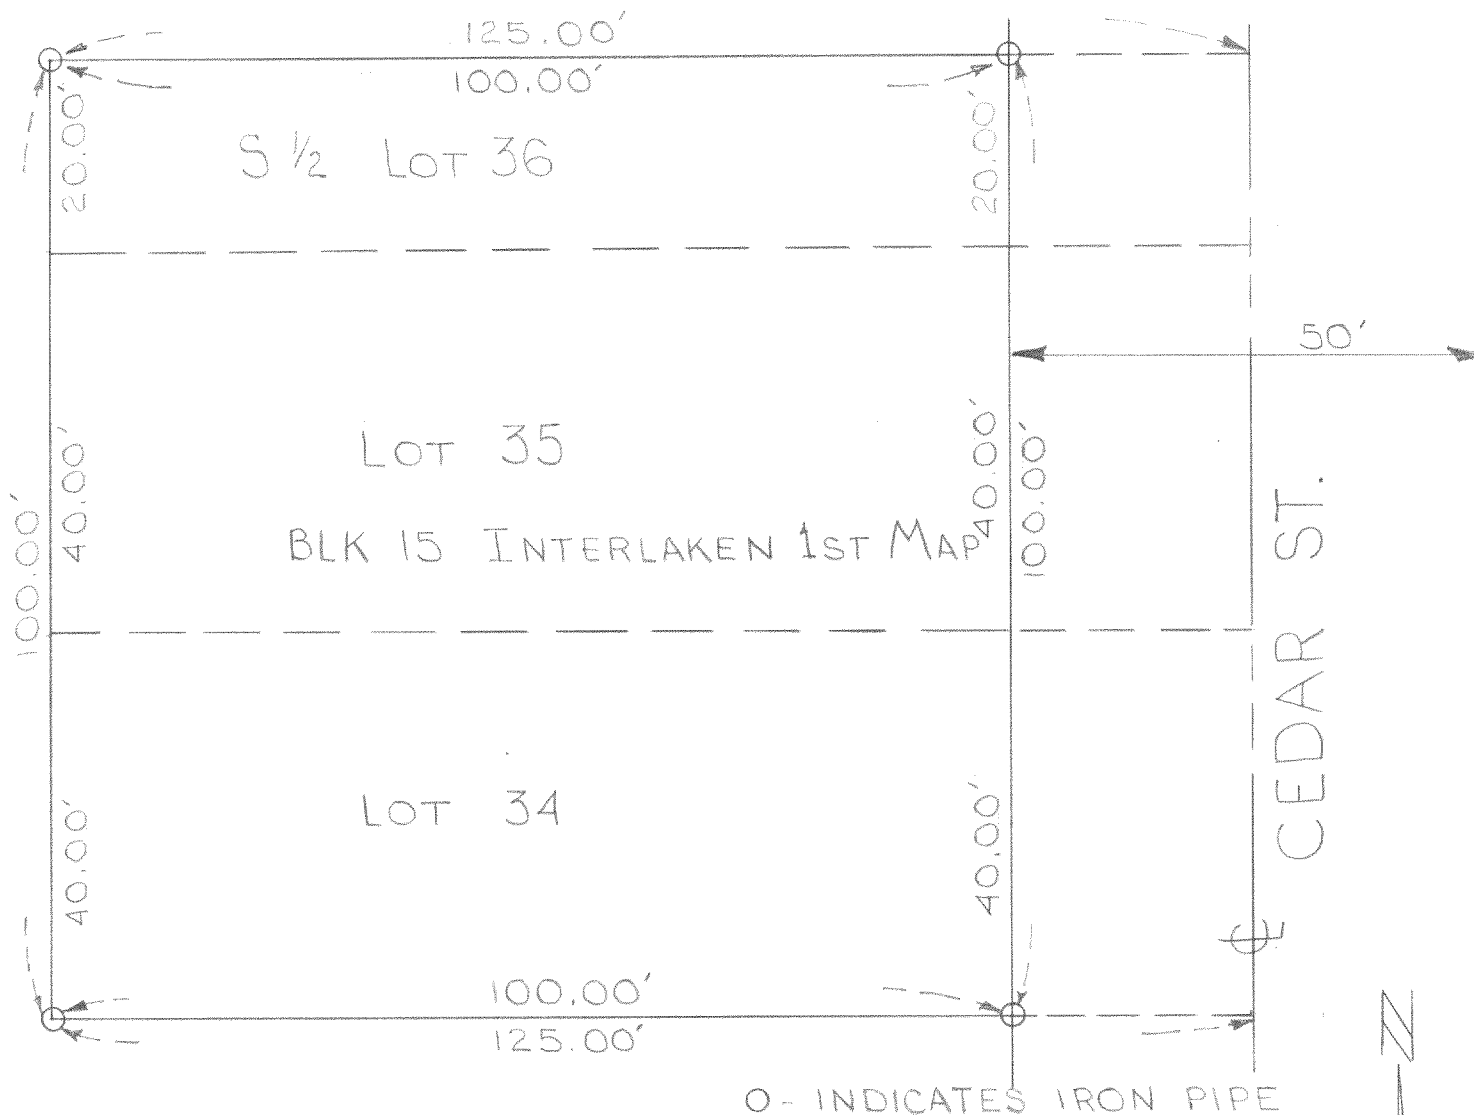

DESCRIPTION: Lots 34, 35, and the south 1/2 of 36, block 15, Interlaken Plat, 1st. Map.

CERTIFICATE: I, James F. Biagi, surveyor, do hereby certify that I have surveyed the lands hereon described.

May 5, 1970

*James F. Biagi*

James F. Biagi R.L.S. 272

