


HAROLD H. KOLB

REGISTERED PROFESSIONAL LAND SURVEYOR
LAKE GENEVA, WISCONSIN

ALDONA COURT
66' WIDE

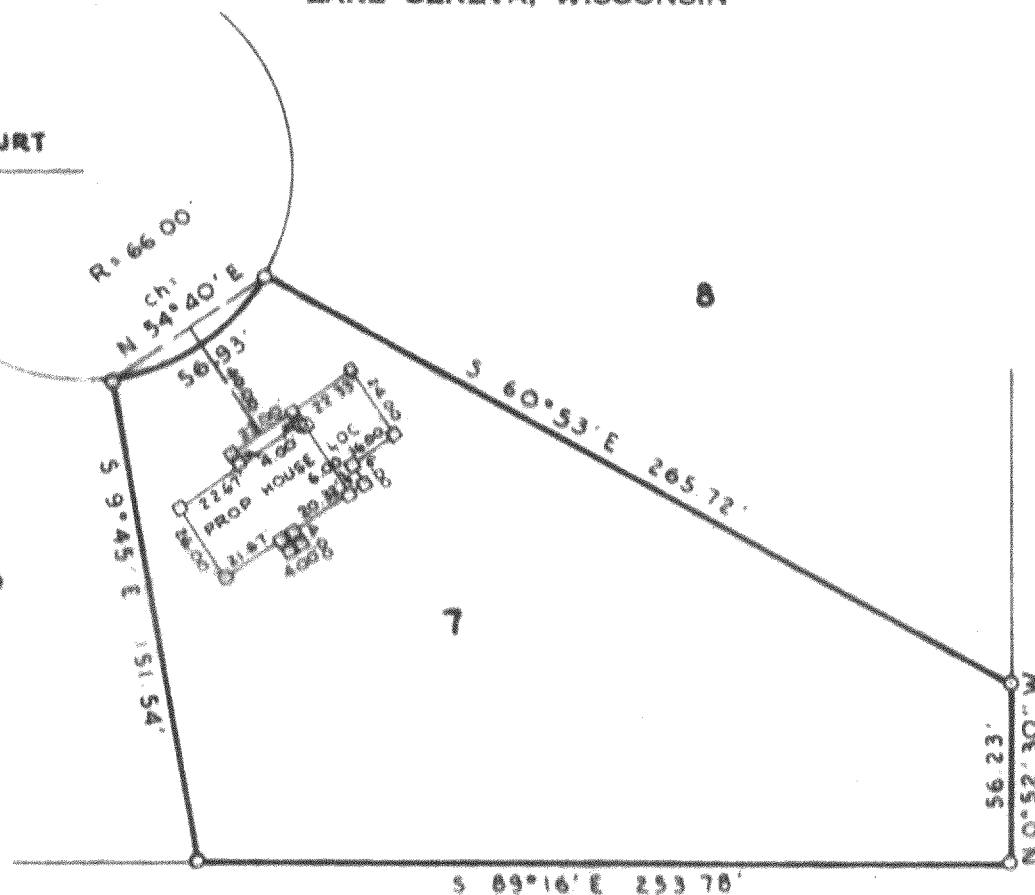

PLAT OF

Lot 7, Charle-Mar Subdivision, located
in the Northwest $\frac{1}{4}$ of the Northeast $\frac{1}{4}$
of Section 1, T 3 N, R 16 E, Walworth
County, Wisconsin.


N



SCALE: 1"=60'

LEGEND

- ⊕ — IRON PIPE FOUND
- — IRON PIPE PLACED
- — CONCRETE MONUMENT
- x — SPIKE
- — Wooden Stakes

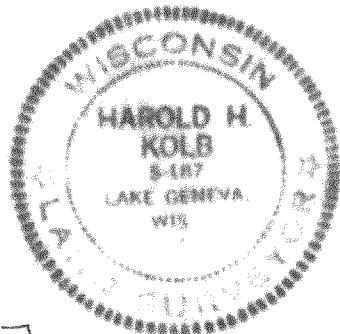

I, HAROLD H. KOLB, DO HEREBY CERTIFY THAT I HAVE
SURVEYED THE PROPERTY HEREON DESCRIBED ACCORDING
TO THE OFFICIAL RECORDS, AND THAT THE PLAT HEREON
IS A CORRECT REPRESENTATION OF THE LOT LINES.

Harold H. Kolb

HAROLD H. KOLB
WISCONSIN REGISTERED LAND SURVEYOR, S-187
DATE April 17, 1973

GCH-7

316-96