



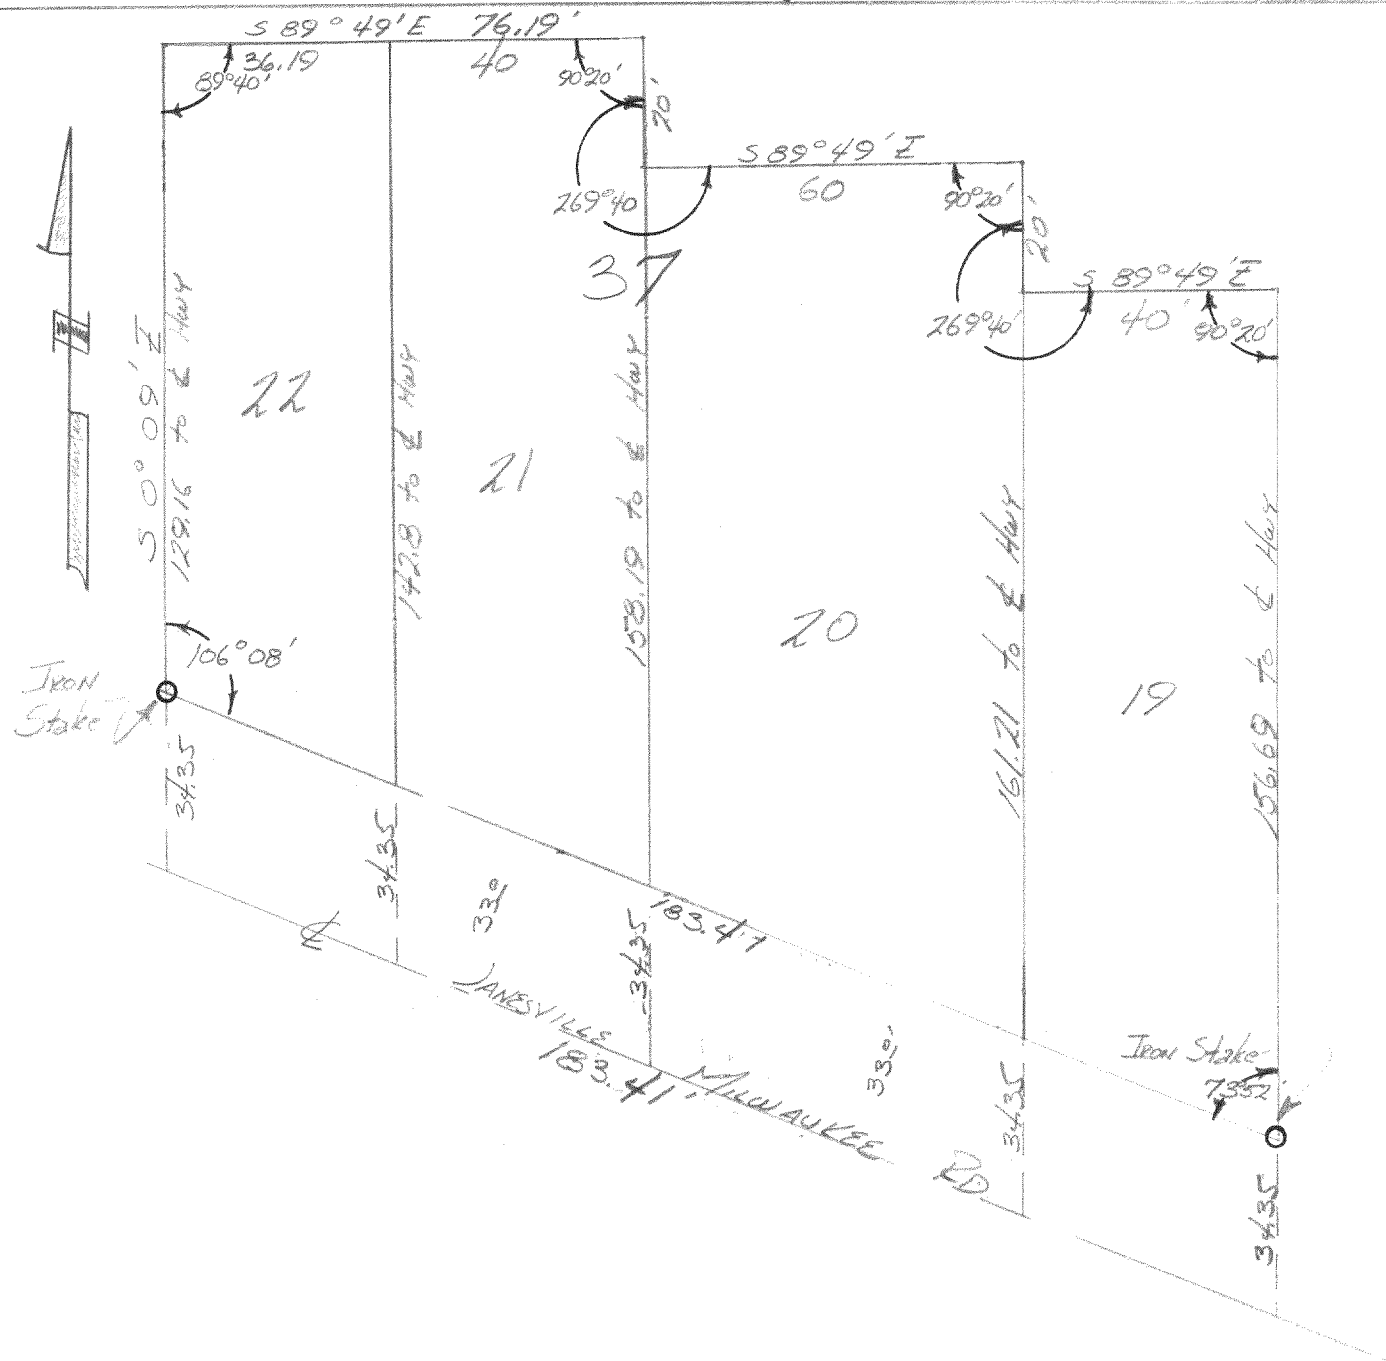

DESCRIPTION: Lots 19, 20, 21, and 22, of Block 37 Inter-laken Subdivision Third Addition, Town of Sugar Creek, Walworth County, Wisconsin.

CERTIFICATE: I hereby certify, that I have on this the 23rd day of September 1958, surveyed the above described property, and that I have set iron stakes in the field at the places hereon shown, and that no encroachments exist.

SIGNED AND SEALED THIS 25TH DAY OF SEPTEMBER 1958

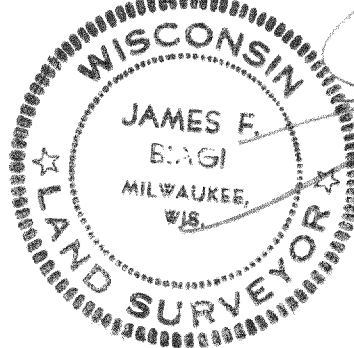

James F. Biagi
Land Surveyor (272)