

OWNER: LEANNE AND VITO CALI
RT. 1 LOST NATION RD.
ELKHORN, WI. 53121

SC-31-10

CENTER OF SECTION
31-3-16

SCALE 1" = 50 FEET

THE EAST LINE OF THE SOUTHWEST
1/4 OF SECTION 31-3-16 WAS
ASSUMED TO BEAR NORTH TO MATCH A
PREVIOUS SURVEY OF RECORD.

BENCHMARK = TOP OF CONCRETE
MONUMENT ELEV. = 938.03'

SOUTH 1/4 CORNER
SEC. 3-3-16

NORTH 1/4 CORNER
SEC. 6-2-16

-CENTERLINE AS TRAVELED FOR
DAM ROAD 66' WIDE

EXISTING PAVEMENT
21' WIDE


TKI# D - 6 - 9

OWNER: DAVID A. DUSTERBECK
2.71 AC.

TKI# D - 6 - 9 A

OWNER: VITO AND LEANNE CALI

PROPERTY OWNED BY VITO CALI

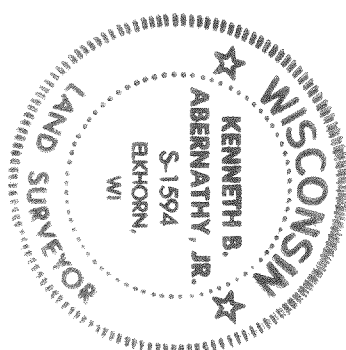

I hereby certify that the above copy is a true and correct copy of the original as the same appears in the records of the Wisconsin State Board of Health, as recorded thereon and as shown by the date and location of the property as recorded thereon. The location of all water, sewage, storm water, and other discharges, and the location of all buildings, structures, and other improvements, is as shown by the location of the property as recorded thereon. The location of all buildings, structures, and other improvements, is as shown by the location of the property as recorded thereon. The location of all buildings, structures, and other improvements, is as shown by the location of the property as recorded thereon.

Kenneth B. Abernathy, Jr.
 Wisconsin Registered Land Surveyor
 5-11504

Date: 12-31-97 Job No. 93-501

RECEIVED
JAN 12 1998

SCALE: 1" = 50 FEET

Legend

	FOUND IRON PIPE
	FOUND IRON ROD
	FOUND BRASS CAPED MONUMENT
	FOUND CONCRETE MONUMENT
	CHISEL CUT IN CONCRETE
	SET IRON ROD, 2X LONG, WEIGHING 1.5 LBS
	SET IRON ROD, 10' LONG, WEIGHING 4.5 LBS
	LIVE OAK TREE
	EXISTING FENCE