



0 - INDICATES IRON PIPE

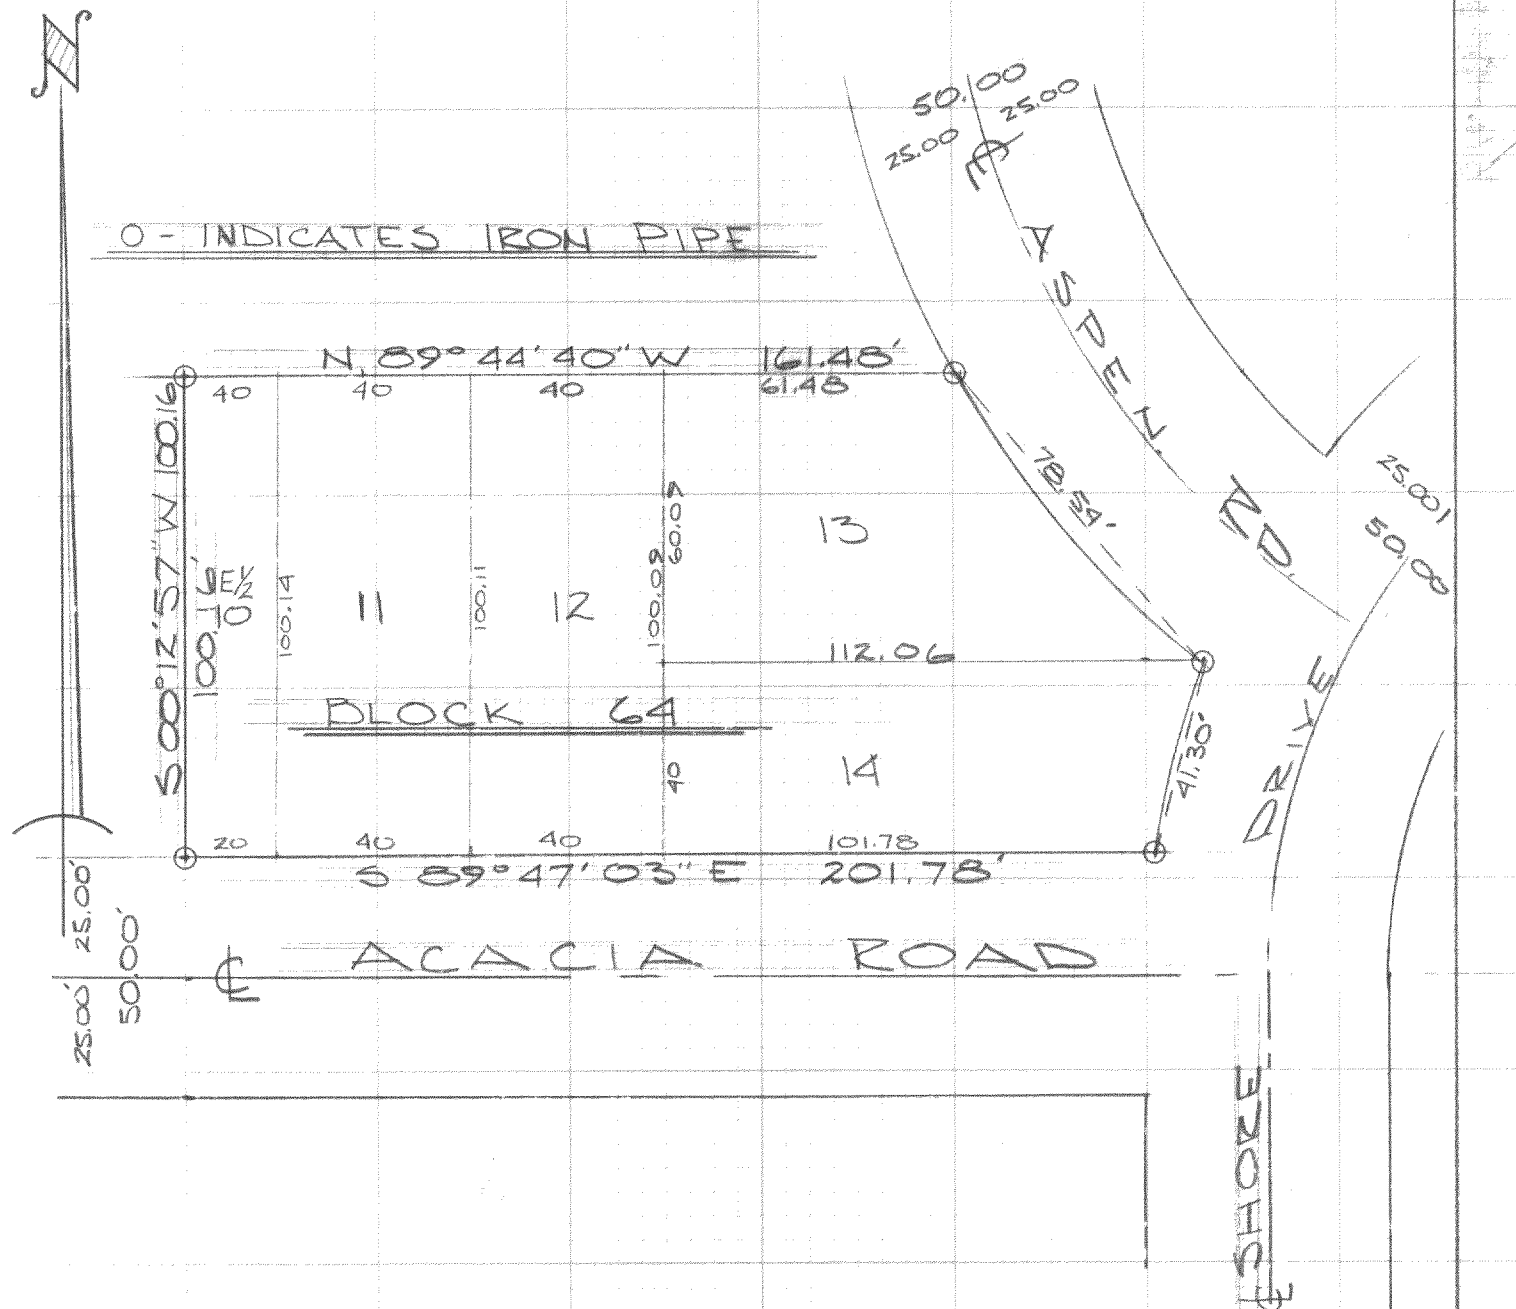

DESCRIPTION: The East $\frac{1}{2}$ of Lot 10, Lots 11, 12, 13, and 14 of Block 64 in the 5th. Map of Interlaken Subdivision, located in the NW $\frac{1}{4}$ of Section 14, T. 3 N., R. 16 E., Walworth County, Wisconsin.

CERTIFICATE: I, James F. Biagi, surveyor, do hereby certify that I have surveyed the property hereon described.

Jan. 30, 1968.

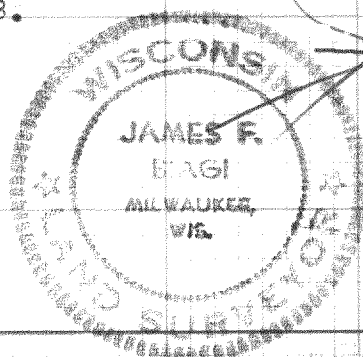

James F. Biagi, R.L.S. 272