


A7 W5120 HAWKHUNTER RD., ELKHORN, WIS. 53121

TAX # GBEC 00011

N 89° 19' 28" W 163.67

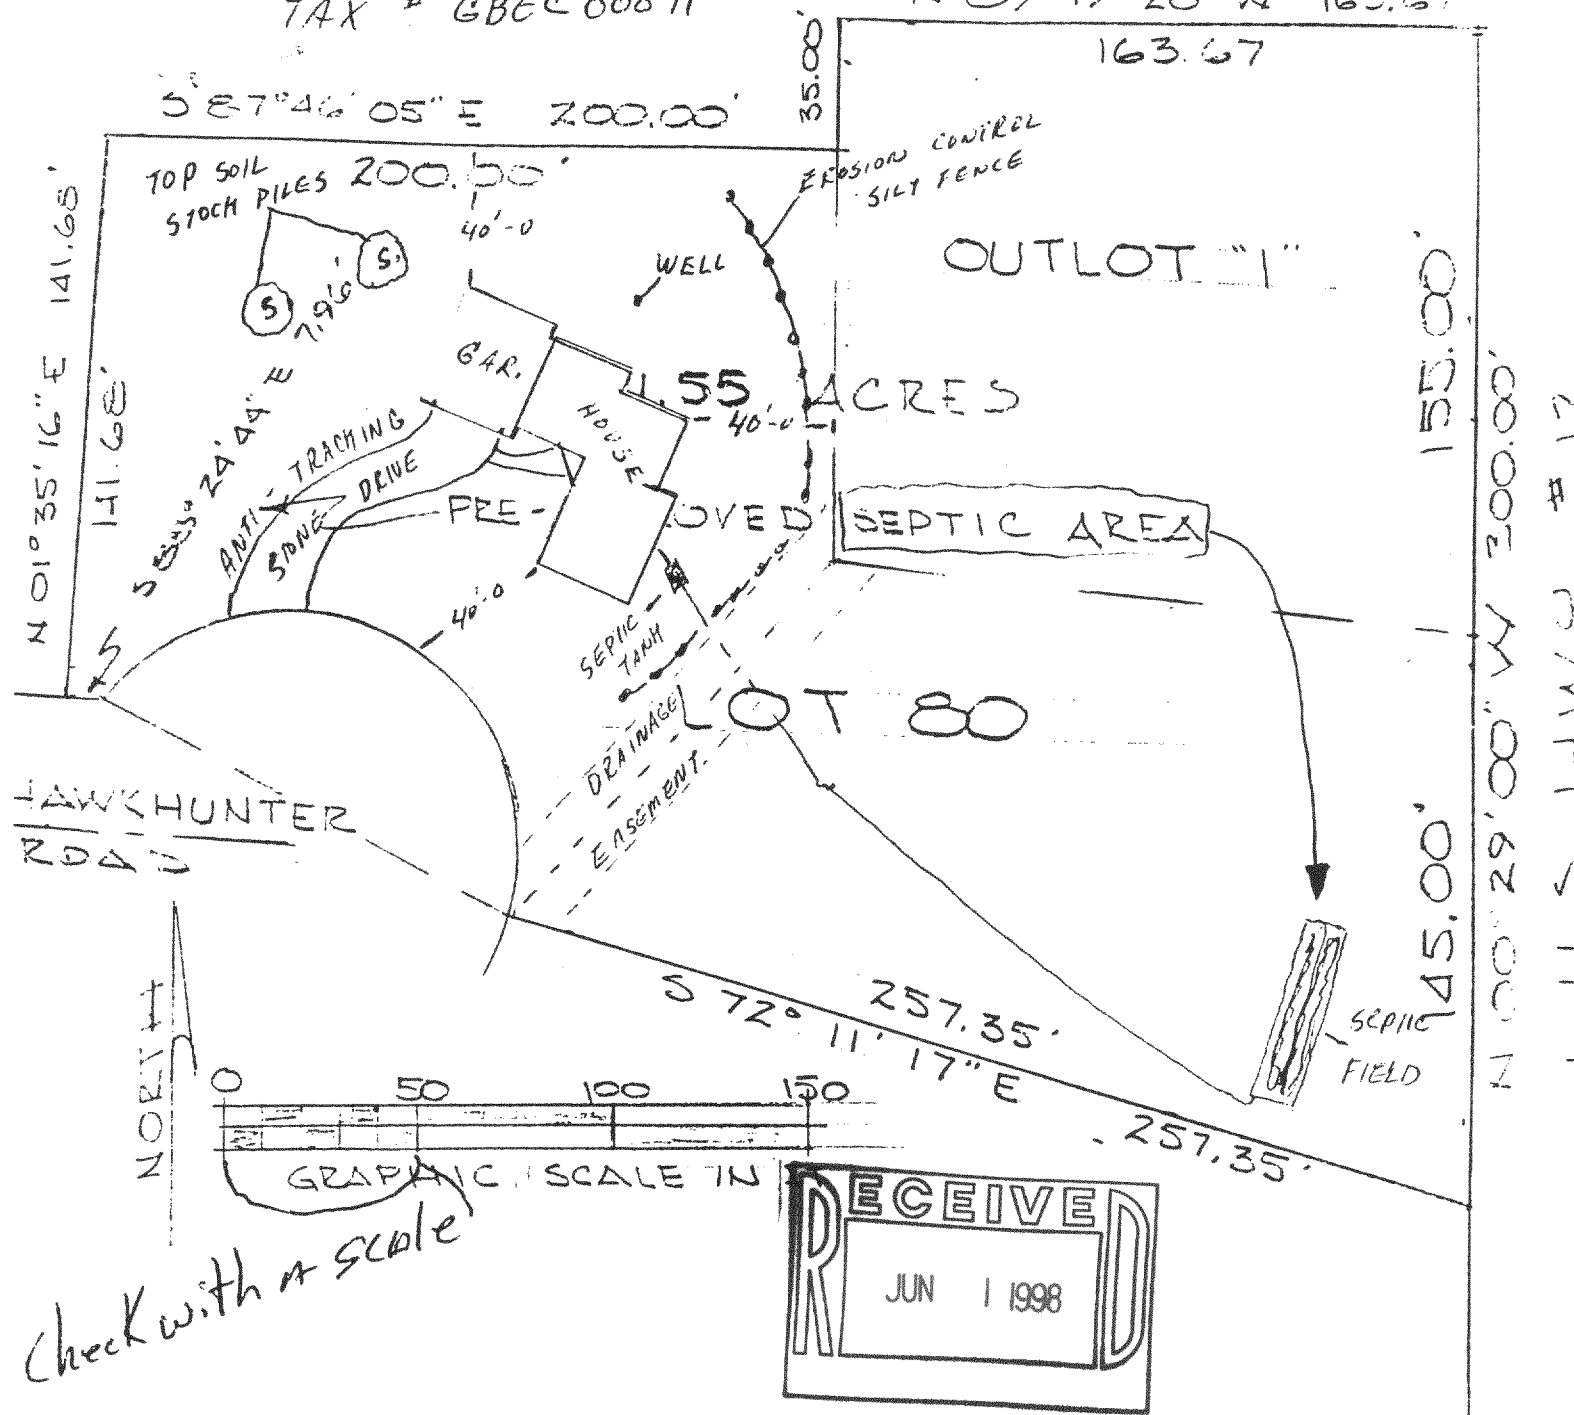

DESCRIPTION: Lot #80 of Baywood Estates Third Addition located Section 1, T. 3 N., R. 16 E., Sugar Creek Township Walworth County, Wisconsin, also Outlot No. 1

CERTIFICATE: I, James F. Biagi, surveyor, do hereby certify that I have surveyed the property hereon described and that the drawing shown hereon is a true representation thereof.

GBEC-11

September 21 1995

[Signature]

A7 W5120 HAWKHUNTER RD., ELAHOON, WIS. 53121

TAX # GBEC 00011

N 89° 19' 28" W 163.67

163.67

S 87° 46' 05" E 200.00

TOP SOIL STOCK PILES 200.50

40'-0"

EROSION CONTROL
SILT FENCE

OUTLOT "1"

1.55 ACRES

SEPTIC AREA

LOT 80

SEPTIC
FIELD

#12
SUN

HAWKHUNTER
ROAD

NORTH


GRAPHIC SCALE IN FT

Check with a scale

DESCRIPTION: Lot #80 of Baywood Estates Third Addition located in Section 1, T. 3 N., R. 16 E., Sugar Creek Township, Walworth County, Wisconsin, also Outlot No. 1

CERTIFICATE: I, James F. Biagi, surveyor, do hereby certify that I have surveyed the property hereon described and that the drawing shown hereon is a true representation thereof.

September 21, 1995

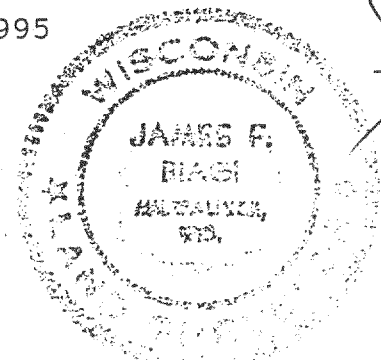

James F. Biagi

James f. Biagi RLS 272

