


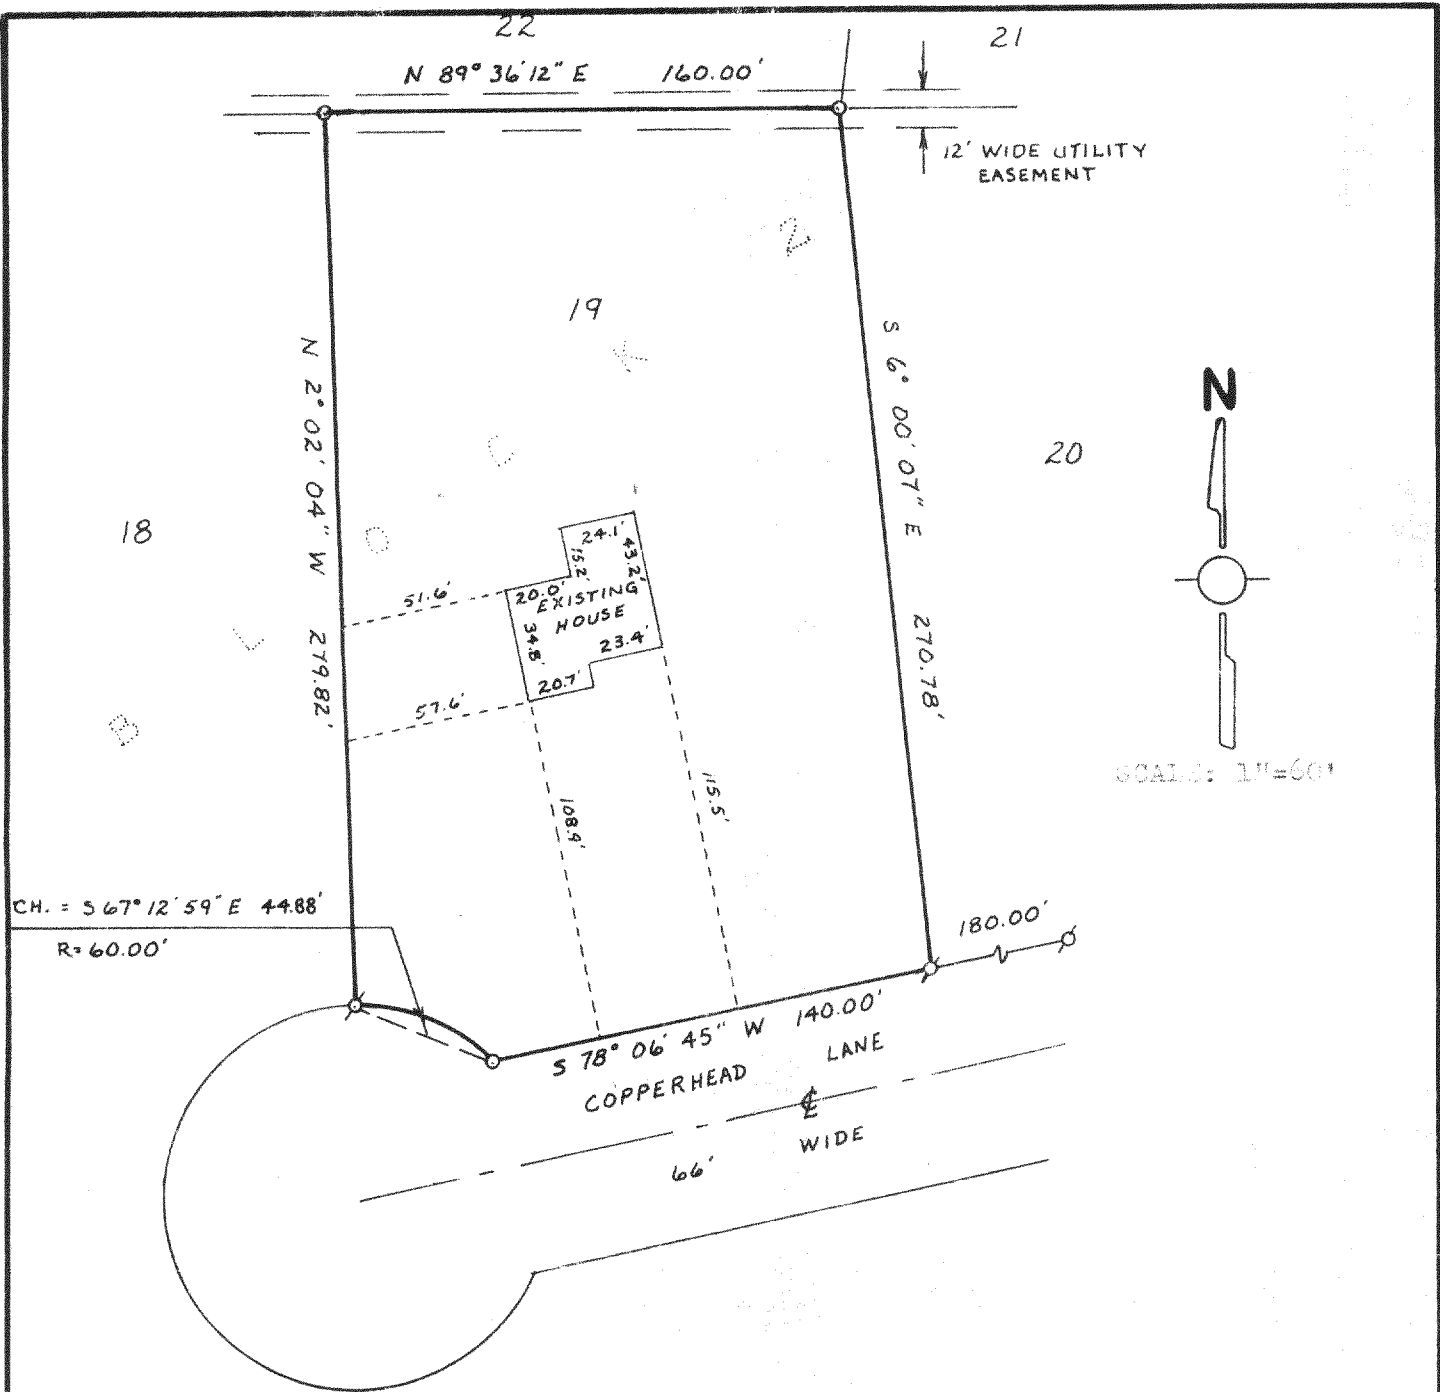

PLAT OF SURVEY OF


LOT 19, BLOCK 2, ALPINE TOWER ESTATES, A SUBDIVISION
 LOCATED IN THE NORTHEAST 1/4 OF SECTION 13, T3N, R17E,
 TOWN OF LAFAYETTE, COUNTY OF WALWORTH, STATE OF
 WISCONSIN.

NOTE: BEARINGS ASSUMED AS PLATTED.

LEGEND

- ⊘ - IRON PIPE FOUND
- - IRON PIPE SET

I HEREBY CERTIFY THAT I HAVE SURVEYED THE ABOVE
 DESCRIBED PROPERTY AND THAT THE ABOVE MAP IS A
 TRUE REPRESENTATION THEREOF AND SHOWS THE SIZE
 AND LOCATION OF THE PROPERTY, ITS EXTERIOR
 BOUNDARIES, THE LOCATION OF ALL VISIBLE
 STRUCTURES AND DIMENSIONS OF ALL PRINCIPAL
 BUILDINGS THEREON, BOUNDARY FENCES, APPARENT
 EASEMENTS, ROADWAYS AND VISIBLE ENCROACHMENTS
 IF ANY.
 THIS SURVEY IS MADE FOR THE USE OF THE PRESENT
 OWNERS OF THE PROPERTY, AND ALSO THOSE WHO
 PURCHASE, MORTGAGE, OR GUARANTEE THE TITLE
 THERETO WITHIN ONE YEAR FROM DATE HEREOF.

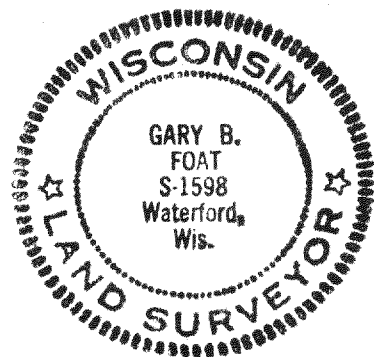

Gary B. Foat
 GARY B. FOAT
 WISCONSIN REGISTERED LAND SURVEYOR, S-1598
 DATE: JUNE 16, 1983

317-100A