


PLAT OF SURVEY
OF
LOT 73, EVERGREEN ESTATES
LOCATED IN SECTION 19, T3N, R17E,
WALWORTH COUNTY, WISCONSIN.

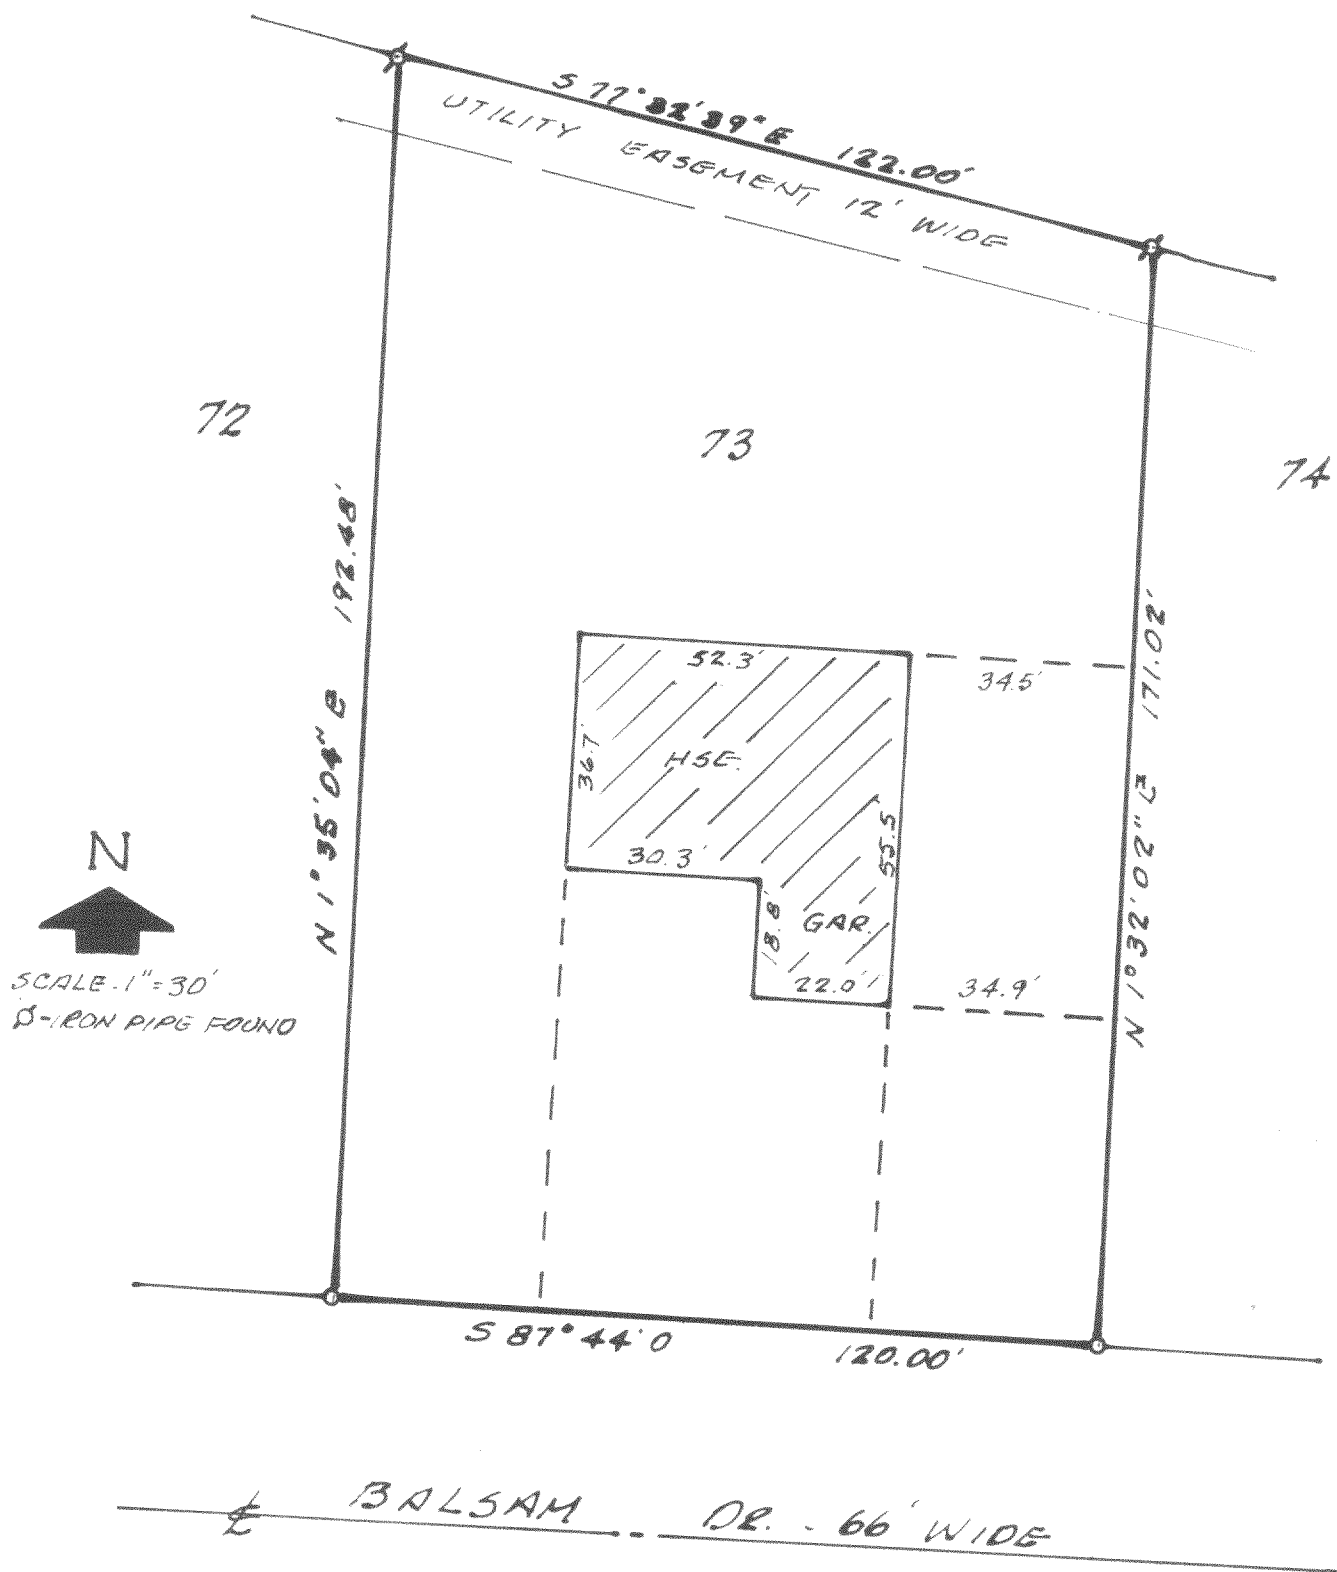


JENSEN SURVEYING AND MAPPING, S.C.
P.O. BOX 322
ELKHORN, WI 53121

SURVEYED BY: THOMAS P.A. JENSEN, R.L.S. 1084

SURVEYED FOR: WILLIAM LANGR

I HEREBY CERTIFY THAT I HAVE SURVEYED
THE ABOVE DESCRIBED PROPERTY, THAT THE
PLAT SHOWN HEREON IS AN ACCURATE SURVEY,
A TRUE REPRESENTATION THEREOF, CORRECTLY
SHOWS THE EXTERIOR BOUNDARY LINES ON SAID
PROPERTY AND THE CORRECT MEASUREMENTS
THEREOF AND BUILDINGS THEREON.

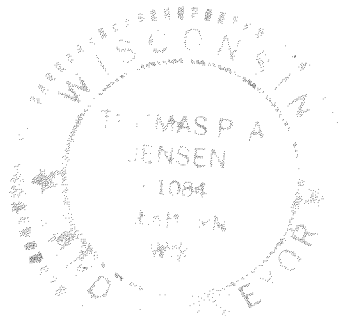

317-100 J THOMAS P.A. JENSEN, R.L.S.

1988 033