



PLAT OF SURVEY OF LOT 132 OF EVERGREEN ESTATES

LOCATED IN SW 1/4 OF NW 1/4 OF SEC. 18, T. 3 N., R. 17 E.
WALWORTH COUNTY, WISCONSIN

I Hereby Certify that at the direction of Russell Larson I have surveyed the parcel described hereon and that this plat is a true and accurate representation of the lot lines and of the building location to the best of my professional knowledge and belief.

Robert A. Farris

DATED 1 AUGUST 1983

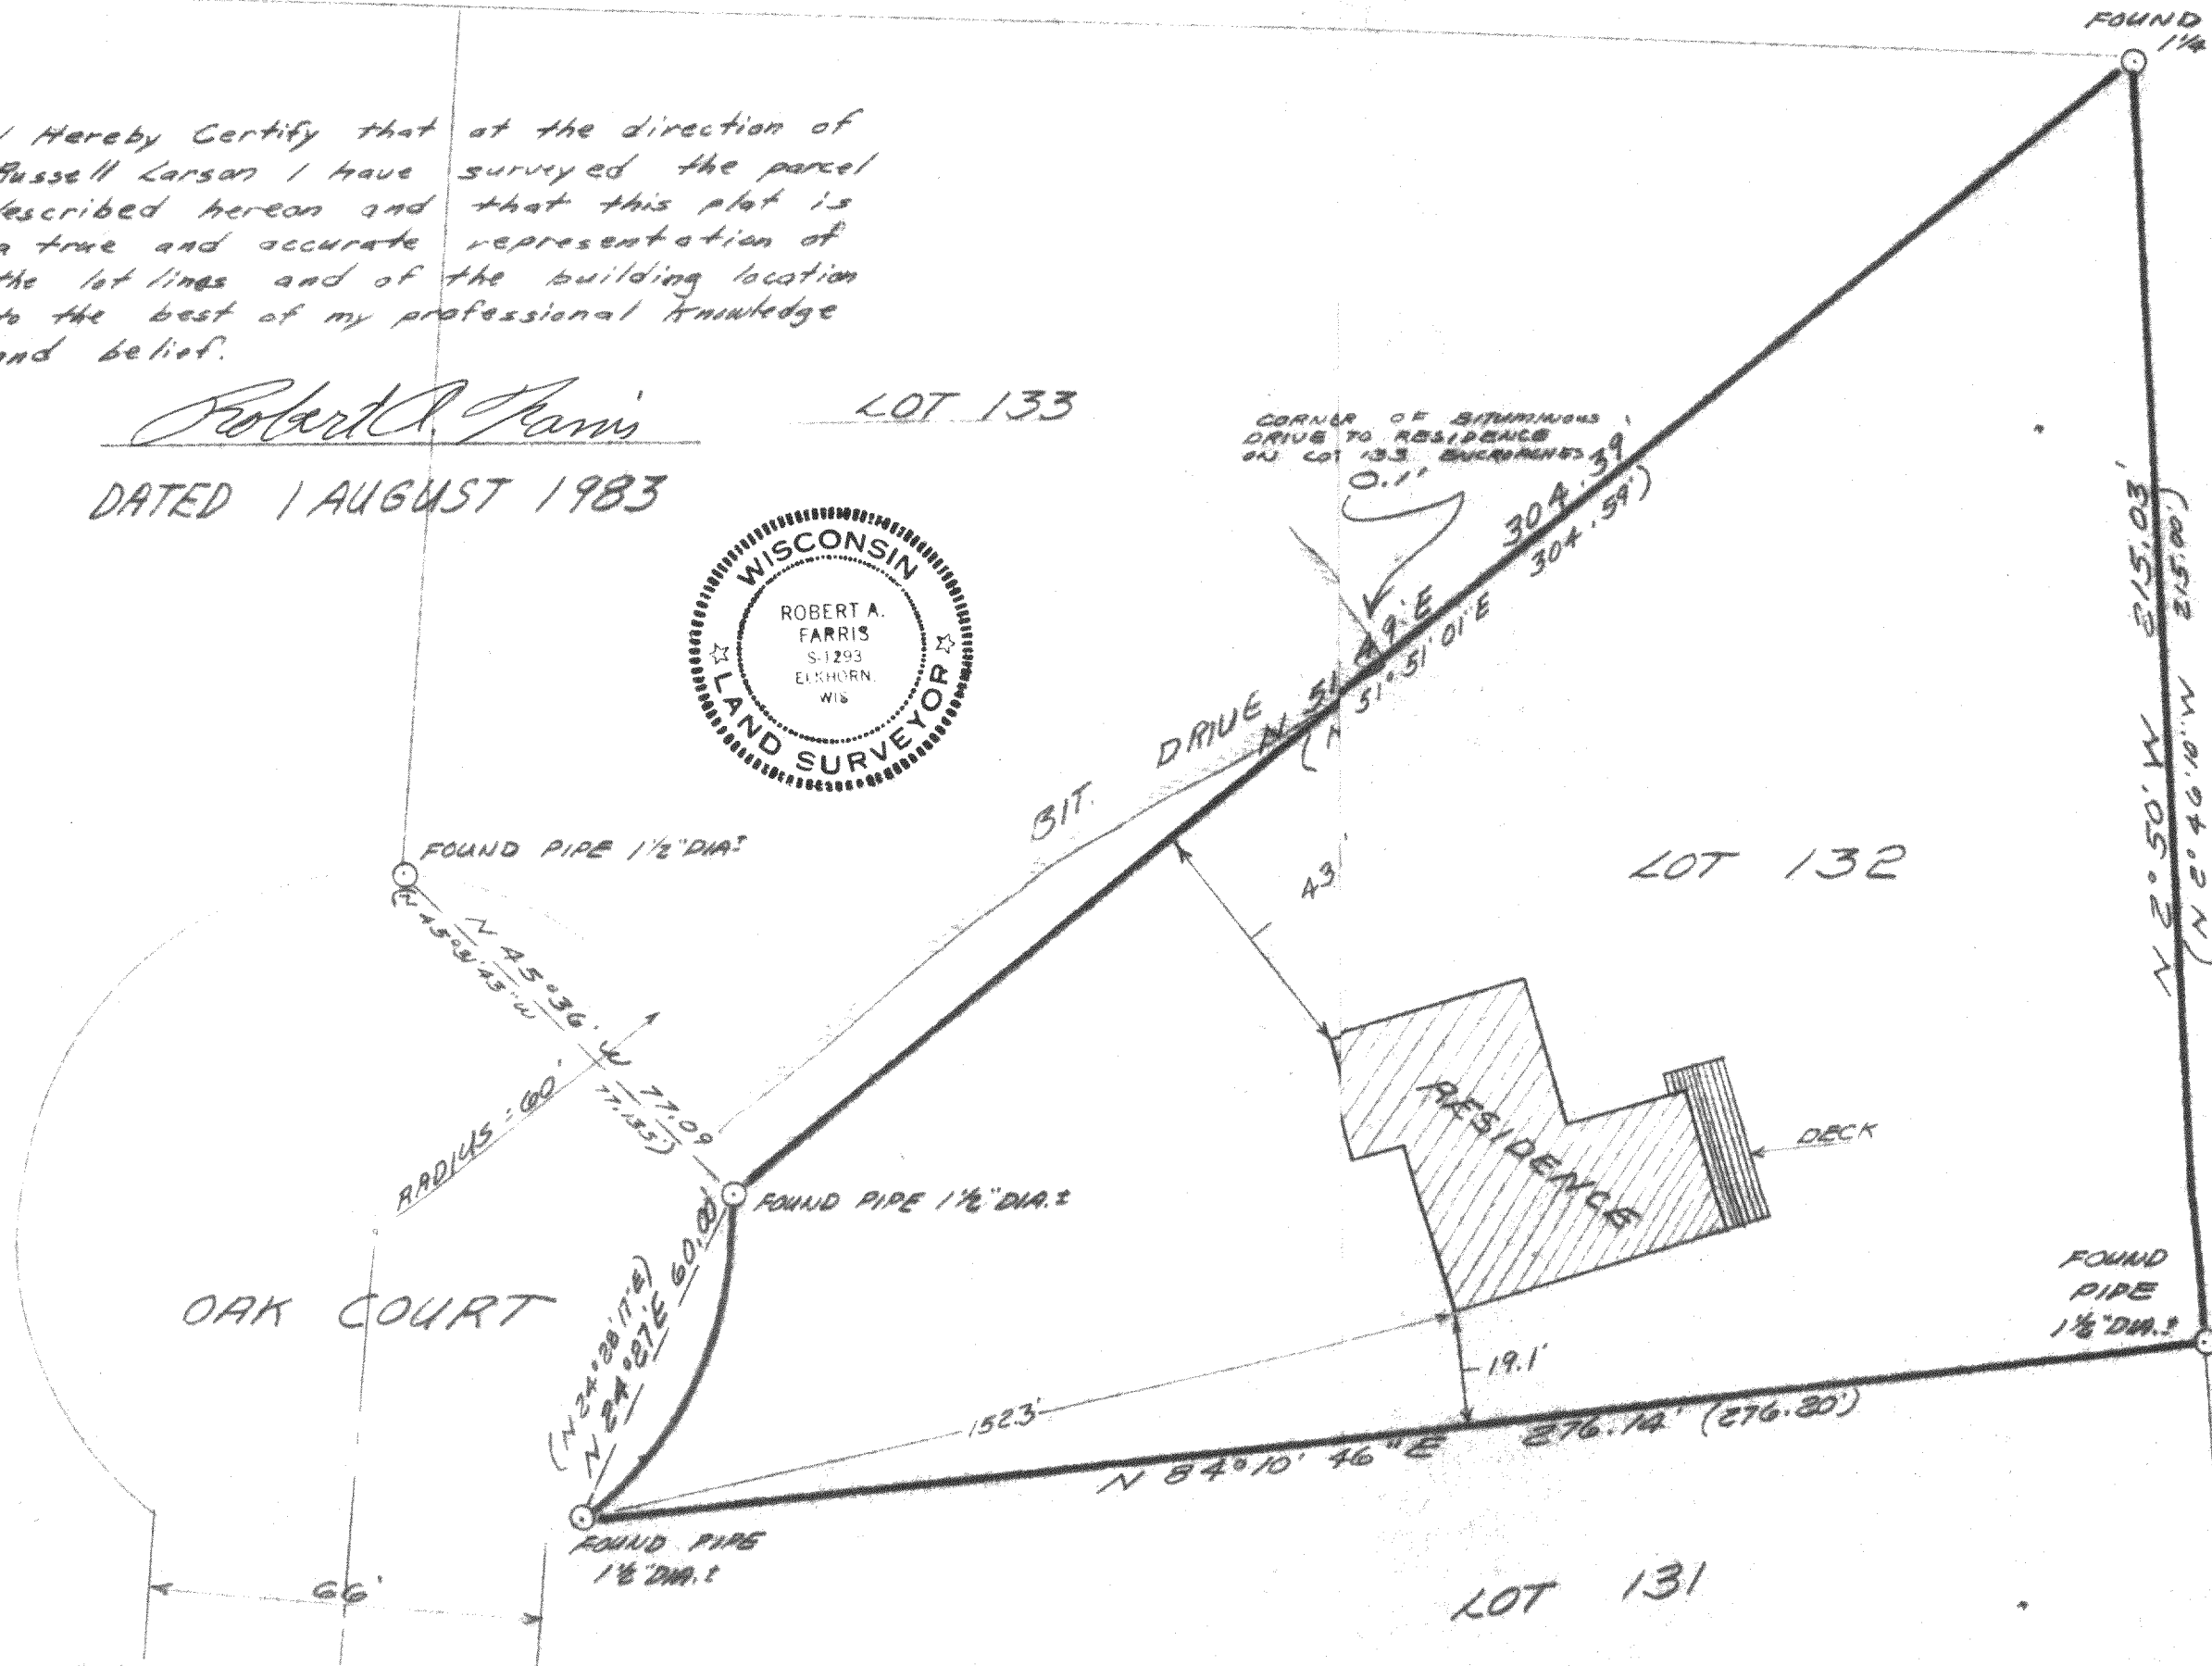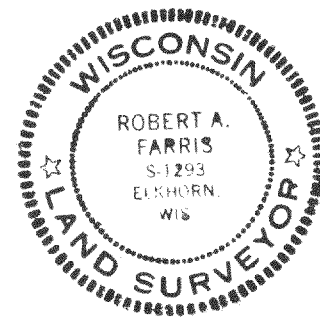

(xxx) = Record Dimension shown on Original Plat of Evergreen Estates

FARRIS, HANSEN & ASSOCIATES, INC.
715 W. Walworth St. P.O. Box 487
Elkhorn, WI 53121

PROJ. NO. 2130