

PLAT OF SURVEY
-OF-

LOT 21 IN SUGAR CREEK PRESERVE, BEING A SUBDIVISION OF PART OF THE SOUTHEAST 1/4 OF THE NORTHWEST 1/4, THE SOUTHWEST 1/4 OF THE NORTHEAST 1/4, THE NORTHEAST 1/4, THE SOUTHEAST 1/4, THE SOUTHWEST 1/4 AND THE NORTHWEST 1/4 OF THE SOUTHWEST 1/4 AND THE NORTHEAST 1/4 AND THE NORTHWEST 1/4 OF THE SOUTHEAST 1/4 OF SECTION 14 AND THE NORTHWEST 1/4 AND THE NORTHEAST 1/4 OF THE NORTHEAST 1/4 AND THE NORTHEAST 1/4 AND THE SOUTHEAST 1/4 OF THE NORTHWEST 1/4 OF SECTION 23, ALL IN TOWN 3 NORTH, RANGE 17 EAST IN THE TOWN OF LAFAYETTE, WALWORTH COUNTY, WISCONSIN.


SURVEY FOR: STUART BROWN

SCALE: 1" = 40'

LEGEND

- FOUND IRON PIPE
- FOUND SPIKE
- ∅ SET IRON PIPE


GRAPHIC SCALE

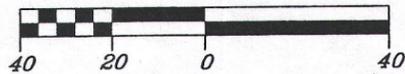

NOTE: BEARINGS HEREON RELATE TO THE RECORDED PLAT OF SUGAR CREEK PRESERVE.

"I hereby certify that I have surveyed the above described property and that the above map is a correct representation thereof and shows the size and location of the property, its exterior boundaries, the location of all visible structures and dimensions of all principal buildings thereon, boundary fences, apparent easements, roadways and encroachments, if any."

"This survey is made for the use of the present owners of the property, and those who purchase, mortgage, or guarantee the title thereto within one year from date hereof."

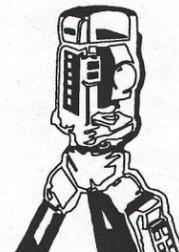


B.W. SURVEYING, INC.

LAND SURVEYS
MAPPING AND PLANNING
412 N. PINE STREET
BURLINGTON, WI 53105
(262)-767-0225

PRIMARY ENVIRONMENTAL
CORRIDOR LINE PER PLAT

NOTE: REFER TO A CURRENT TITLE REPORT FOR EASEMENTS AND RESTRICTIONS WHICH MAY AFFECT THE USE OF THIS SITE.

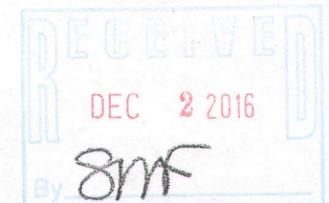


THIS IS NOT AN ORIGINAL PRINT
UNLESS THIS SEAL IS RED.

Robert J. Wetzel
ROBERT J. WETZEL S-1778

OCTOBER 21, 2016
DATE

9129
JOB NUMBER

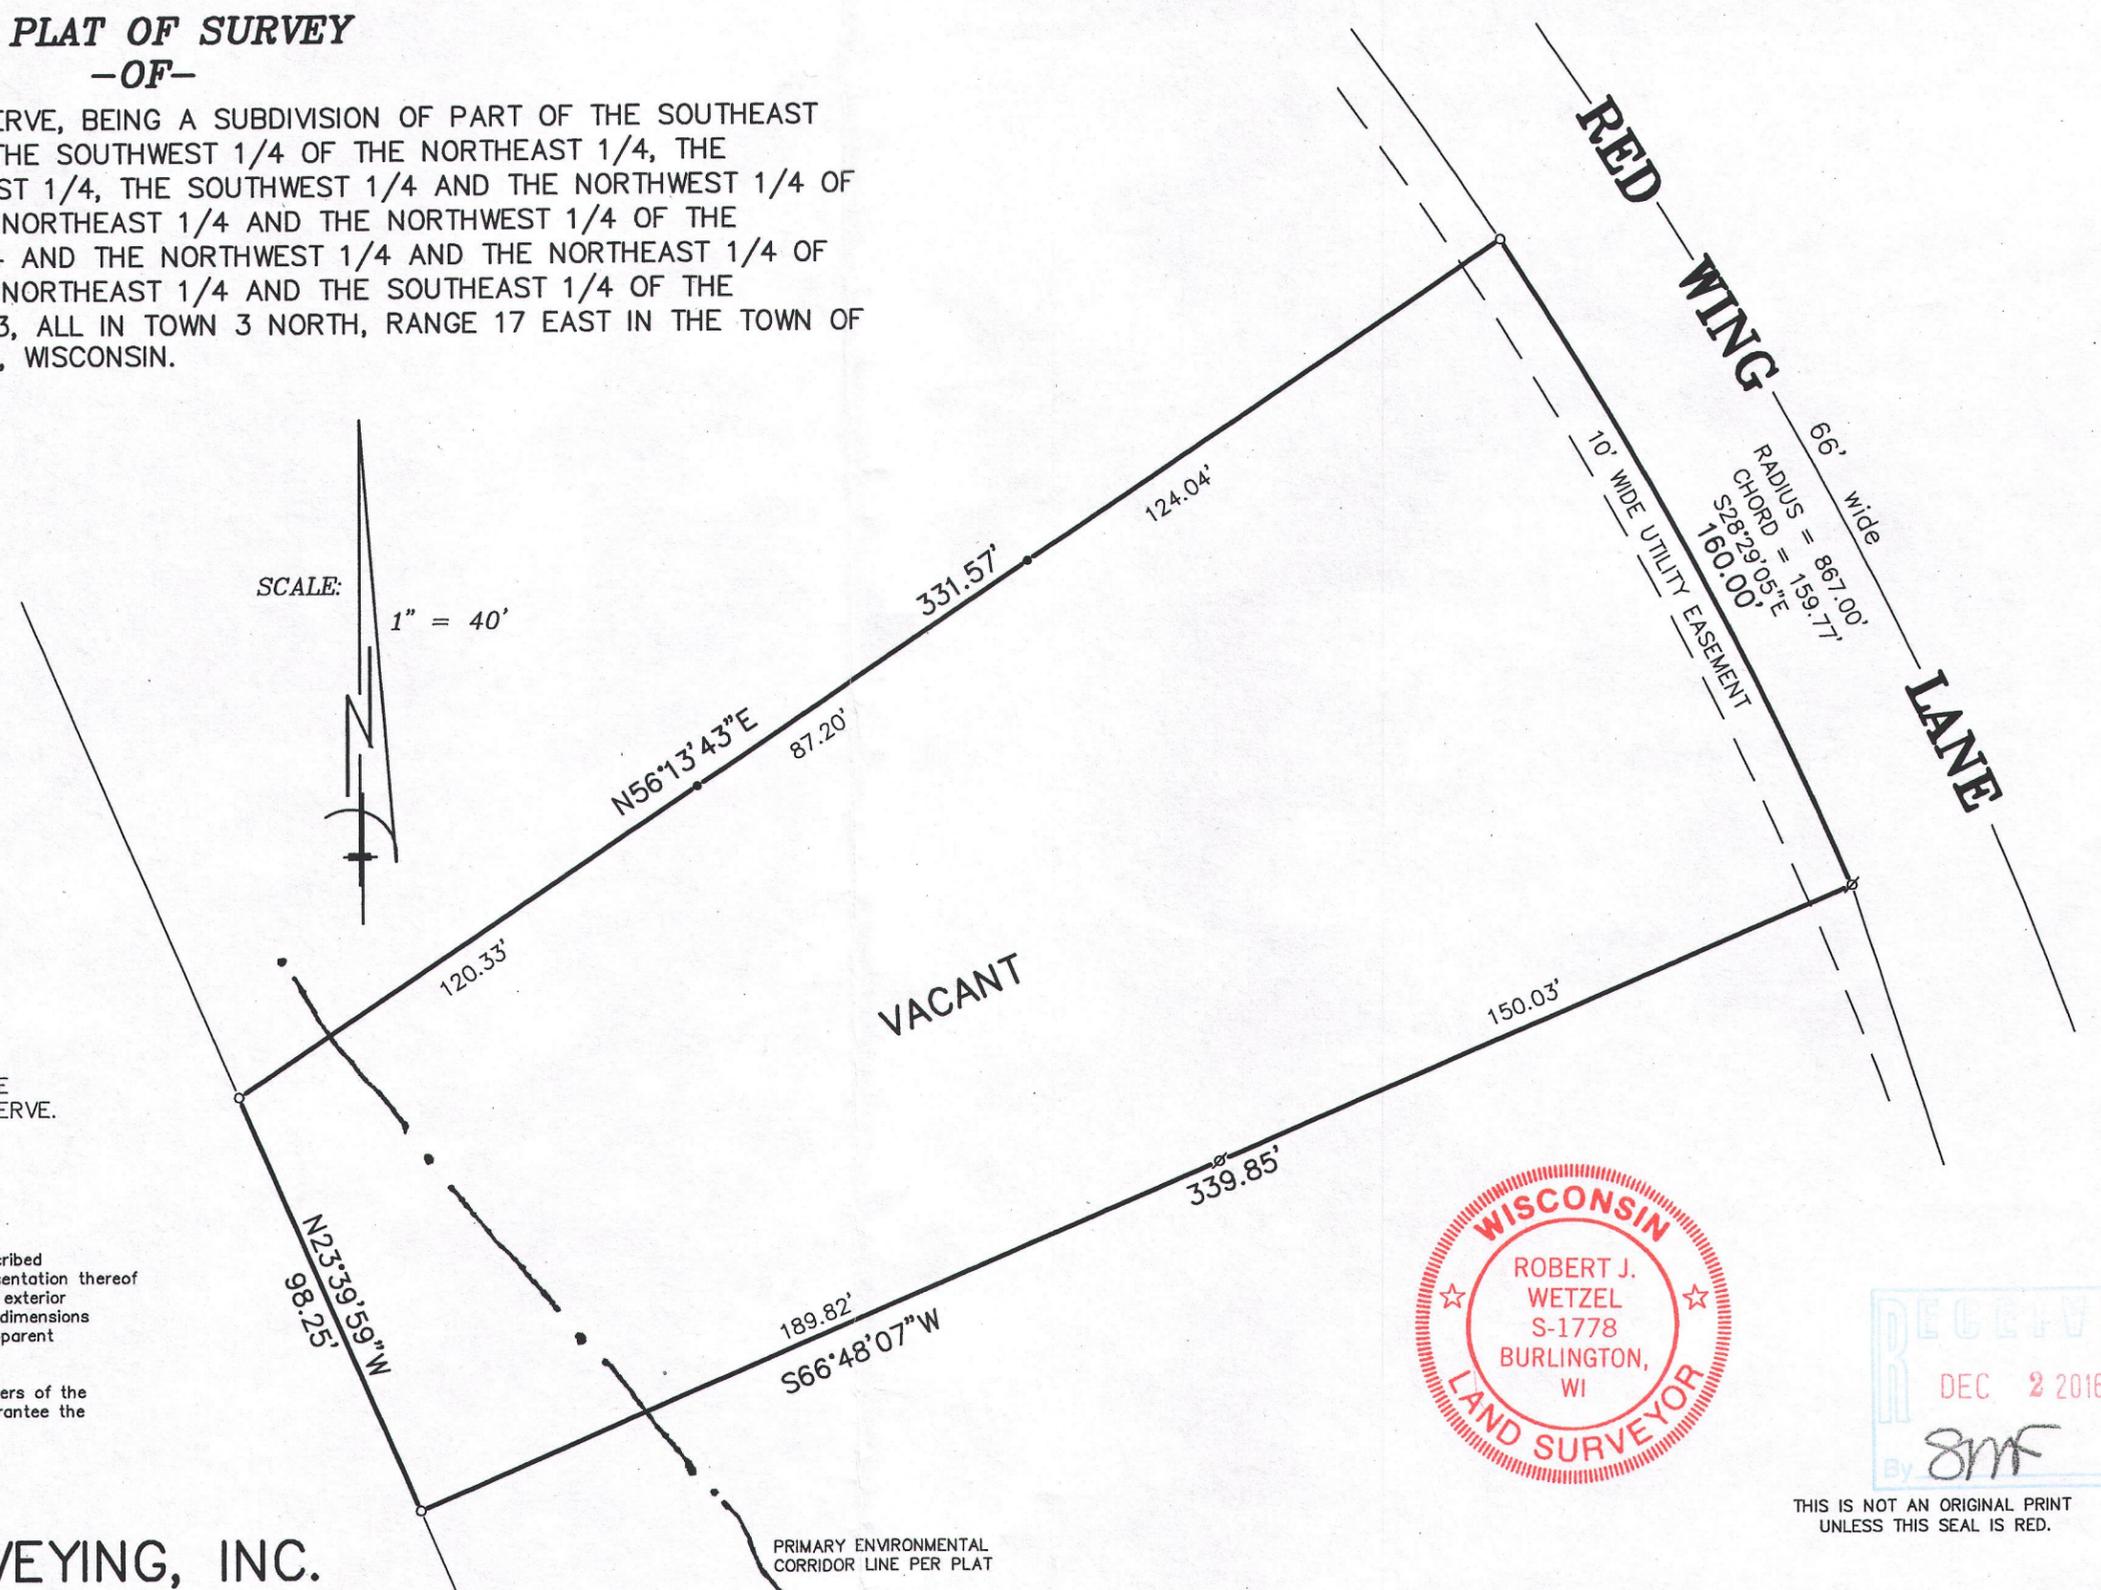

KSCP-21

317-1033