

COOPER SURVEYING SERVICES

Rural - Residential - Commercial


DANIEL D. COOPER
Registered Land Surveyor

Route 3, Box 255 :: Elkhorn, Wisconsin 53121

Phone (414) 723-6265

SURVEYING & PLANNING
SUBDIVISIONS - LOT SURVEYS
CONSTRUCTION STAKING - MAPPING

Plat of Survey of Lot 111 of Evergreen Estates
being a subdivision located in the town of
LaFayette, Walworth County, Wisconsin.

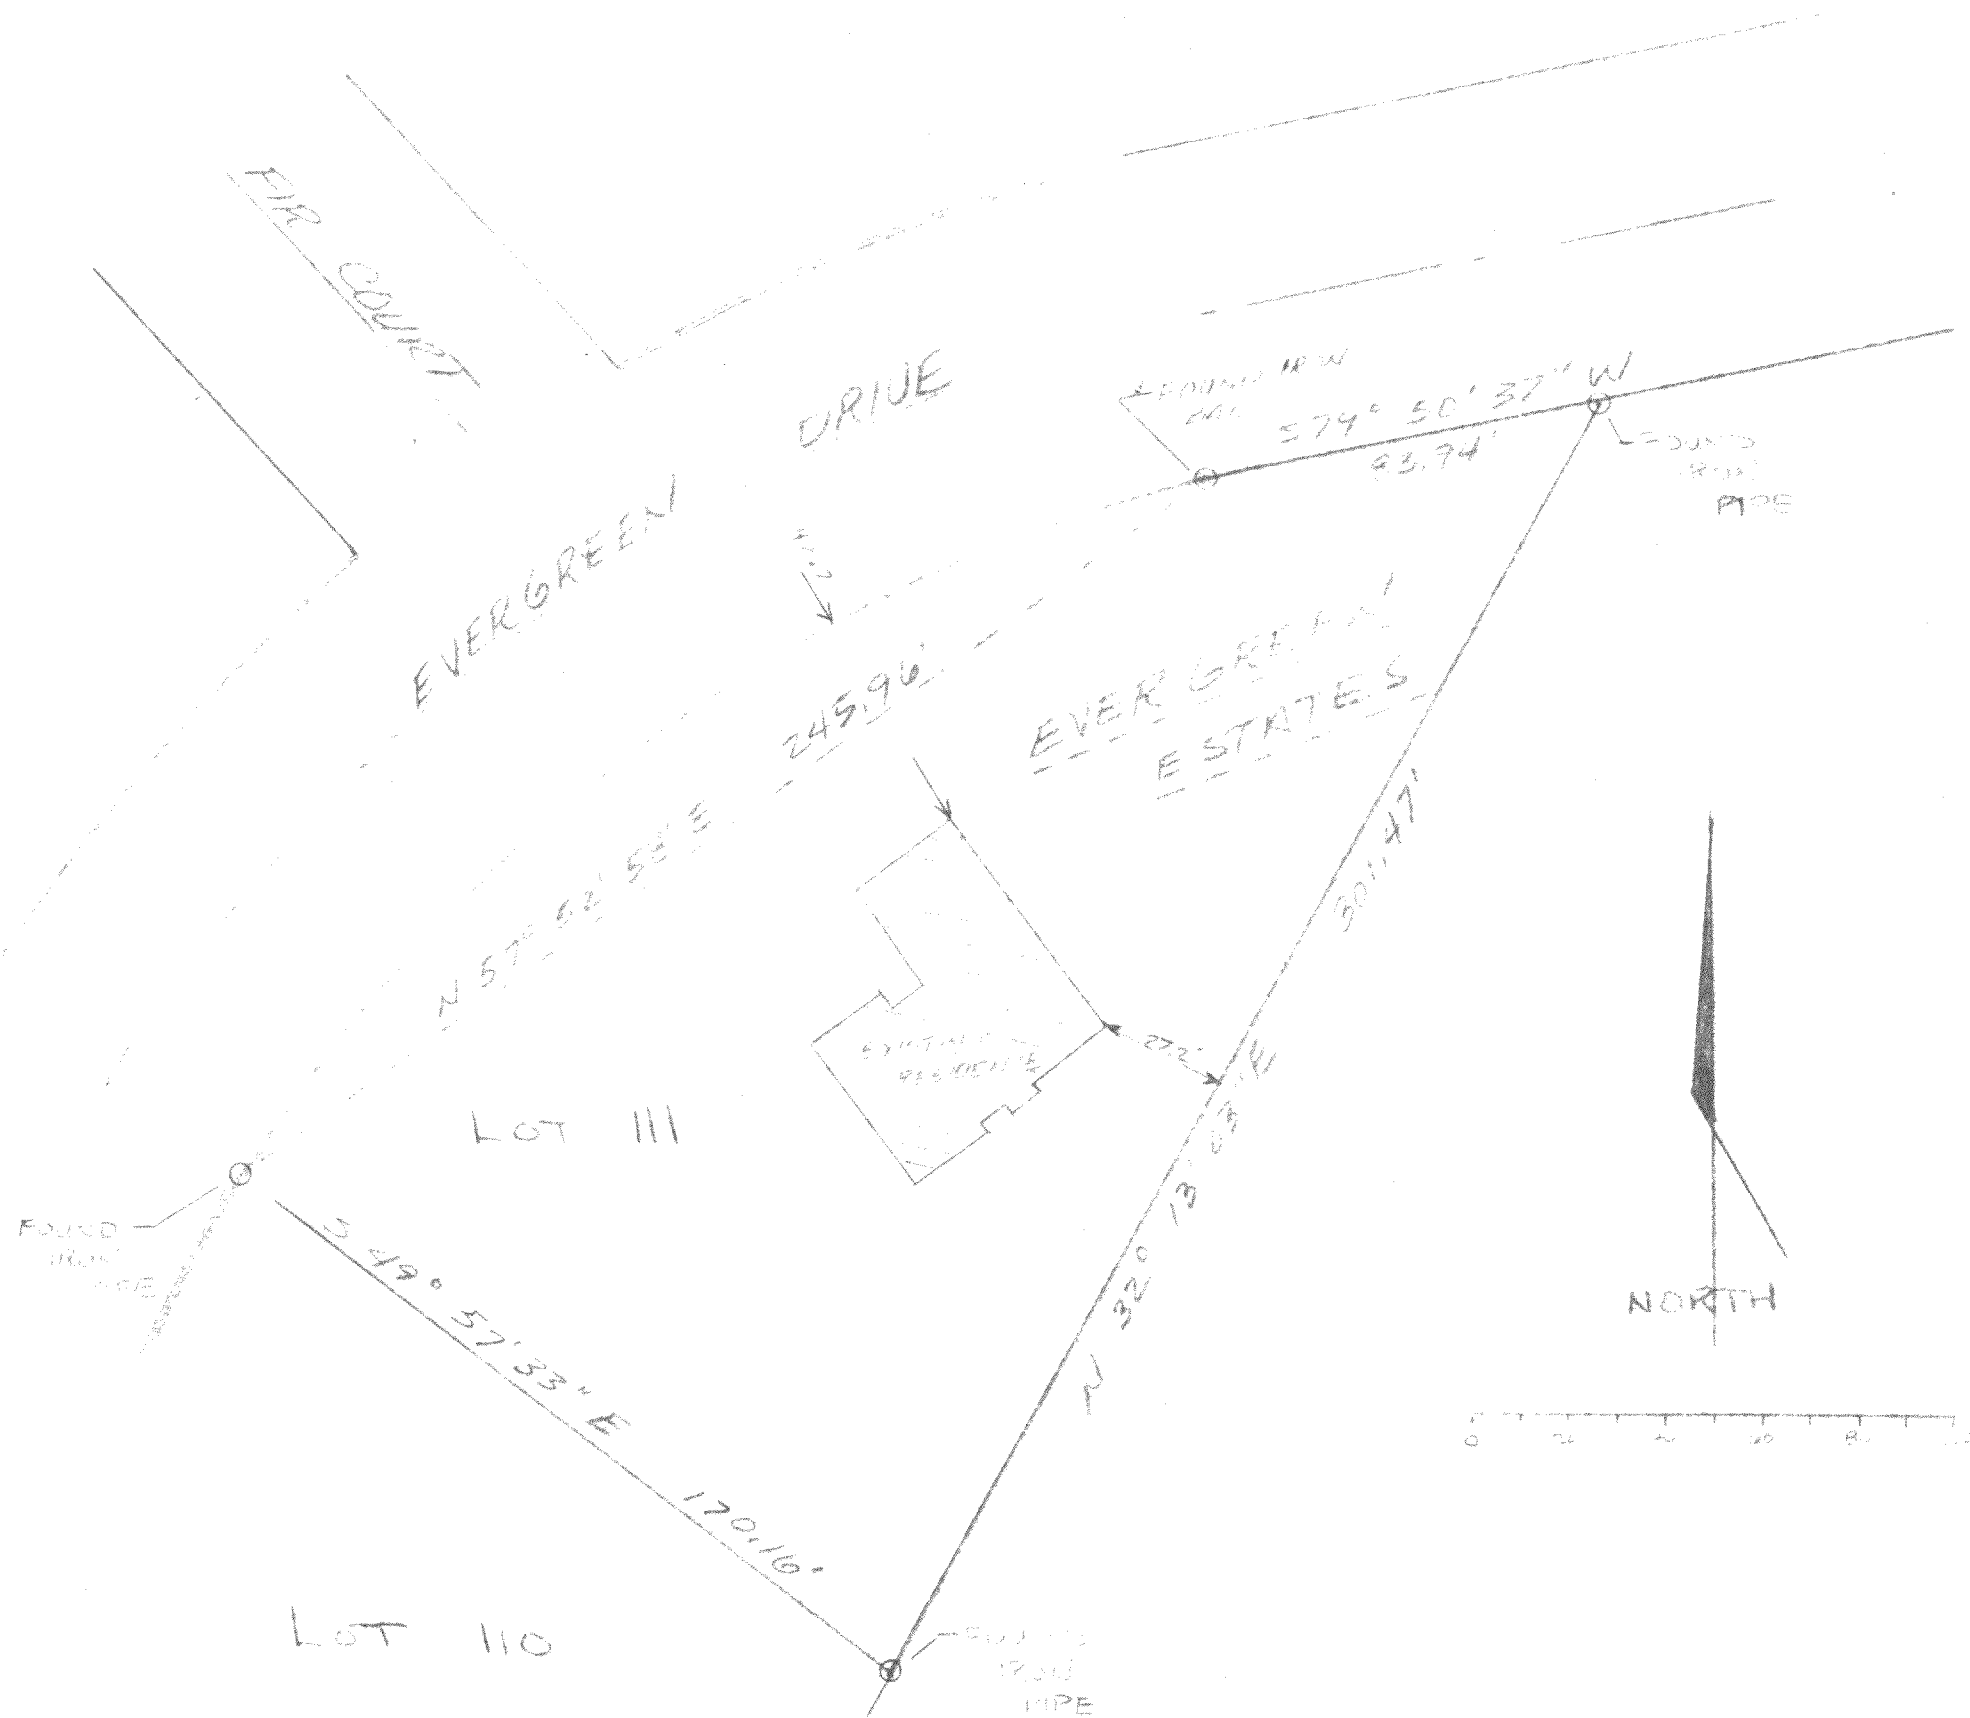

Work ordered by Lauderdale Lakes Realty

I hereby certify that I have surveyed the property described hereon and that the above map is a true representation thereof and shows the size and location of the property, the location of visible structures and all principal buildings thereon. This survey is made for the present owners of the property and also those who purchase, mortgage, or guarantee the title thereto within one year from the date thereof.

Dated this 26 day of Oct., 1982

Daniel D. Cooper
Daniel D. Cooper, RLS No. S-1464

