


Plat of Survey

of

Lot 103 of Evergreen Estates,

a subdivision located in the Southwest 1/4 of Section 18, Town 3 North,
Range 17 East, Town of LaFayette, Walworth County, Wisconsin.

Surveyed for: **Mike Schmieden**
W5137 Hares Foot Road
Elkhorn, Wisconsin. 53121

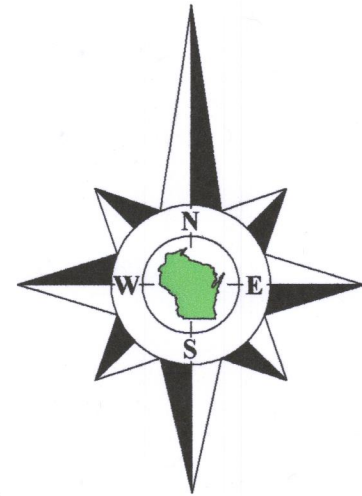

Bearings reference to the North
line of Evergreen Drive, recorded
as S67°44'33"W on the plat of
Evergreen Estates.

Lot 102

Golf Course

Tax Parcel
KLF 1800007

recorded as (S86°02'54"E 65')
S85°54'58"E 64.77'

12' Wide Utility Easement
As shown on the plat
of Evergreen Estates

25' Rearyard Setback

Lot 103
Tax Parcel
KE 00103
0.956 Acre
41,664 Sq.Ft.

Lot 104

Scale in Feet
1" = 20'




45 South Wisconsin Street | P.O. Box 322
Elkhorn, Wisconsin 53121
Telephone: (262) 723-3434
Facsimile: (262) 723-8044
Email: doug@olsonsurveying.com
Website: www.olsonsurveying.com

OLSON
LAND SURVEYING, LLC
Rural | Residential | Commercial

Legend of Symbols & Abbreviations
Found Iron Pipe
Found Iron Rod
Set Iron Pipe, 1" dia.
Recorded Information
Utility Box or Pedestal
Set Stake
Set Wood Stake

Sheet 1 of 1 Sheets
Drawing Name: 2017.003 Plat REV 2
Job Reference Number
2017.003

2017.003

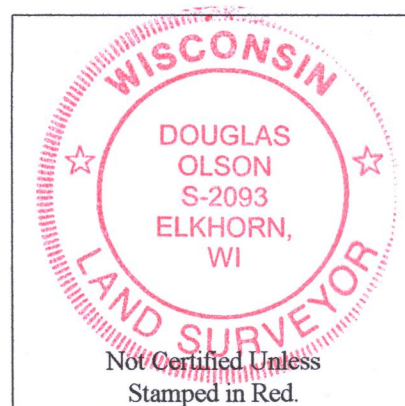

Notes:

- 1) This Plat of Survey is not certified unless signed and sealed in red ink.
- 2) This survey is subject to Wisconsin lien laws. This Plat of Survey is the notice of intent to file lien. Lien waiver required.
- 3) The Survey Date shown on this Plat of Survey is the completion date of the field work.

Copyright ©2017 by Olson Land Surveying, LLC.

All rights reserved. No part of this survey plat may be reproduced or transmitted in any form by any means - graphic, electronic, or mechanical, including photocopying, tracing, or information storage and retrieval systems - without permission in writing from Douglas G. Olson, Olson Land Surveying, LLC.

I hereby certify that I have surveyed the above described property in compliance with Chapter A-E 7 of the Wisconsin Administrative Code and that the map hereon is correct to the best of my knowledge and belief.

Douglas G. Olson
Wisconsin Professional Land Surveyor - 2093

KE-103

317-1059

