


FOUNDATION AS BUILT

LOT 1 OF CERTIFIED SURVEY MAP NUMBER 4253 BEING
A DIVISION OF LANDS LOCATED IN THE NORTHEAST 1/4
AND NORTHWEST 1/4 OF THE SOUTHEAST 1/4 OF
SECTION 11; AND THE SOUTHWEST 1/4 OF THE
NORTHWEST 1/4 AND NORTHWEST 1/4 OF THE
SOUTHWEST 1/4 OF SECTION 12, ALL IN TOWNSHIP 3
NORTH, RANGE 17 EAST, TOWN OF LAFAYETTE,
WALWORTH COUNTY WISCONSIN.

NW CORNER
NW 1/4
SEC. 12-3-17
N 274356.26
E 2417689.23

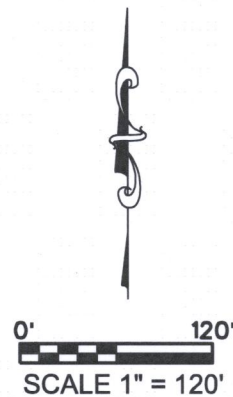

CURVE DATA

C1
ARC - 340.80'
RADIUS - 851.96'
CHORD - N22°22'12"W
338.53'

LINE TABLE

LINE	BEARING	DISTANCE
L1	N10°40'09"W	37.68'
L2	N20°40'09"W	63.40'
L3	N22°54'14"W	65.45'
L4	N10°54'38"W	126.36'
L5	N11°09'56"W	158.22'
L6	N15°59'13"W	187.94'
L7	N22°07'58"W	146.15'
L8	S75°10'31"W	148.93'
L9	S82°01'25"W	151.85'

NW CORNER
NW 1/4
SEC. 12-3-17
N 274356.26
E 2417689.23

SECTION 11; AND THE SOUTHWEST 1/4 OF THE
NORTHWEST 1/4 AND NORTHWEST 1/4 OF THE
SOUTHWEST 1/4 OF SECTION 12, ALL IN TOWNSHIP 3
NORTH, RANGE 17 EAST, TOWN OF LAFAYETTE,
WALWORTH COUNTY WISCONSIN.

0' 120'
SCALE 1" = 120'

CURVE DATA
C1
ARC - 340.80'
RADIUS - 851.96'
CHORD - N22°22'12"W
338.53'

LINE TABLE		
LINE	BEARING	DISTANCE
L1	N10°40'09"W	37.68'
L2	N20°40'09"W	63.40'
L3	N22°54'14"W	65.45'
L4	N10°54'38"W	126.36'
L5	N11°09'56"W	158.22'
L6	N15°59'13"W	187.94'
L7	N22°07'58"W	146.15'
L8	S75°10'31"W	148.93'
L9	S82°01'25"W	151.85'

SW CORNER
NW 1/4
SEC. 12-3-17
N 271737.18
E 2417774.80

LOT 2
CSM # 4253

660.00'

LOWERS ROAD
(R.O.W. WIDTH VARIES)

GARAGE

SHED

APPROXIMATE C/L OF
INTERMITTENT STREAM
PER WALWORTH
COUNTY G.I.S.

CULVERT

PROPOSED DRIVEWAY

RAW POST
1.0'E

RAW POST
1.2'S

RAW POST
2.2'E

RAW POST
2.5'S

RAW POST
0.2'W

RAW POST
2.8'S

RAW POST
2.2'E

RAW POST
2.5'S

RAW POST
0.2'W

RAW POST
2.8'S

RAW POST
2.2'E

RAW POST
2.5'S

RAW POST
0.2'W

RAW POST
2.8'S

RAW POST
2.2'E

RAW POST
2.5'S

RAW POST
0.2'W

RAW POST
2.8'S

RAW POST
2.2'E

RAW POST
2.5'S

KA4253-1 317-1117



SURVEY MADE FOR:
CASEY KROLL
N8670 WILMER'S GROVE RD
EAST TROY, WI 53120

DATE	ITEM
04/27/2018	ORIGINAL SURVEY
05/14/2018	REV. HOUSE LOCATION
05/17/2018	REV. HOUSE LOCATION
10/10/2018	FOUNDATION AS BUILT

THIS SURVEY IS MADE FOR THE USE OF THE PRESENT OWNERS
OF THE PROPERTY, AND ALSO THOSE WHO PURCHASE, MORTGAGE
OR GUARANTEE TITLE TO WITHIN ONE (1) YEAR FROM DATE HERETO.

I, MICHAEL A. GREESON R.L.S. #2770, HEREBY CERTIFY THAT THIS SURVEY WAS MADE IN ACCORDANCE WITH THE MINIMUM STANDARDS FOR PROPERTY SURVEYS (CHAPTER A-E 7) FOR THE STATE OF WISCONSIN AND HAS BEEN PREPARED UNDER MY DIRECTION AND CONTROL AND IS CORRECT TO THE BEST OF MY KNOWLEDGE AND BELIEF.

