
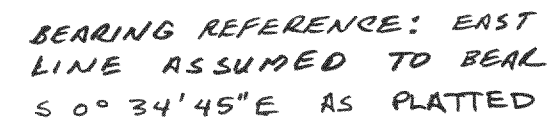


Rural • Residential • Commercial

Route 1, Box 195 :: Elkhorn, Wisconsin 53121

SURVEYING & PLANNING
SUBDIVISIONS - LOT SURVEYS
CONSTRUCTION STAKING - MAPPING

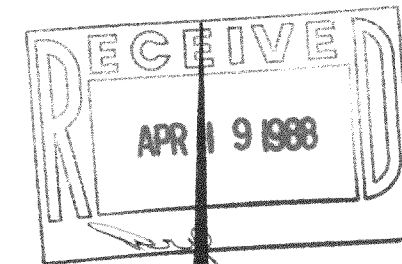


1. DANIEL D. COOPER, REGISTERED SURVEYOR, DO HEREBY CERTIFY THAT I HAVE SURVEYED THE PROPERTY DESCRIBED HEREON AND THAT THE MAP SHOWN HEREON IS A TRUE AND ACCURATE REPRESENTATION THEROF TO THE BEST OF MY PROFESSIONAL KNOWLEDGE AND BELIEF.

DATED THIS 1st DAY OF JUNE, 1984

DANIEL D. COOPER, RLS NO. 9-1464



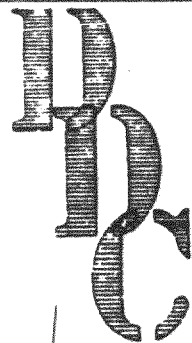


D.D. COOPER & CO. INC.

ROUTE 4, BOX 308 B
ELKHORN, WI 53121


PH 414-723-6265

SURVEYING • MODULAR HOMES

LONGMEADOW DRIVE

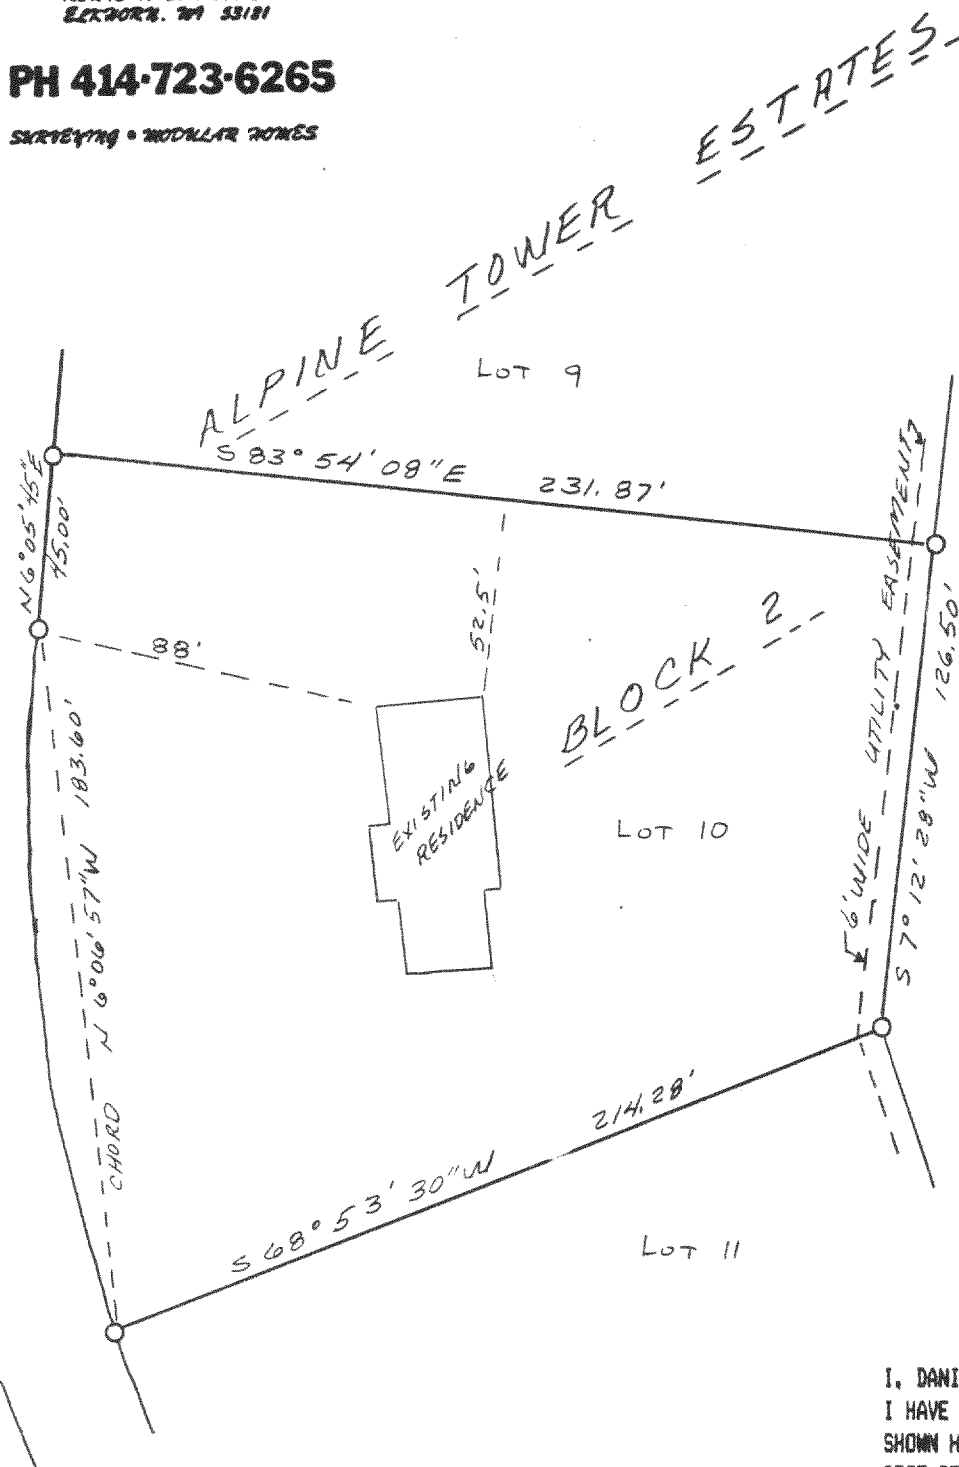

PLAT OF SURVEY OF LOT 10 BLOCK 2 ALPINE TOWER ESTATES BEING LOCATED
IN TOWN 3 NORTH RANGE 17 EAST TOWN OF LAFAYETTE WALWORTH COUNTY WISCONSIN

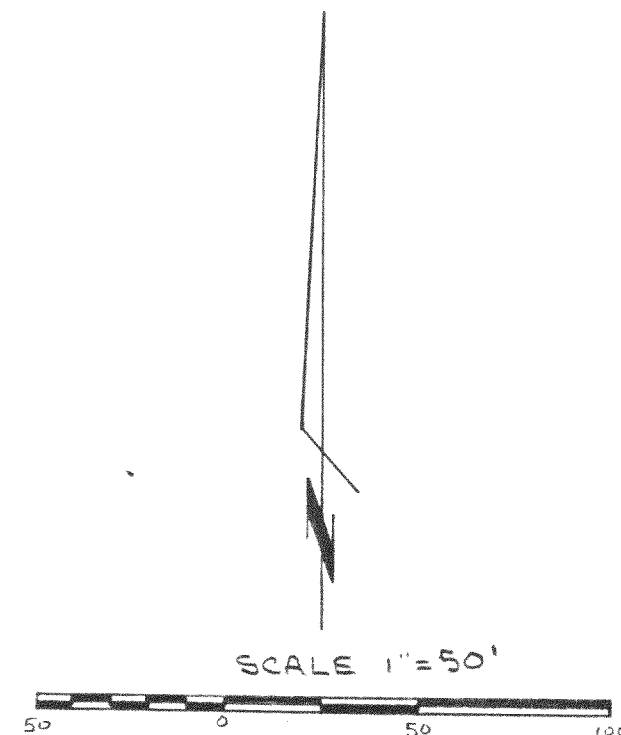


SURVEYED FOR RAMANI REALTY

BEARING REFERENCE
SOUTHERLY LINE OF PARCEL ASSUMED TO BEAR S 68° 53' 30" W

I, DANIEL D. COOPER, REGISTERED SURVEYOR, DO HEREBY CERTIFY THAT
I HAVE SURVEYED THE PROPERTY DESCRIBED HEREON AND THAT THE MAP
SHOWN HEREON IS A TRUE AND ACCURATE REPRESENTATION THEREOF TO THE
BEST OF MY PROFESSIONAL KNOWLEDGE AND BELIEF.

DATED THIS 18 DAY OF Sept, 1984

Daniel D. Cooper
DANIEL D. COOPER, RLS NO. S-1464

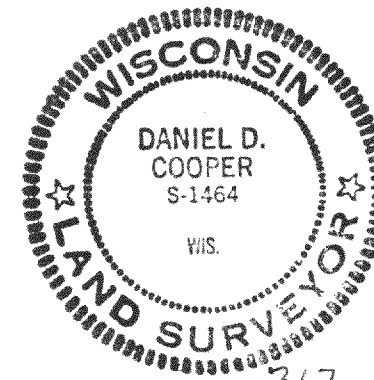

317-114

DRAWING NO. 1967