


PLAT OF SURVEY LOT 67 EVERGREEN ESTATES LOCATED IN
 NW 1/4 SEC. 19, T. 3N, R. 17E., WALWORTH CO., WISCONSIN

WORK ORDERED BY ELKHORN LBR. CO.
 (XXX) = RECORD DIMENSION

I hereby certify that I have surveyed the above described property and that the above map is a true representation thereof and shows the size and location of the property, its exterior boundaries, the location of all visible structures and dimensions of all principal buildings thereon, boundary fences, apparent easements, roadways and visible encroachments, if any.
 This survey is made for the use of the present owners of the property, and also those who purchase, mortgage, or guarantee the title thereto within one (1) year from date hereof.

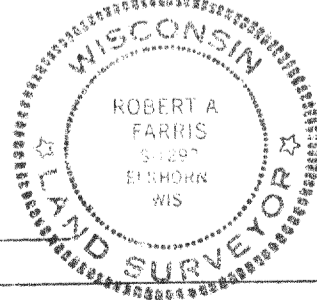

Farris, Hansen & Associates, Inc.
 Engineering, Surveying & Land Planning
 P.O. BOX 487
 715 W. WALWORTH STREET
 ELKHORN, WISCONSIN 53121

Robert A. Farris
 DATE 5/1/85

PROJECT #2401

317-117 ✓