

PLAT OF SURVEY


LOCATION: Sugarloaf Lane, Lafayette, Wisconsin

LEGAL DESCRIPTION:

Lot 21 in Block 2 in **ALPINE TOWER ESTATES**, a Subdivision located in part of the Northeast 1/4 of Section 13, Town 3 North, Range 17 East, of the 4TH Principal Meridian, Town of Lafayette, Walworth County, Wisconsin

August 11, 2021

Survey No. 112493-B

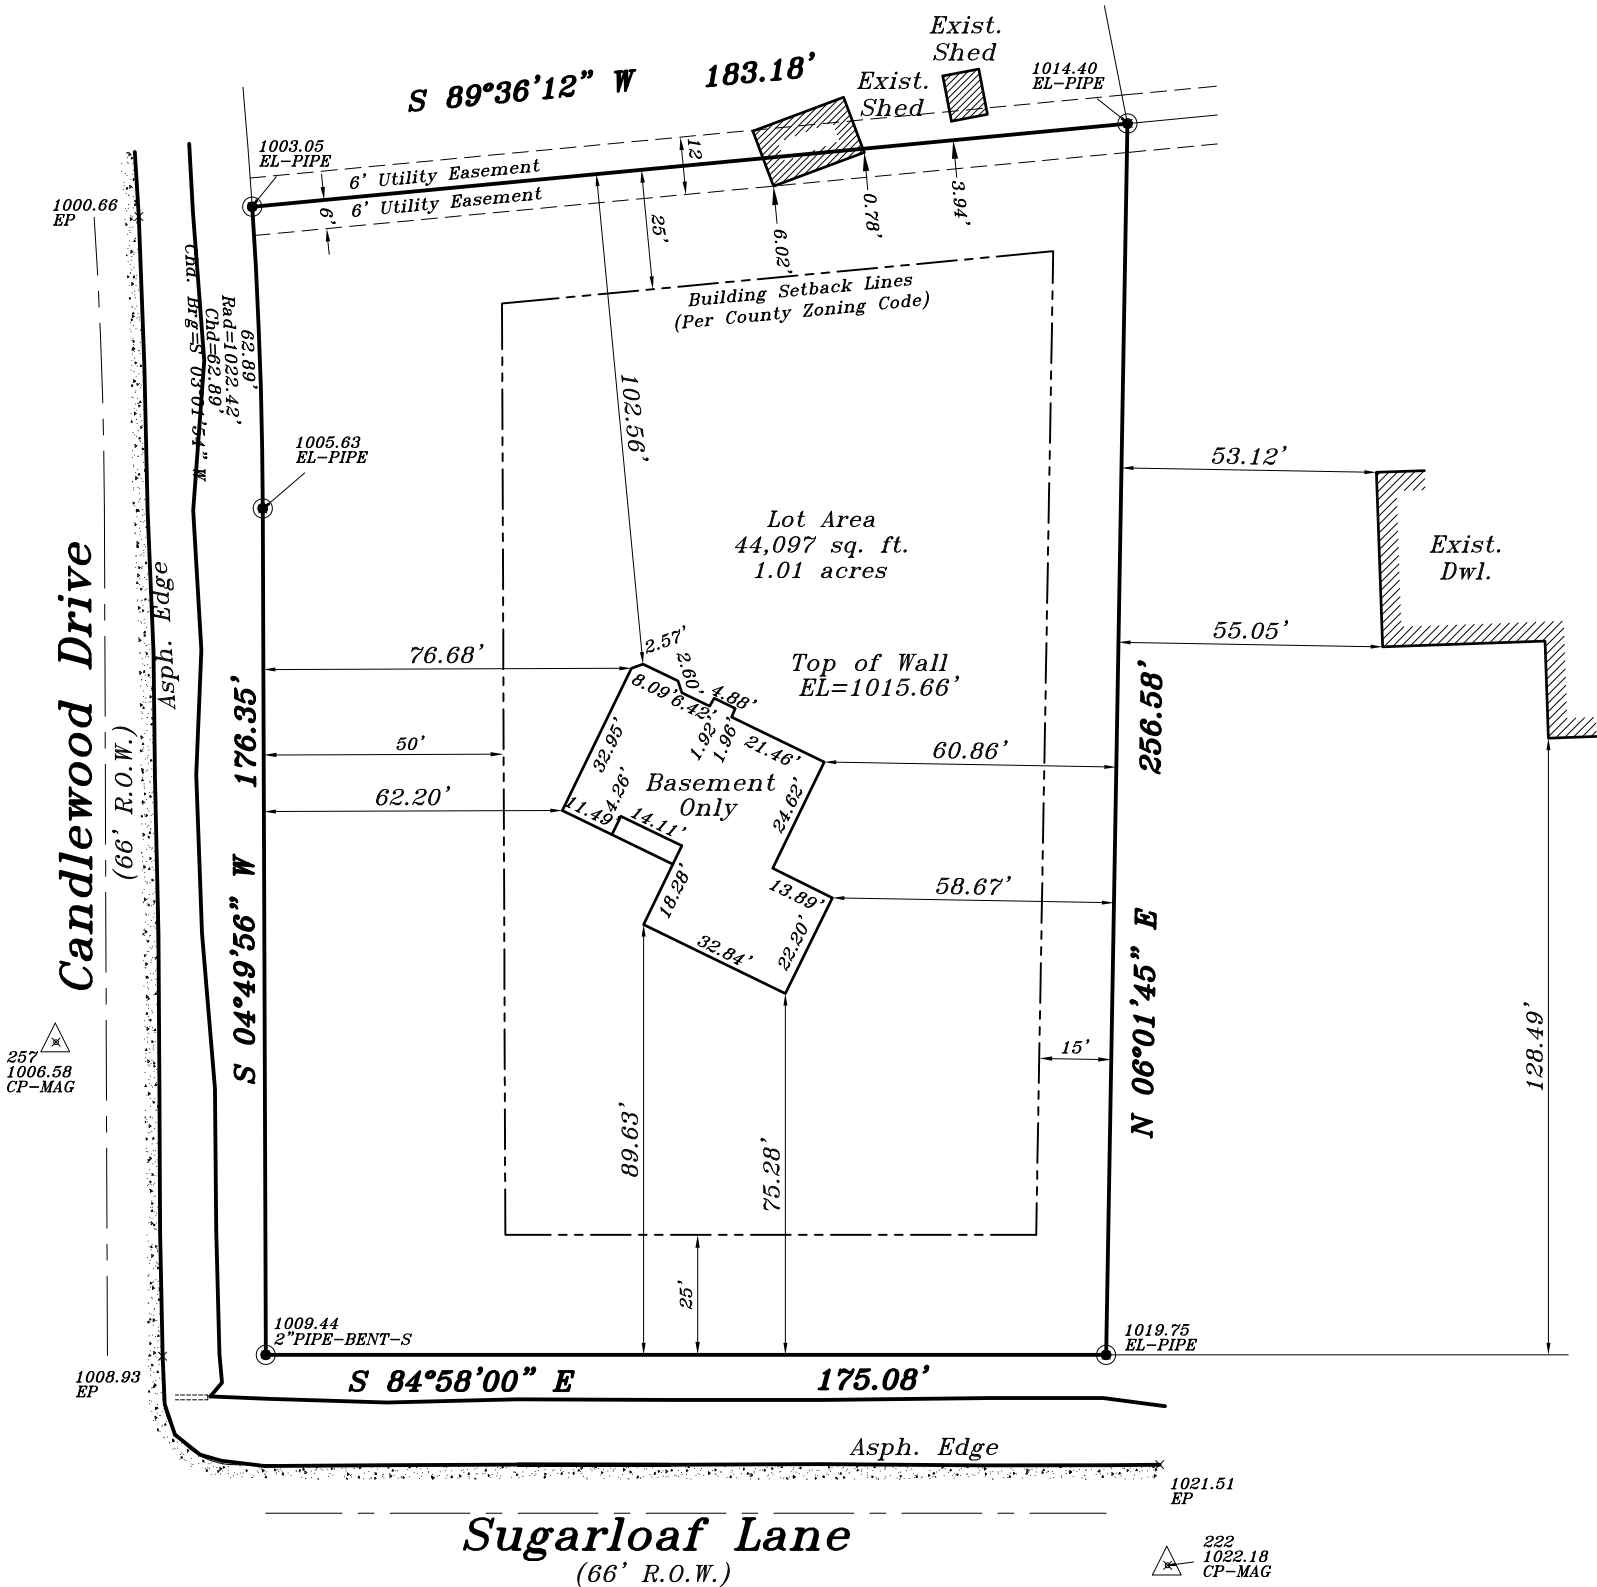

Prop.
Gar. Slab
1015.22

Prop. Fin.
Yd. Gr.
1014.89
(Per Builder)

Prop.
T.O.W.
1015.56

NOTE:
Boundary Based Upon
Plat of Survey by
Land-Mark Surveying,
Dated March 14, 2020

Proposed finished yard, 1st floor
or top of foundation grade shown
on this drawing is a suggested
grade and should be verified by
the owner, builder or municipality



**METROPOLITAN SURVEY
SERVICE, INC.**

PROFESSIONAL LAND SURVEYORS

9415 West Forest Home Avenue, Suite 202
Hales Corners, Wisconsin 53130
PH. (414) 529-5380
survey@metropolitansurvey.com
www.metropolitansurvey.com



- — Denotes Iron Pipe Found
- — Denotes Iron Pipe Set
- 000.0 — Denotes Proposed Grade

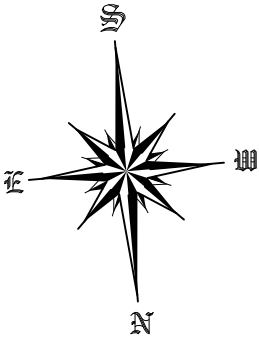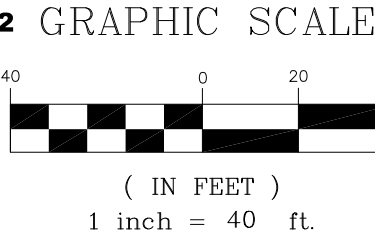

I HEREBY CERTIFY THAT I HAVE SURVEYED THE ABOVE DESCRIBED PROPERTY AND THAT THE ABOVE MAP IS A TRUE REPRESENTATION THEREOF AND SHOWS THE SIZE AND LOCATION OF THE PROPERTY. ITS EXTERIOR BOUNDARIES, THE LOCATION OF ALL VISIBLE STRUCTURES AND DIMENSIONS OF ALL PRINCIPAL BUILDINGS THEREON, BOUNDARY FENCES, APPARENT EASEMENTS AND ROADWAYS AND VISIBLE ENCROACHMENT, IF ANY.

THIS SURVEY IS MADE FOR THE EXCLUSIVE USE OF THE PRESENT OWNERS OF THE PROPERTY, AND ALSO THOSE WHO PURCHASE, MORTGAGE, OR GUARANTEE THE TITLE THERETO WITHIN ONE (1) YEAR FROM THE DATE HEREOF.

SIGNED

Dennis C. Sauer

Dennis C. Sauer
Professional Land Surveyor S-2421