


BOUNDARY SURVEY - ASBUILT SURVEY LOT 2 OF CERTIFIED SURVEY MAP NO. 4582

PART OF THE NE 1/4 OF SECTION 19, TOWN 1 NORTH, RANGE 17 EAST
TOWN OF LAFAYETTE, WALWORTH COUNTY, WISCONSIN

WISCONSIN STATE PLANE COORDINATE SYSTEM
NAD 83
WEST LINE OF THE NE 1/4 OF SECTION 19-3-17 BEARS N 2° 30' 13" W

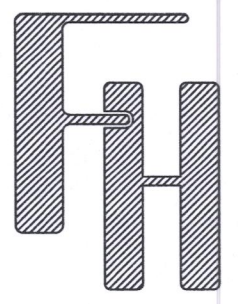


LOT 2 OF CSM 4582
AS-BUILT SURVEY
N5939 COBB ROAD
ELKHORN, WI 53121

WORK ORDERED BY -
DENNIS HODIK
W5436 WISCONSIN DRIVE
ELKHORN, WI 53121

FARRIS, HANSEN & ASSOCIATES, INC.
ENGINEERING - ARCHITECTURE - SURVEYING
7 RIDGWAY COURT P.O. BOX 437
ELKHORN, WISCONSIN 53121
OFFICE: (262) 723-2098 FAX: (262) 723-5886

REVISIONS

PROJECT NO.
10682
DATE
5/12/2022
SHEET NO.
1 OF 1

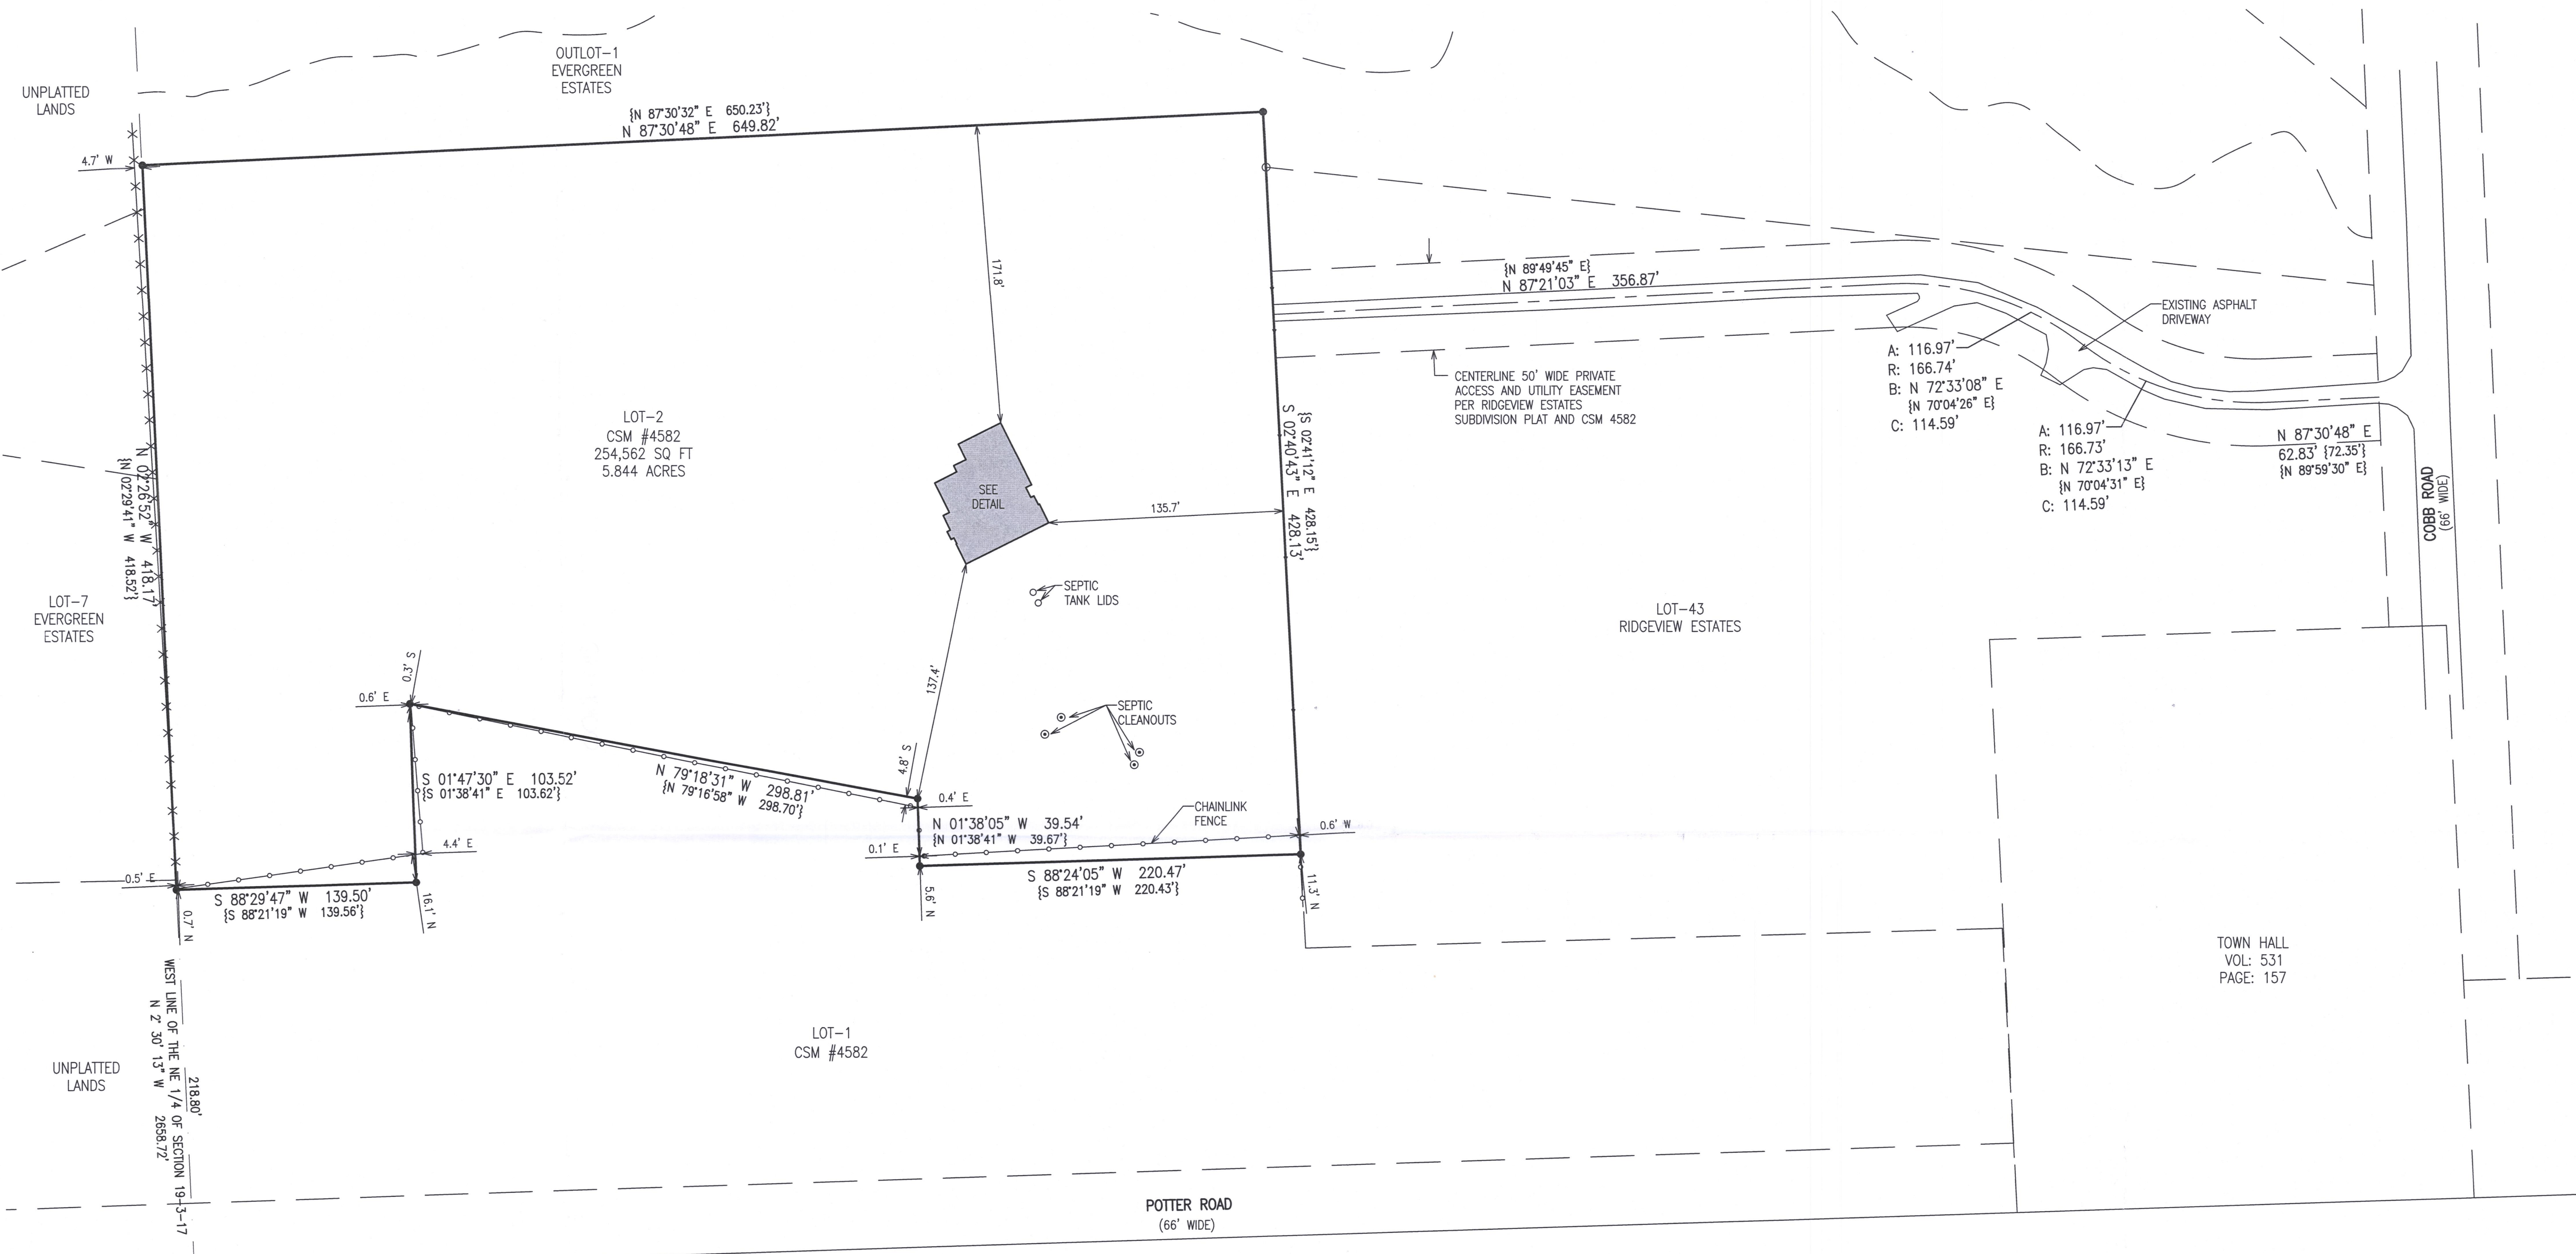

NOTE: COPIES OF THIS MAP TO WHICH THE FOLLOWING CERTIFICATE WILL APPLY SHOW THE SURVEYOR'S ORIGINAL SEAL AND SIGNATURE IN RED INK. COPIES BY ANY OTHER MEANS MAY HAVE ALTERATIONS WHICH DO NOT REPRESENT THE SURVEYOR'S WORK PRODUCT.

I HEREBY CERTIFY THAT THE ABOVE DESCRIBED PROPERTY HAS BEEN SURVEYED UNDER MY DIRECTION AND THAT THE ABOVE MAP IS A TRUE REPRESENTATION THEREOF AND SHOWS THE SIZE AND LOCATION OF THE PROPERTY AND ITS EXTERIOR BOUNDARIES. THIS SURVEY IS MADE FOR THE USE OF THE PRESENT OWNERS OF THE PROPERTY, AND ALSO THOSE WHO PURCHASE, MORTGAGE, OR GUARANTEE THE TITLE THERETO WITHIN ONE YEAR FROM THE DATE HEREOF.

DATED: 5/12/2022

CHRISTOPHER A. HODGES
P.L.S. 2760



X:\Projects\10682\ACAD\10682.dwg

KA 4582-2

5/7-1000