


# Plat of Survey

of


## Lot 27 of Evergreen Estates,

a subdivision located in the Southeast 1/4 of the Northwest 1/4 of Section 19, Town 3 North, Range 17 East, Town of LaFayette, Walworth County, Wisconsin.

Surveyed for: **Realty Executives Southeast**  
101 West Evergreen Parkway  
Elkhorn, Wisconsin. 53121

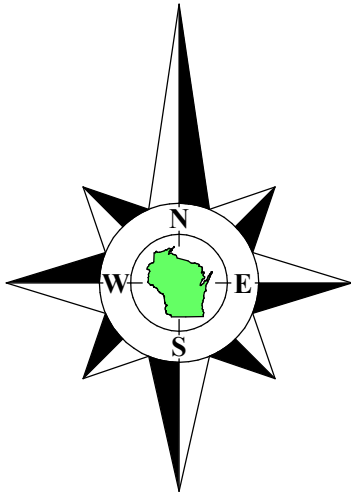

Bearings referenced to the West line of Lakeview Drive, recorded as North on the plat of Evergreen Estates.

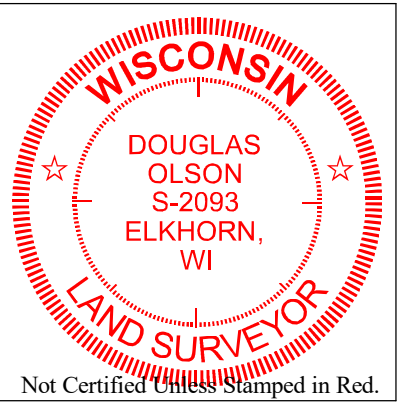

### Notes:

- 1) This Plat of Survey is not certified unless signed and sealed in red ink.
- 2) This survey is subject to Wisconsin lien laws. This Plat of Survey is the notice of intent to file lien. Lien waiver required.
- 3) The Survey Date shown on this Plat of Survey is the completion date of the field work.

Copyright ©2022 by Olson Land Surveying, LLC.


All rights reserved. No part of this survey plat may be reproduced or transmitted in any form by any means - graphic, electronic, or mechanical, including photocopying, tracing, or information storage and retrieval systems - without permission in writing from Douglas G. Olson, Olson Land Surveying, LLC.

I hereby certify that I have surveyed the above described property in compliance with Chapter A-E 7 of the Wisconsin Administrative Code and that the map hereon is correct to the best of my professional knowledge and belief and shows the size and location of the property, its exterior boundaries, the location and dimensions of all visible structures thereon, boundary fences, apparent easements and roadways and visible encroachments, if any.


This survey is made for the exclusive use of the present owners of the property, and also those who purchase, mortgage or guarantee title thereto, within one year from the date hereof.

Douglas G. Olson  
Wisconsin Professional Land Surveyor - 2093

Survey Date: August 16, 2022.  
Revisions:

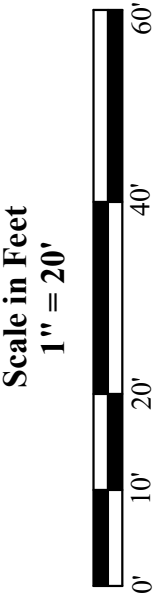

45 South Wisconsin Street | P.O. Box 322  
Elkhorn, Wisconsin. 53121  
Telephone: (262) 723-3434  
Facsimile: (262) 723-8044  
Email: doug@olsonsurveying.com  
Website: www.olsonsurveying.com

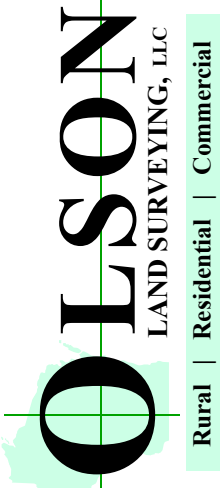

Legend of Symbols & Abbreviations	
Found Iron Pipe	North
Found Iron Rod	South
Found Iron Nail	East
Recorded Information	West
Utility Box or Pedestal	In Degrees
Concrete Cover	In Minutes
Septic Vent	In Feet
Asphalt Surface	In Inches
Concrete Surface	Brick Pavers
Stone or Brick Pavers	

Sheet 1 of 1 Sheets	Drawing Name:
Job Reference Number	2022.100
2022.100	