


NOTES:
1. UTILITY EASEMENTS SHOWN PER FINAL PLAT--NO TITLE POLICY PROVIDED
2. THIS SURVEY IS SUBJECT TO ALL RESTRICTIONS AND NOTES SHOWN ON THE SUGAR CREEK, WALWORTH COUNTY REGISTER OF DEEDS OFFICE.
3. PENALTY FOR DISTURBING LOT CORNER MONUMENTS \$250.00 OR UP TO 1 YEAR IMPRISONMENT PER SS. 236.32(2)
4. BENCHMARK OBTAINED FROM THE N 1/4 CORNER OF SECTION 23-3-17 = 1038.26'

PLAT OF SURVEY

BEING ALL OF LOT 40 SUGAR CREEK PRESERVE,
LOCATED IN THE NE 1/4 OF THE SW 1/4 OF SEC. 23 T.3N., R.17E.,
IN THE TOWN OF LAFAYETTE, WALWORTH COUNTY, WISCONSIN

SURVEYOR:
KEITH A. KINDRED, RLS S-2082
SEH
501 MAPLE AVE
DELAFIELD, WI 53018
(414) 949-8919
KKINDRED@SEHINC.COM

SURVEY FOR:
VICTORY COMPANIES
RE: JONAS
N118 W18531 BUNSEN DR.
GERMANTOWN, WI. 53022

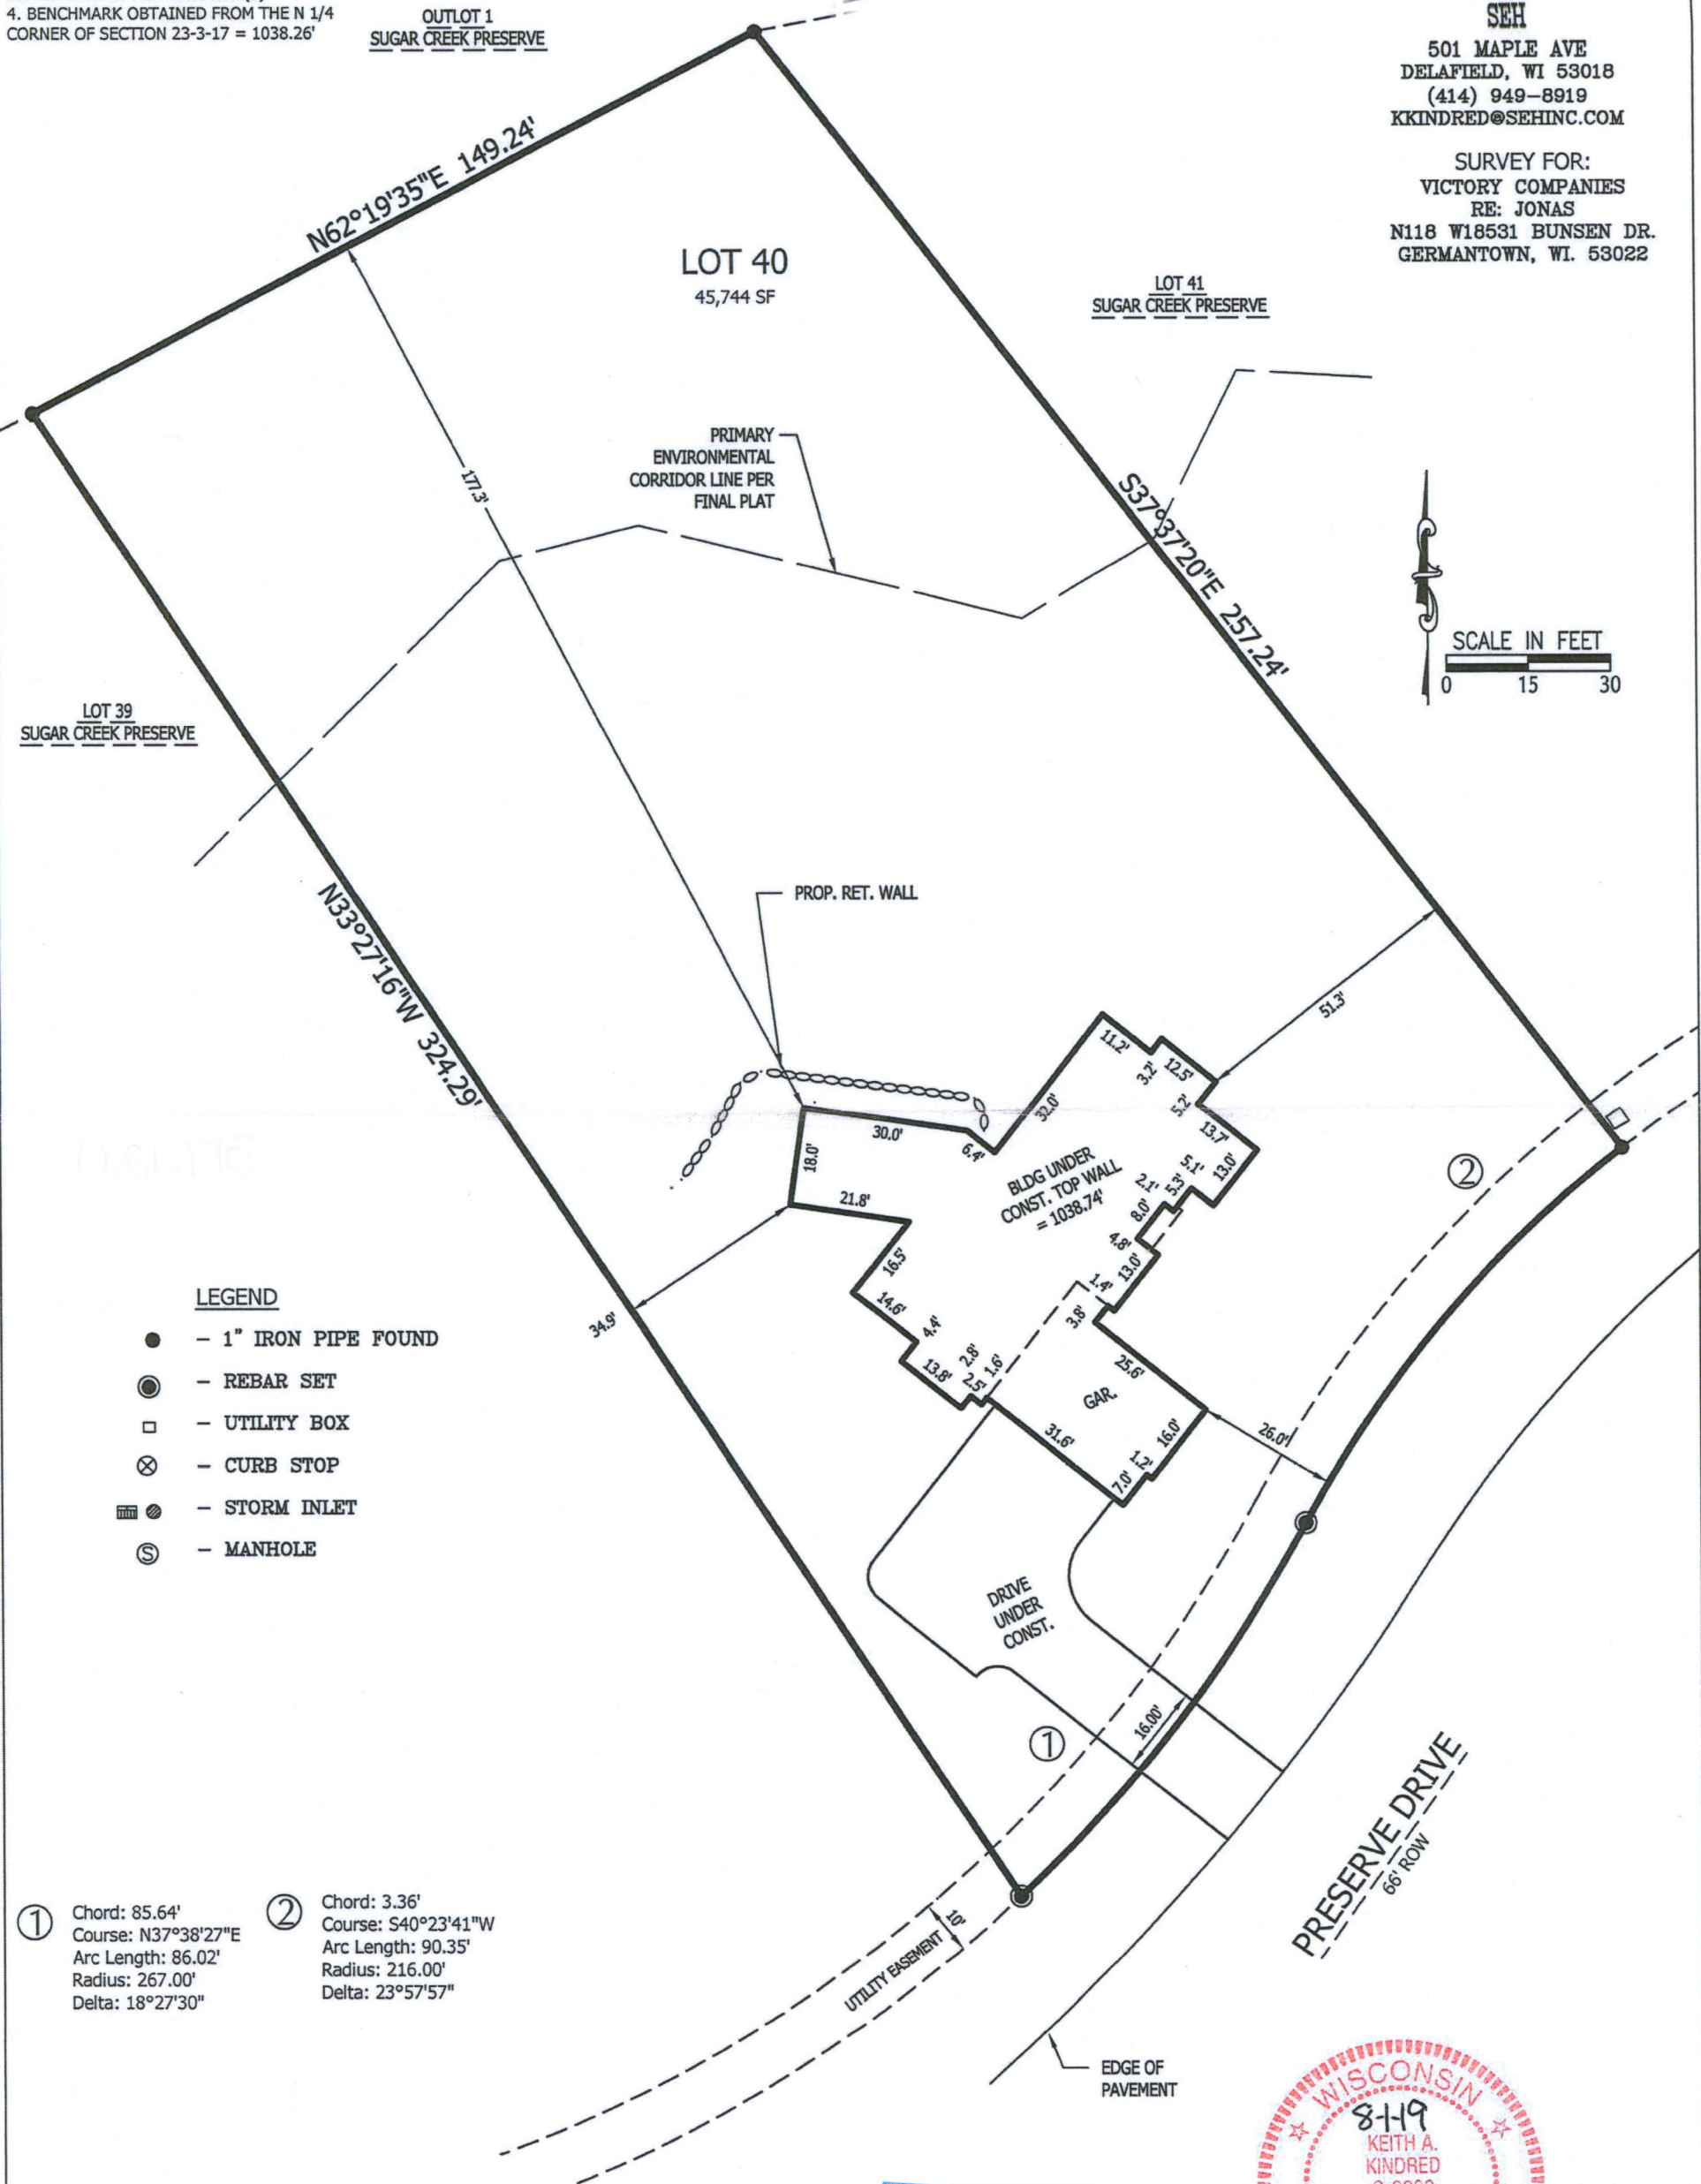


SURVEYOR'S CERTIFICATE:

I HEREBY CERTIFY THAT I HAVE SURVEYED THE ABOVE DESCRIBED PROPERTY AND THAT THE ABOVE MAP IS A TRUE REPRESENTATION THEREOF AND SHOWS THE SIZE AND LOCATION OF THE PROPERTY, ITS EXTERIOR BOUNDARIES, THE LOCATION OF ALL VISIBLE STRUCTURES AND DIMENSIONS OF ALL PRINCIPAL BUILDINGS THEREON, BOUNDARY FENCES, APPARENT EASEMENTS, ROADWAYS, AND VISIBLE ENCROACHMENTS, IF ANY.

THIS SURVEY IS MADE FOR THE USE OF THE PRESENT OWNERS OF THE PROPERTY, AND ALSO THOSE WHO PURCHASE, MORTGAGE, OR GUARANTEE THE TITLE THERETO WITHIN ONE (1) YEAR FROM DATE HEREOF.

SEH 501 MAPLE AVE., DELAFIELD, WI 53018 262-646-6855

PATH: Q:\UZ\W\ICCO\149939\9-SURVEY\92-CAD\10-C3D\WICCO_149939_JONAS_REVISD 5-6-2019.DWG

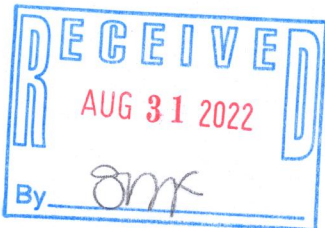

KOCP-40

317-1211