


PLAT OF SURVEY
OF LOT 84 OF EVERGREEN ESTATES SUBDIVISION LOCATED IN THE
S.W. $\frac{1}{4}$ OF SECTION 18, T3N, R17E, WALWORTH COUNTY, WISCONSIN


JENSEN SURVEYING & MAPPING S.C.
P.O. Box 322
Elkhorn, WI. - 53121
(414) 723-3434

SURVEYED FOR: Ruthann Sterwald
108 Fox St.
Mu kwonago, WI.-53149

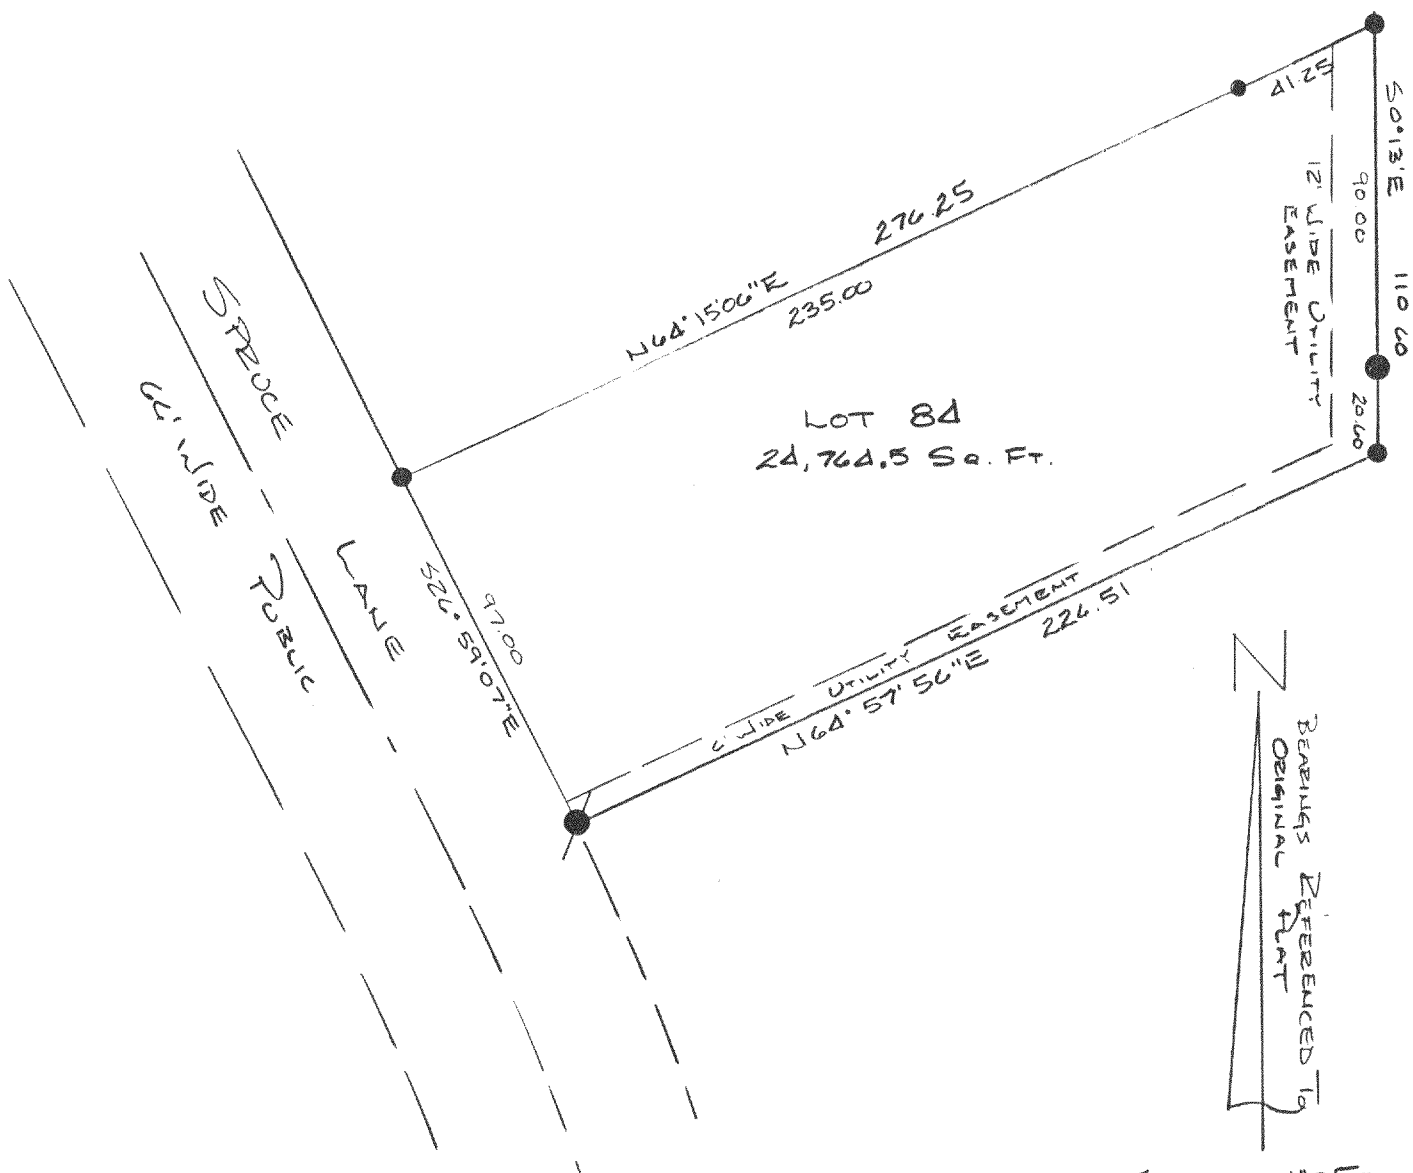


SCALE ~ 1" = 50

- 1" IRON PIPE FOUND
- 2" IRON PIPE FOUND
- 1/4" IRON ROD FOUND

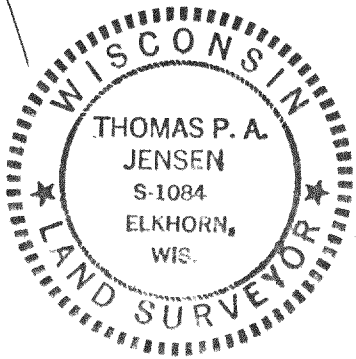

I, Thomas P.A. Jensen, Wisconsin Registered Land Surveyor, do hereby certify that this survey was performed by me, or under my direction in full compliance with the owner's / agent's instruction and chapter A-E 5 of the Wisconsin Administrative Code " Minimum Standards for Property Surveys"; and that this map is an accurate representation thereof to the best of my knowledge and belief.

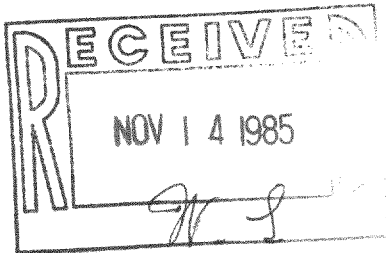

and belief.
Thomas P. Jensen
 Thomas P. Jensen R.L.S. #1084
 MAPPING DATE - 9-3-85

217-122