
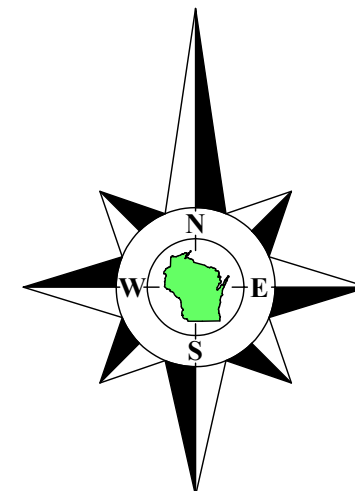


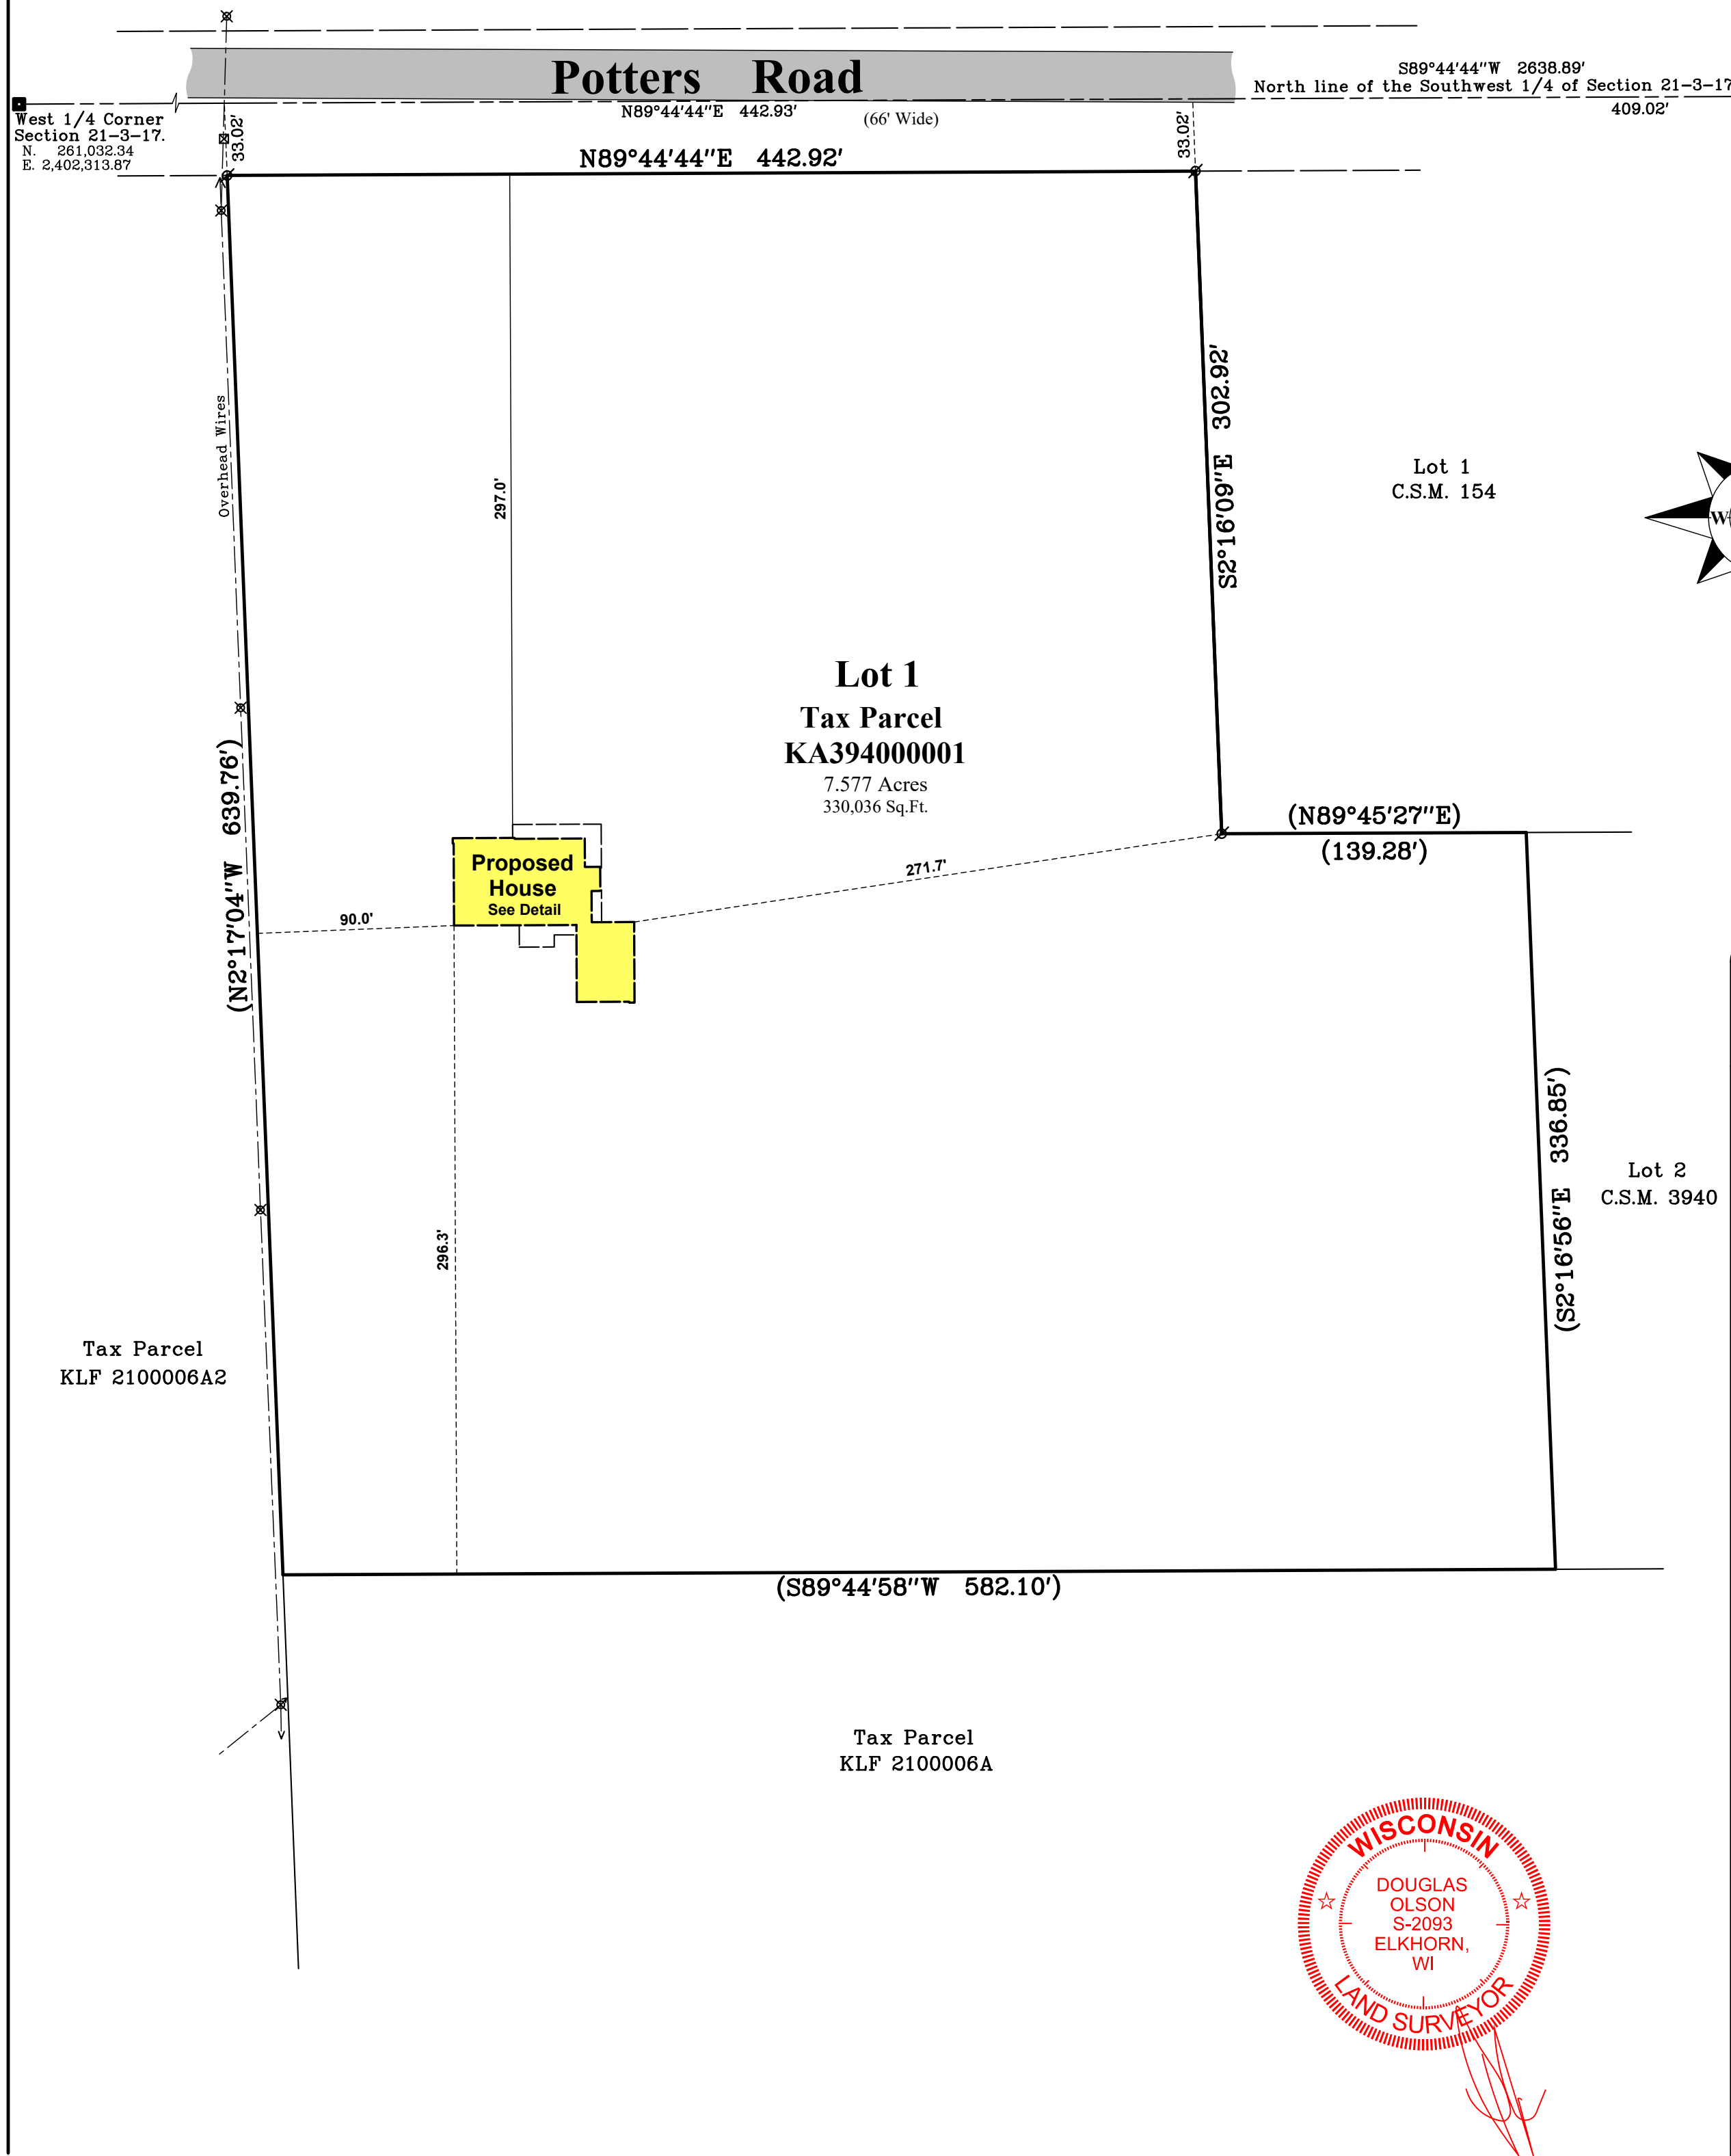

Bearings reference to the Wisconsin State Plane Coordinate System, South Zone.

Property Exhibit

of


Lot 1 of Certified Survey Map No. 3940,

recorded May 26, 2006 in Vol. 24 of Certified Survey Maps of Walworth County on Page 124 as Document Number 677562 and located in the Northeast 1/4 of the Southwest 1/4 of Section 21, Town 3 North, Range 17 East, Town of LaFayette, Walworth County, Wisconsin.

Prepared for:


Kerkman Bros. Construction Co., Inc.

P.O. Box 923
New Munster, Wisconsin. 53152

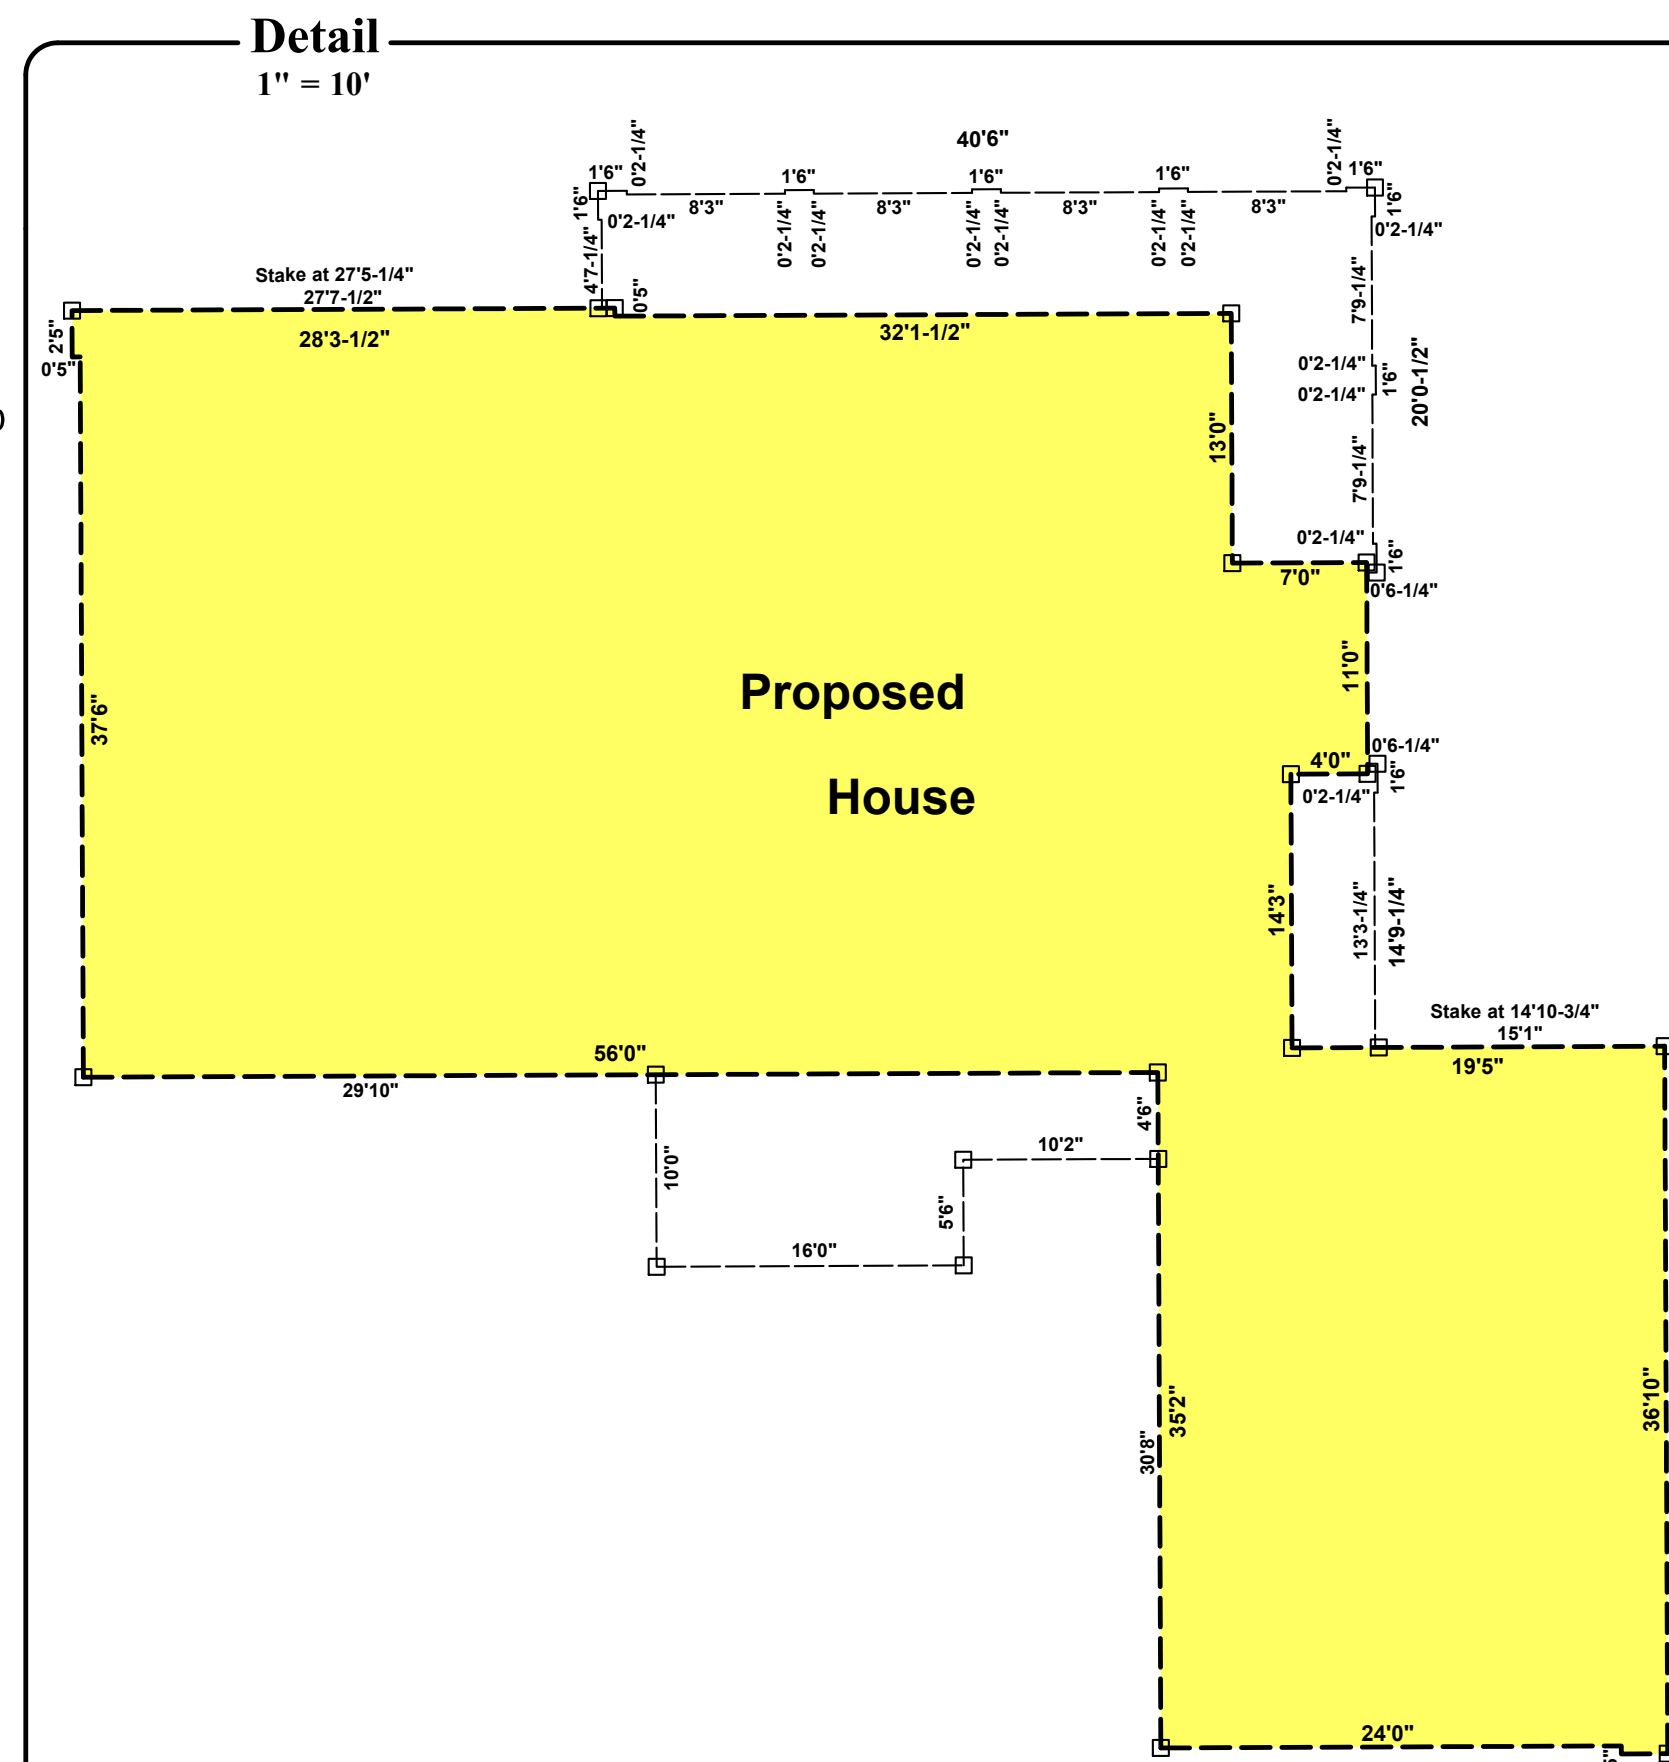


Survey Date: May 13, 2025.

Revisions:

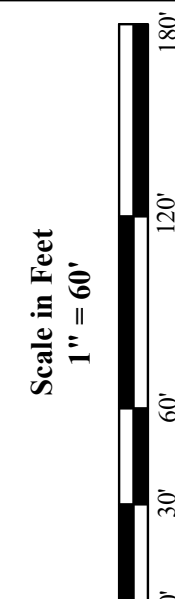

45 South Wisconsin Street | P.O. Box 322
Elkhorn, Wisconsin. 53121
Telephone: (262) 723-3434
Facsimile: (262) 723-8044
Email: doug@olsonsurveying.com
Website: www.olsonsurveying.com

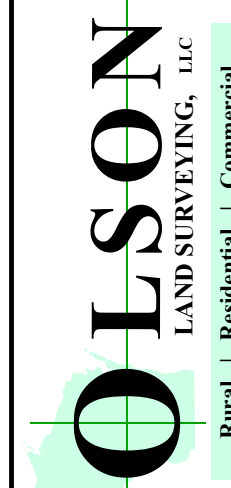

Rural | Residential | Commercial

Legend		N North	
■	Found County Section Corner	S South	E East
○	Found Iron Pipe	W West	
□	Set Wood Stake		In Bearings
○	Recorded Information	°	Degrees
○	Utility Pole	'	Minutes
■	Asphalt Surface	"	Seconds
		In	Distances
		"	Feet
		"	Inches

Sheet 1 of 1 Sheets

Drawing Name:

2025.052

2025.052