


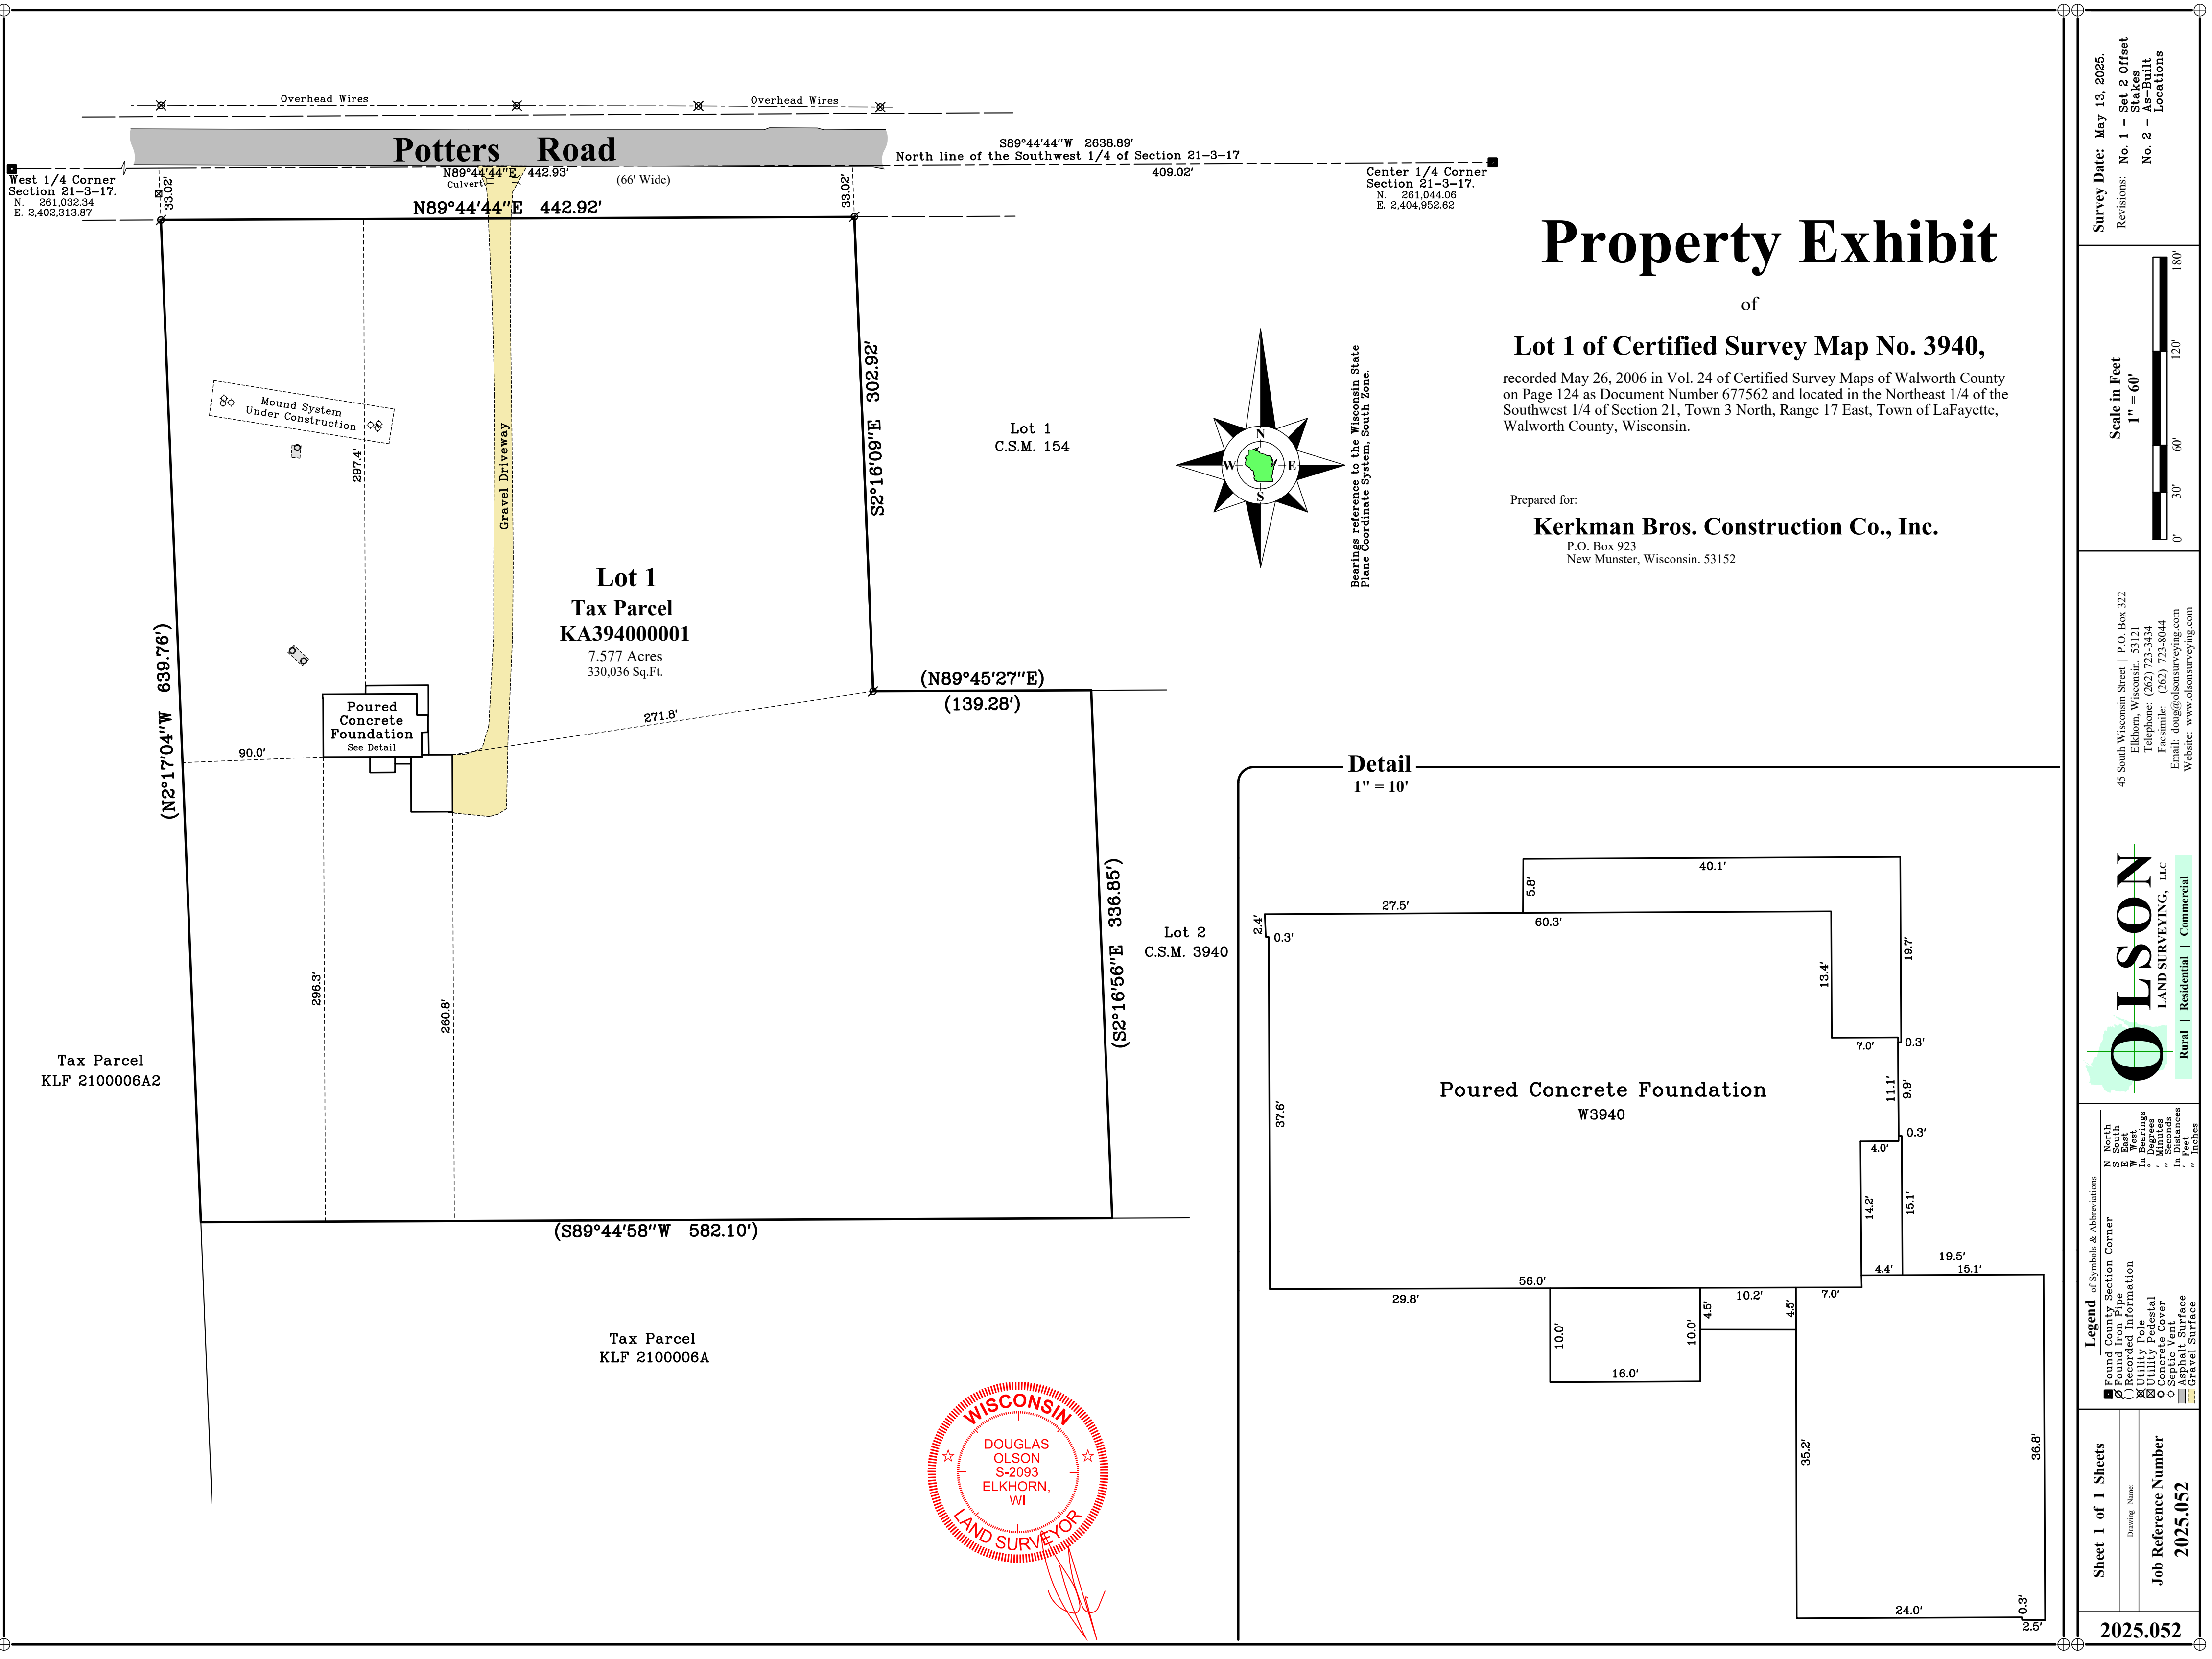


Property Exhibit

Lot 1 of Certified Survey Map No. 3940,

recorded May 26, 2006 in Vol. 24 of Certified Survey Maps of Walworth County on Page 124 as Document Number 677562 and located in the Northeast 1/4 of the Southwest 1/4 of Section 21, Town 3 North, Range 17 East, Town of LaFayette, Walworth County, Wisconsin.

Prepared for:

Kerkman Bros. Construction Co., Inc.
P.O. Box 923
New Munster, Wisconsin. 53152

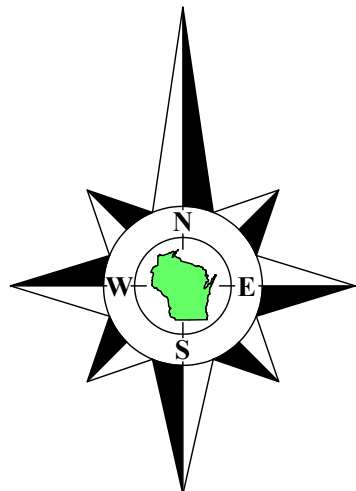

Bearings reference to the Wisconsin State Plane Coordinate System, South Zone.

Survey Date: May 13, 2025.
Revisions:
No. 1 – Set 2 Offset
Stakes
As-Built
No. 2 – Locations

Scale in Feet
1" = 60'
0' 30' 60' 120' 180'

45 South Wisconsin Street | P.O. Box 322
Elkhorn, Wisconsin. 53121
Telephone: (262) 723-3434
Facsimile: (262) 723-8044
Email: doug@olsonsurveying.com
Website: www.olsonsurveying.com

Rural | Residential | Commercial

Legend of Symbols & Abbreviations

Found Country Section Corner

Found Iron Pipe

Recorded Information

Utility Pole

Concrete Pedestal

Concrete Cover

Asphalt Surface

Gravel Surface

N North

S South

E East

W West

In Bearings

In Degrees

" Seconds

In Distances

" Feet

" Inches

Sheet 1 of 1 Sheets

Drawing Name:

Job Reference Number

2025.052

2025.052