
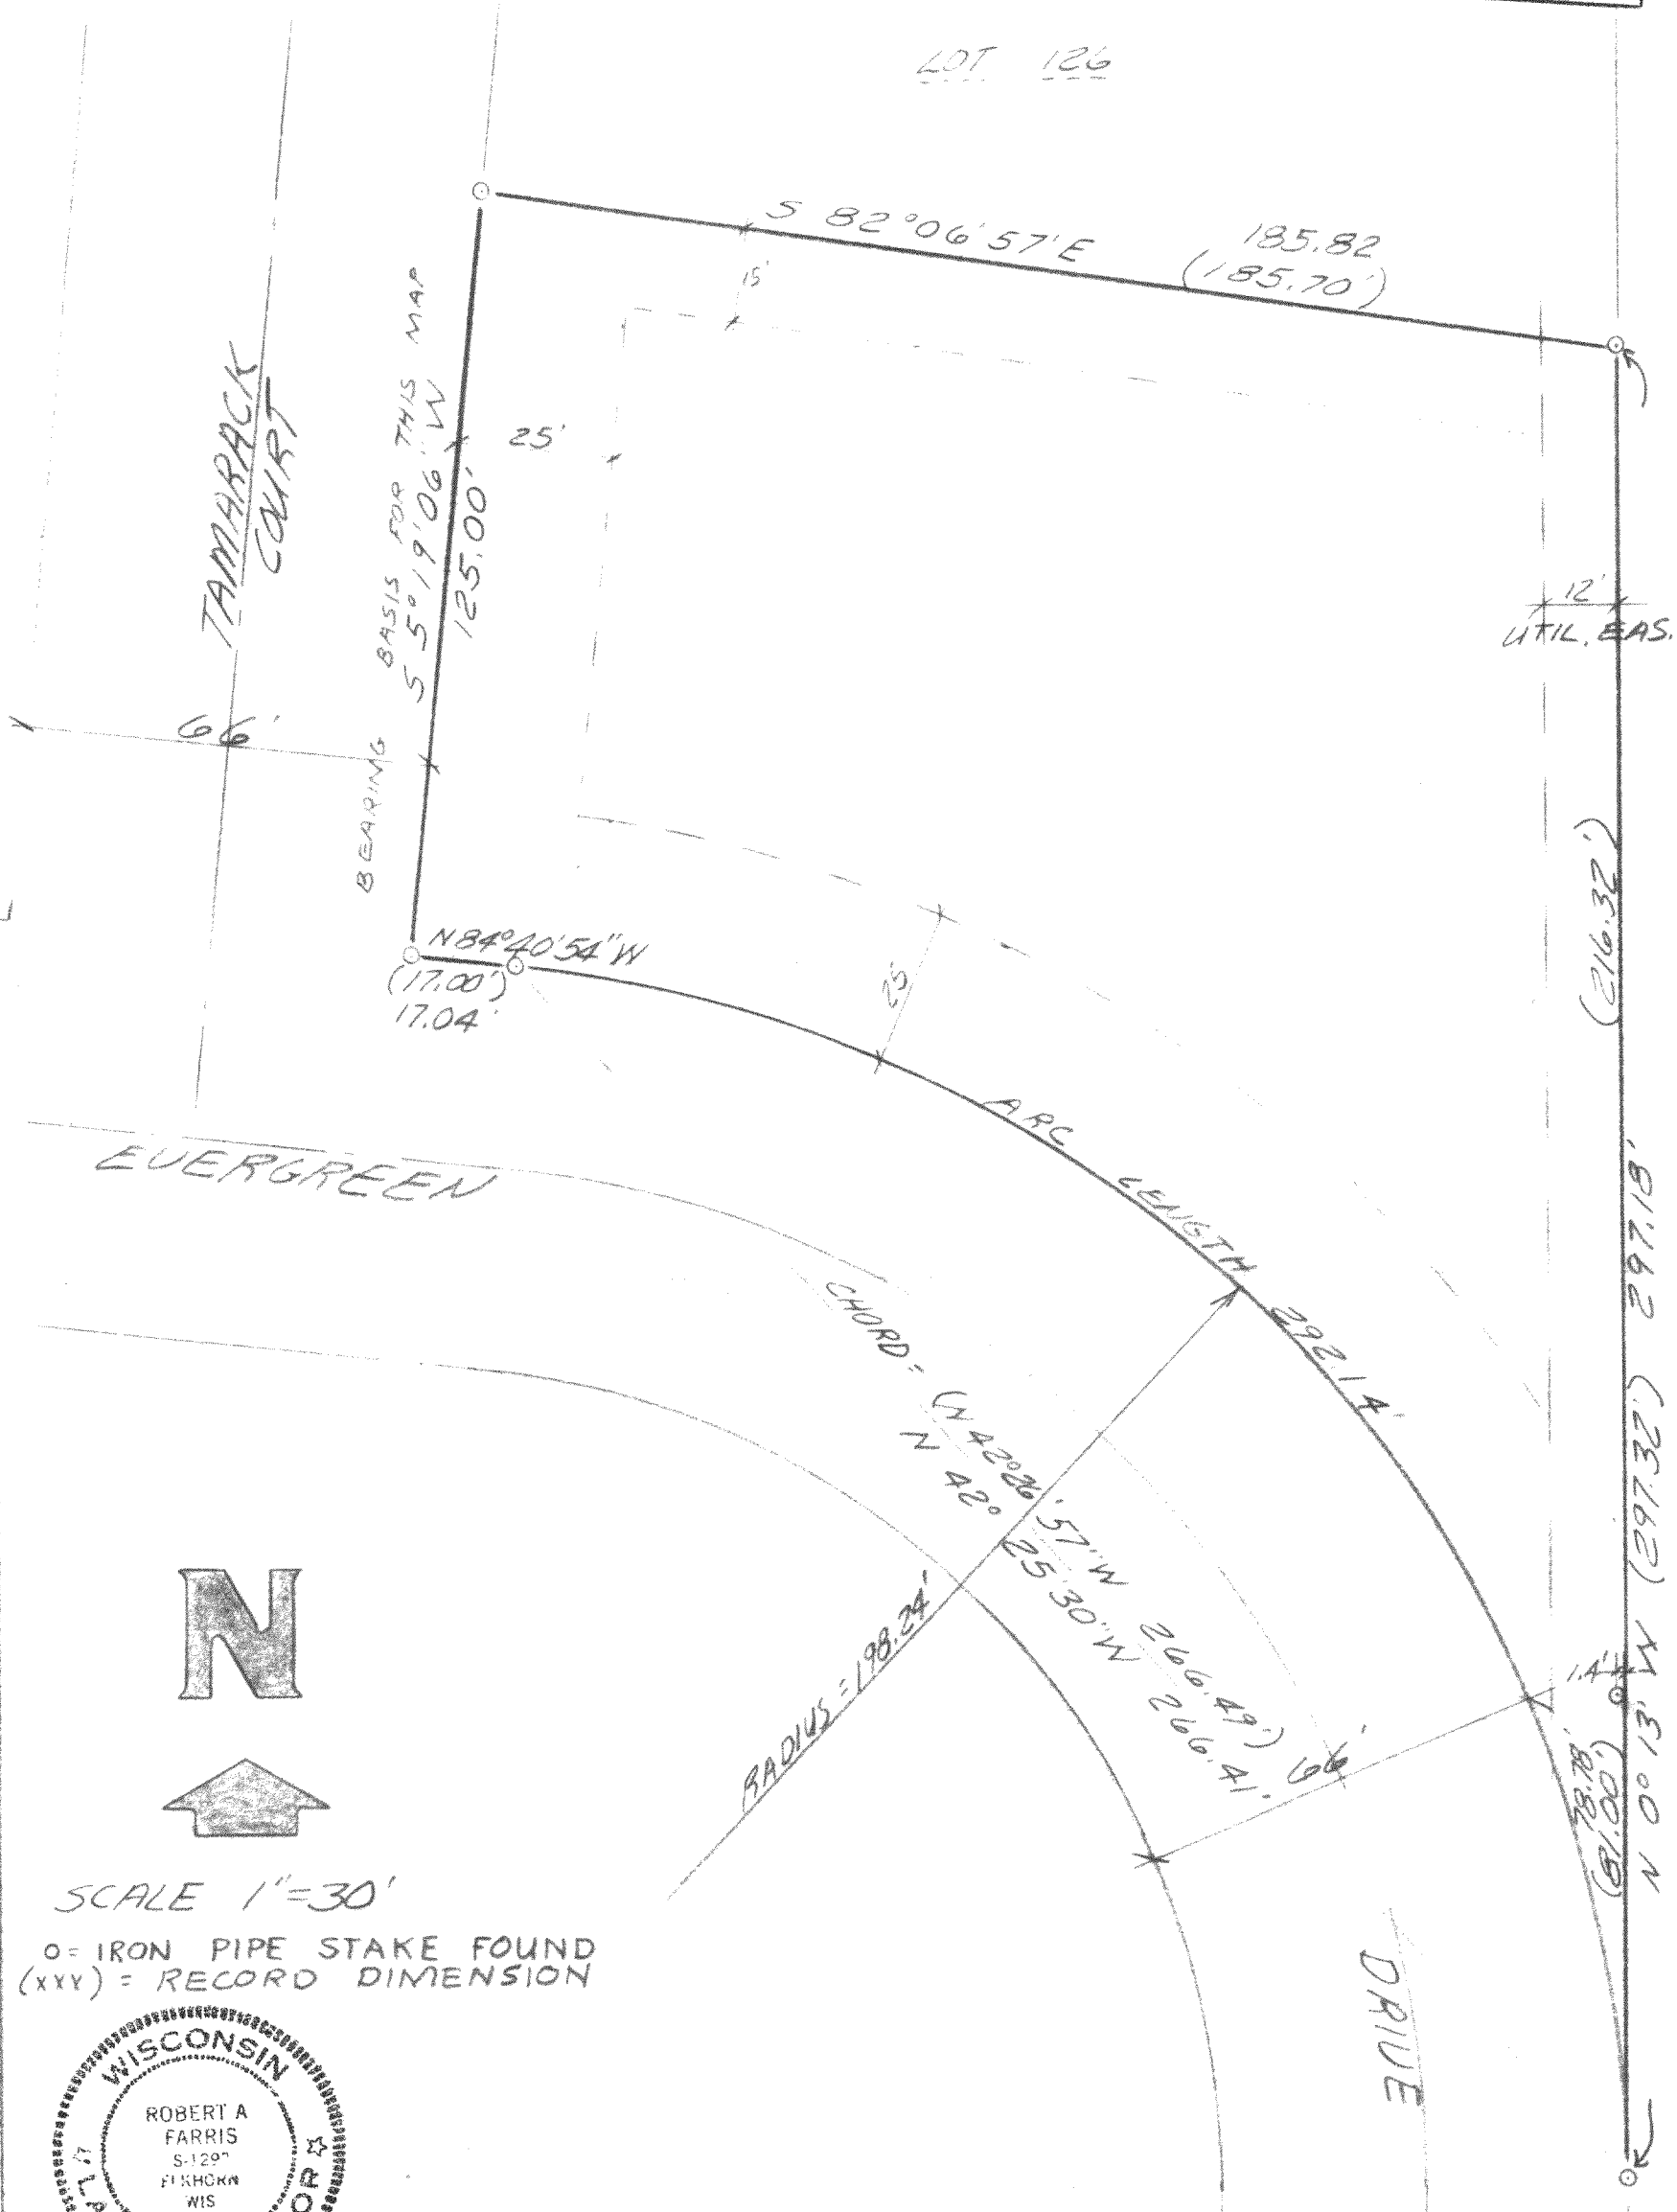
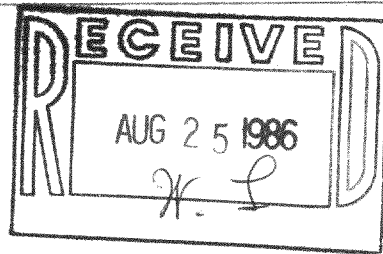


SCALE 1"=30'

O = IRON PIPE STAKE FOUND
(XXY) = RECORD DIMENSION

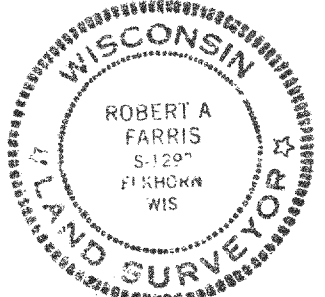

PLAT OF SURVEY
LOT 127 EVERGREEN ESTATES
LOCATED IN SW 1/4 18-3-17 WALWORTH CO., WI.
FOR
ERSKINE CONSTRUCTION

I HEREBY CERTIFY THIS PLAT TO BE A TRUE REPRESENTATION
OF THE BOUNDARY LINES FOUND TO BE MONUMENTED TO
THE BEST OF MY KNOWLEDGE & BELIEF.

Robert A. Farris
DATED AUG. 7, 1986

FARRIS, HANSEN & ASSOCIATES, INC.
7 Ridgeway Court - P.O. Box 487
Elkhorn, Wisconsin
414-723-2098

PROJ. # 2638