

Plat of Survey



~of~

Lot 75 of Evergreen Estates a Subdivision located in the S.W. 1/4 of the NW 1/4 and the SW 1/4 of the SW 1/4 and the NW 1/4 of the S.W. 1/4 and the NE 1/4 of the S.W. 1/4 and the SE 1/4 of the SW 1/4 of Section 18, and the SW 1/4 of the N.W. 1/4 and the NW 1/4 of the NW 1/4 and the NE 1/4 of the NW 1/4 and the SE 1/4 of the NW 1/4 and the NW 1/4 of the NE 1/4 of Sec 19, T3N, R17E, Town of Lafayette, Walworth County, Wisconsin.



Lot 76

Surveyed By: Jensen Surveying & Mapping S.C.
45 S. Wis. St. P.O. Box 302
Elkhorn, WI. 53121

Surveyed For: Colony Realty
16 E. Walworth
Elkhorn, WI. 53121

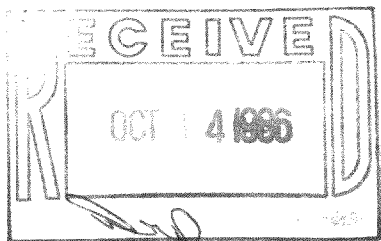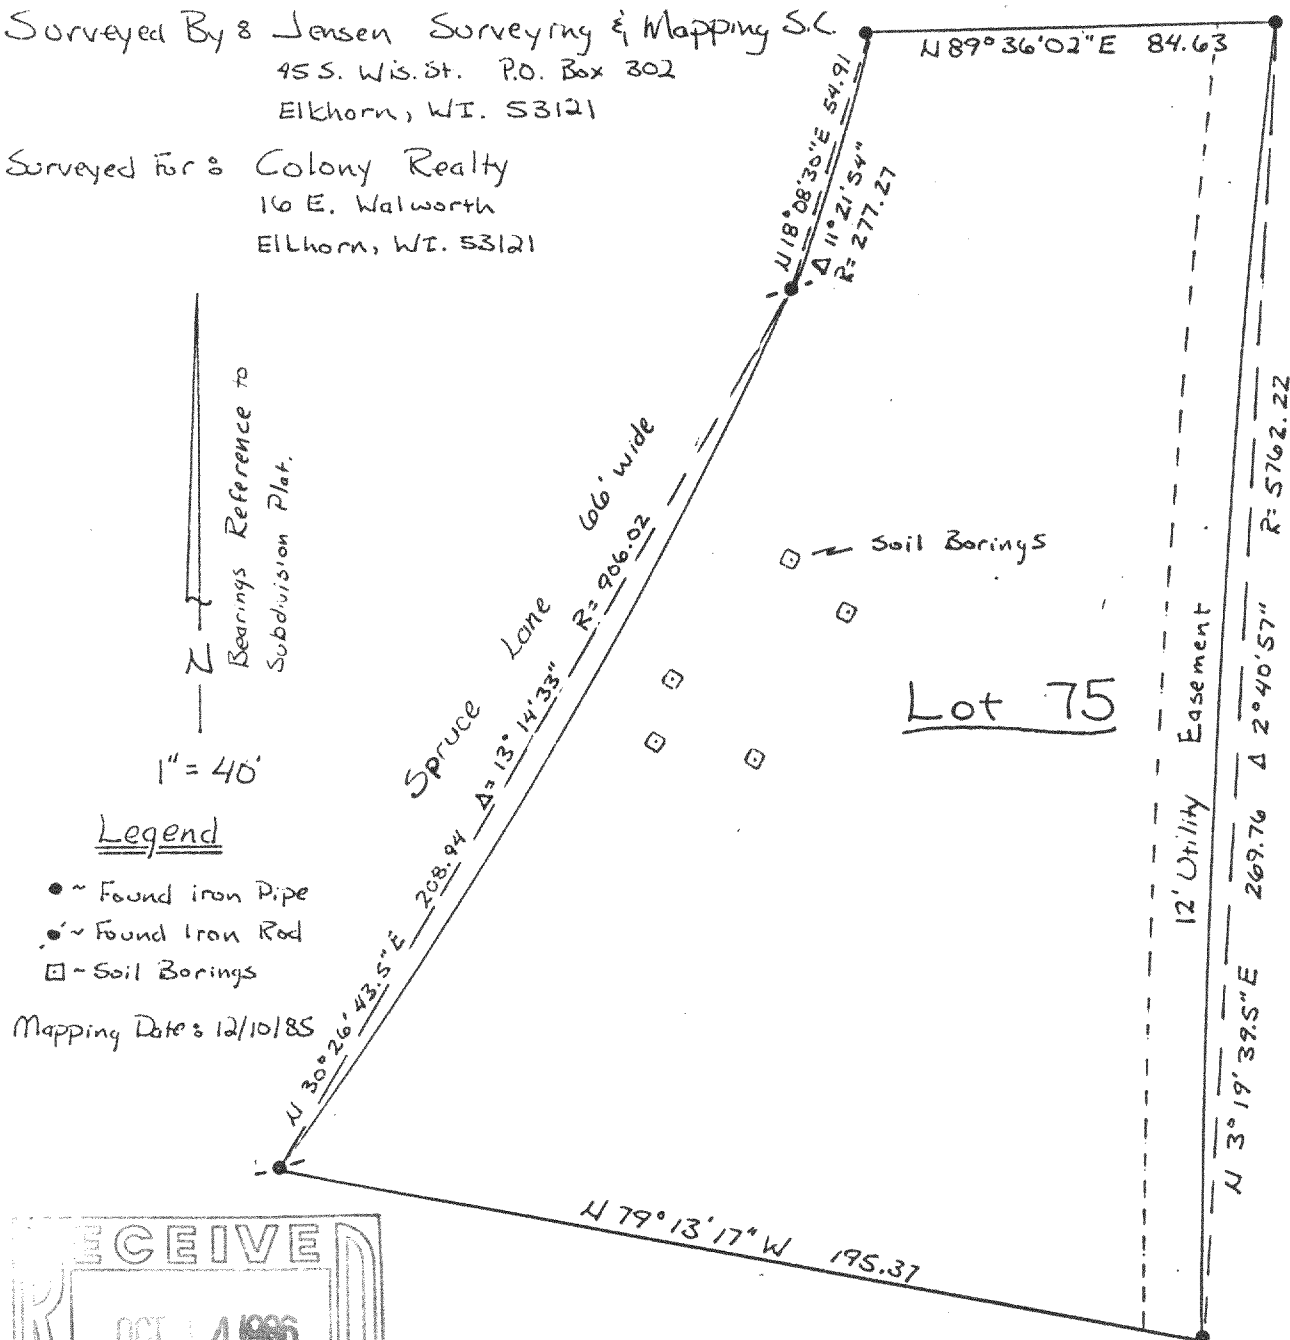

I, Thomas P.A. Jensen, Wisconsin Registered Land Surveyor, do hereby certify that this survey was performed by me, or under my direction, in full compliance with the owner's/agent's instructions and chapter A-E 5 of the Wisconsin Administrative Code "Minimum Standards For Property Surveys"; and that this map is an accurate representation thereof to the best of my knowledge and belief.

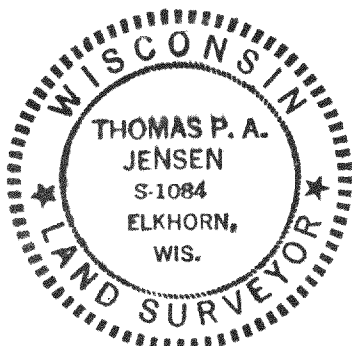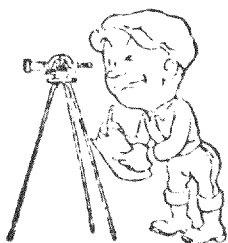

Thomas P.A. Jensen
Thomas P.A. Jensen S-1084
Jensen Surveying & Mapping S.C.
45 S. Wisconsin St.
Elkhorn, Wisconsin. 53121
(414) 723-3434