


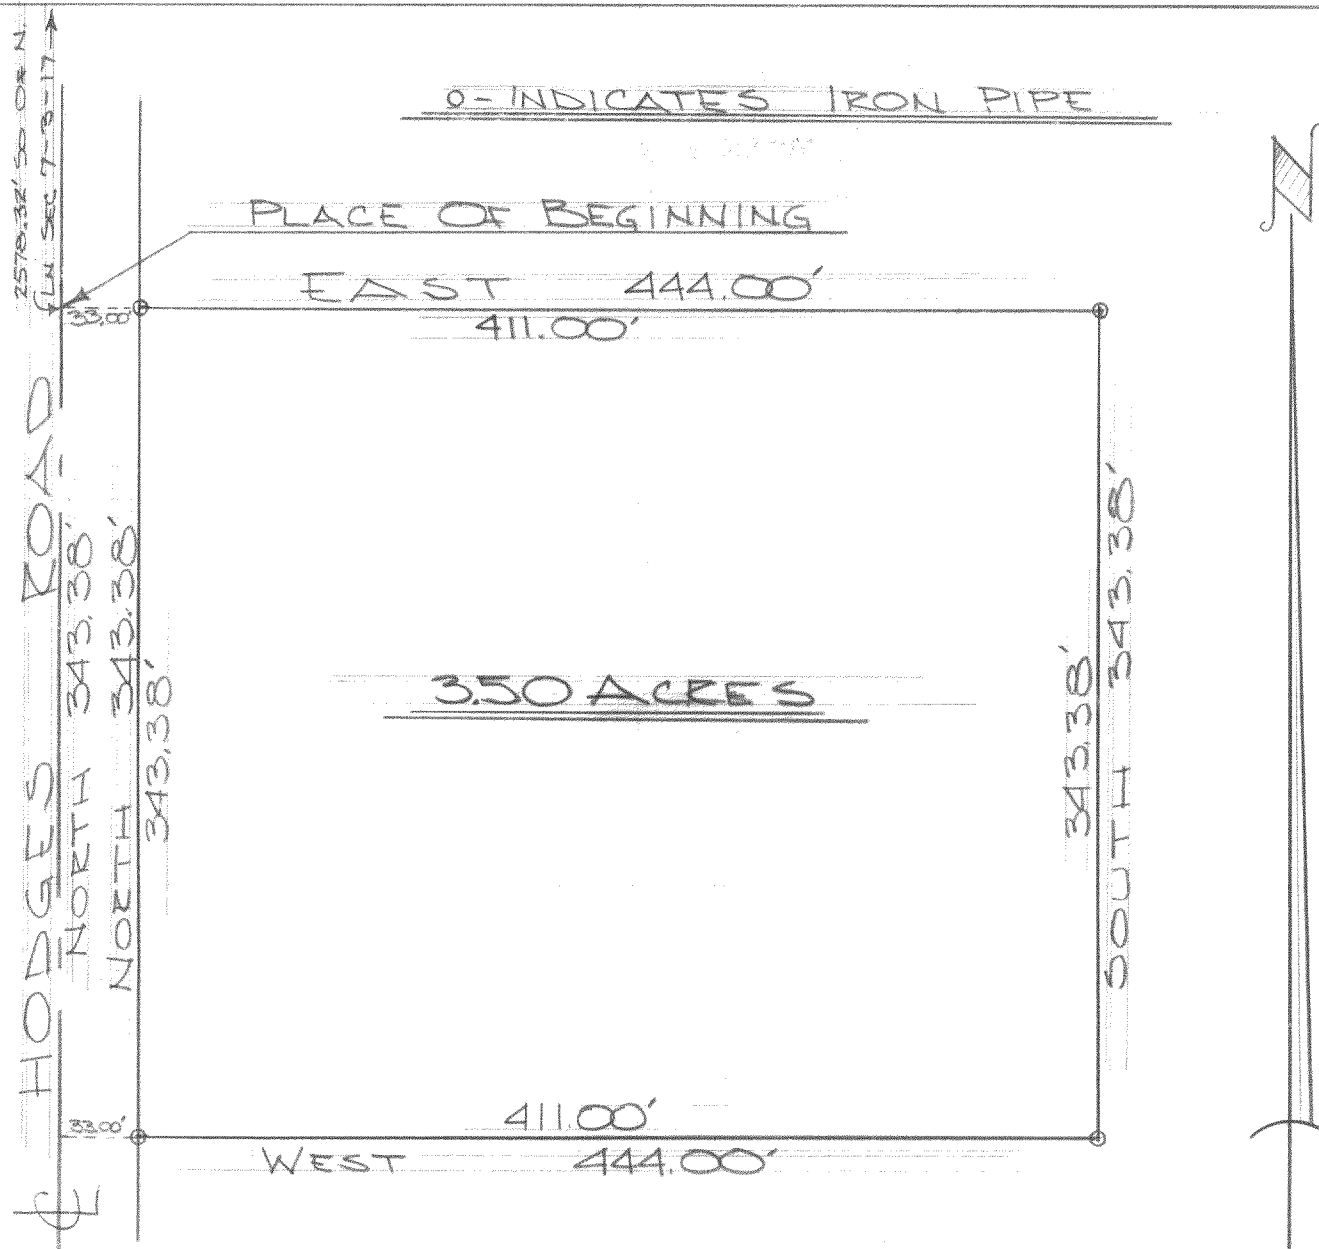


DESCRIPTION: Commencing at a point in the center line of Hodges Road, that is 2578.32 feet South of the point of intersection of said center line and the North line of Section 7, T. 3 N., R. 17 E. Walworth County, Wisconsin; thence East 444.00 feet to an iron pipe, thence South ~~parallel to the center line of Hodges Road~~ 343.38 feet to an iron pipe, thence West 444.00 feet to a point in the center line of said Road, thence North along the center line of Hodges Road 343.38 feet to the place of beginning.

CERTIFICATE: I, James F. Biagi, surveyor do hereby certify that I have surveyed the property hereon described.

June 30, 1967.

James F. Biagi, RLS 272

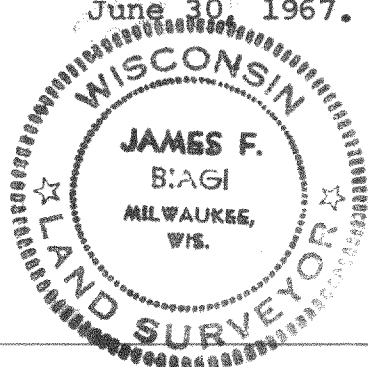

LF-7-5D

317-BB