


OF LOT 84 OF EVERGREEN ESTATES SUBDIVISION LOCATED IN THE
S.W. 1/4 OF SECTION 18, T3N, R17E, WALWORTH COUNTY, WISCONSIN

JENSEN SURVEYING & MAPPING S.C.
P.O. Box 322
Elkhorn, WI. - 53121
(414) 723-3434



SURVEYED FOR: Ruthann Sterwald
108 Fox St.
Mu kwonago, WI.-53149

*SURVEYED FOR: R. Breitling
3426 So. 26th
MIL. WIS. 53215*

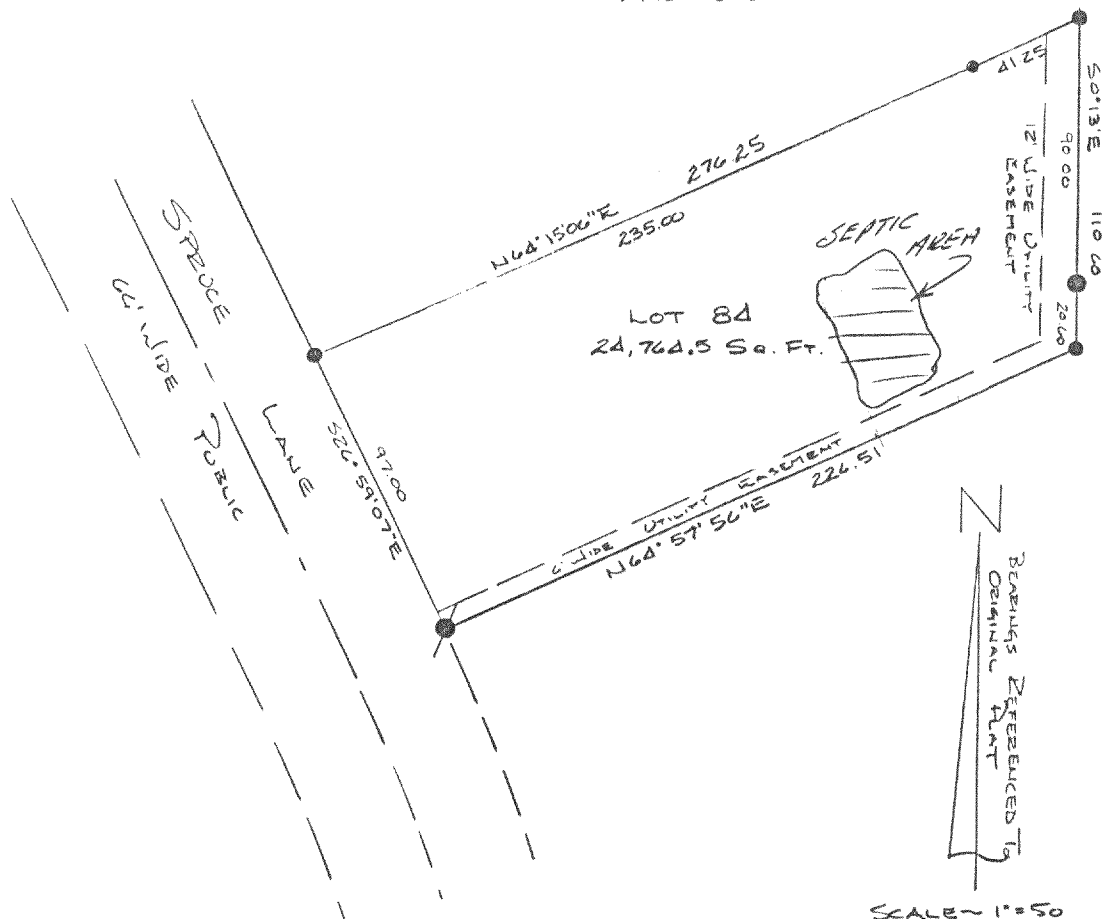

SCALE - 1" = 50'

- 1" IRON PIPE FOUND
- 2" IRON PIPE FOUND
- 1/4" IRON ROD FOUND

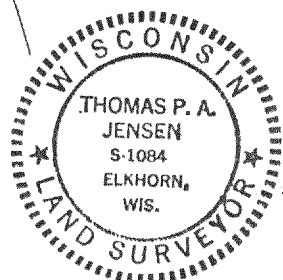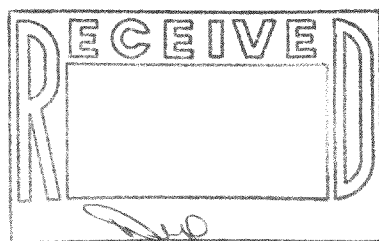

I, Thomas P.A. Jensen, Wisconsin Registered Land Surveyor, do hereby certify that this survey was performed by me, or under my direction in full compliance with the owner's / agent's instruction and chapter A-E 5 of the Wisconsin Administrative Code "Minimum Standards for Property Surveys"; and that this map is an accurate representation thereof to the best of my knowledge and belief.

Thomas P.A. Jensen
Thomas P.A. Jensen R.L.S. #1084
Mapping Date - 9-3-85
REVISED 5-1-87

1985076X

317-148