



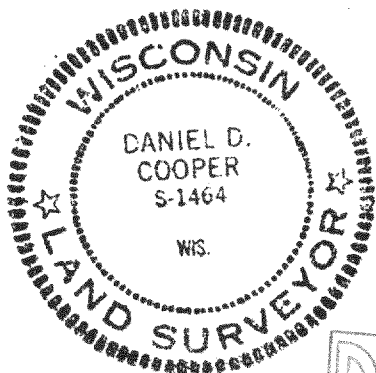

D Cooper & CO., INC
Rt 4 Box 508B * Elkhorn WI 53121


Plat of Survey of Lot 125 Evergreen Estates Subdivision
located in the Town of Lafayette, Walworth County, WI

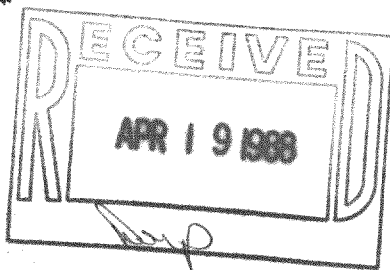

SCALE 1"=40'

LOT - 125

Survey ordered by - TLC Realty
Elkhorn

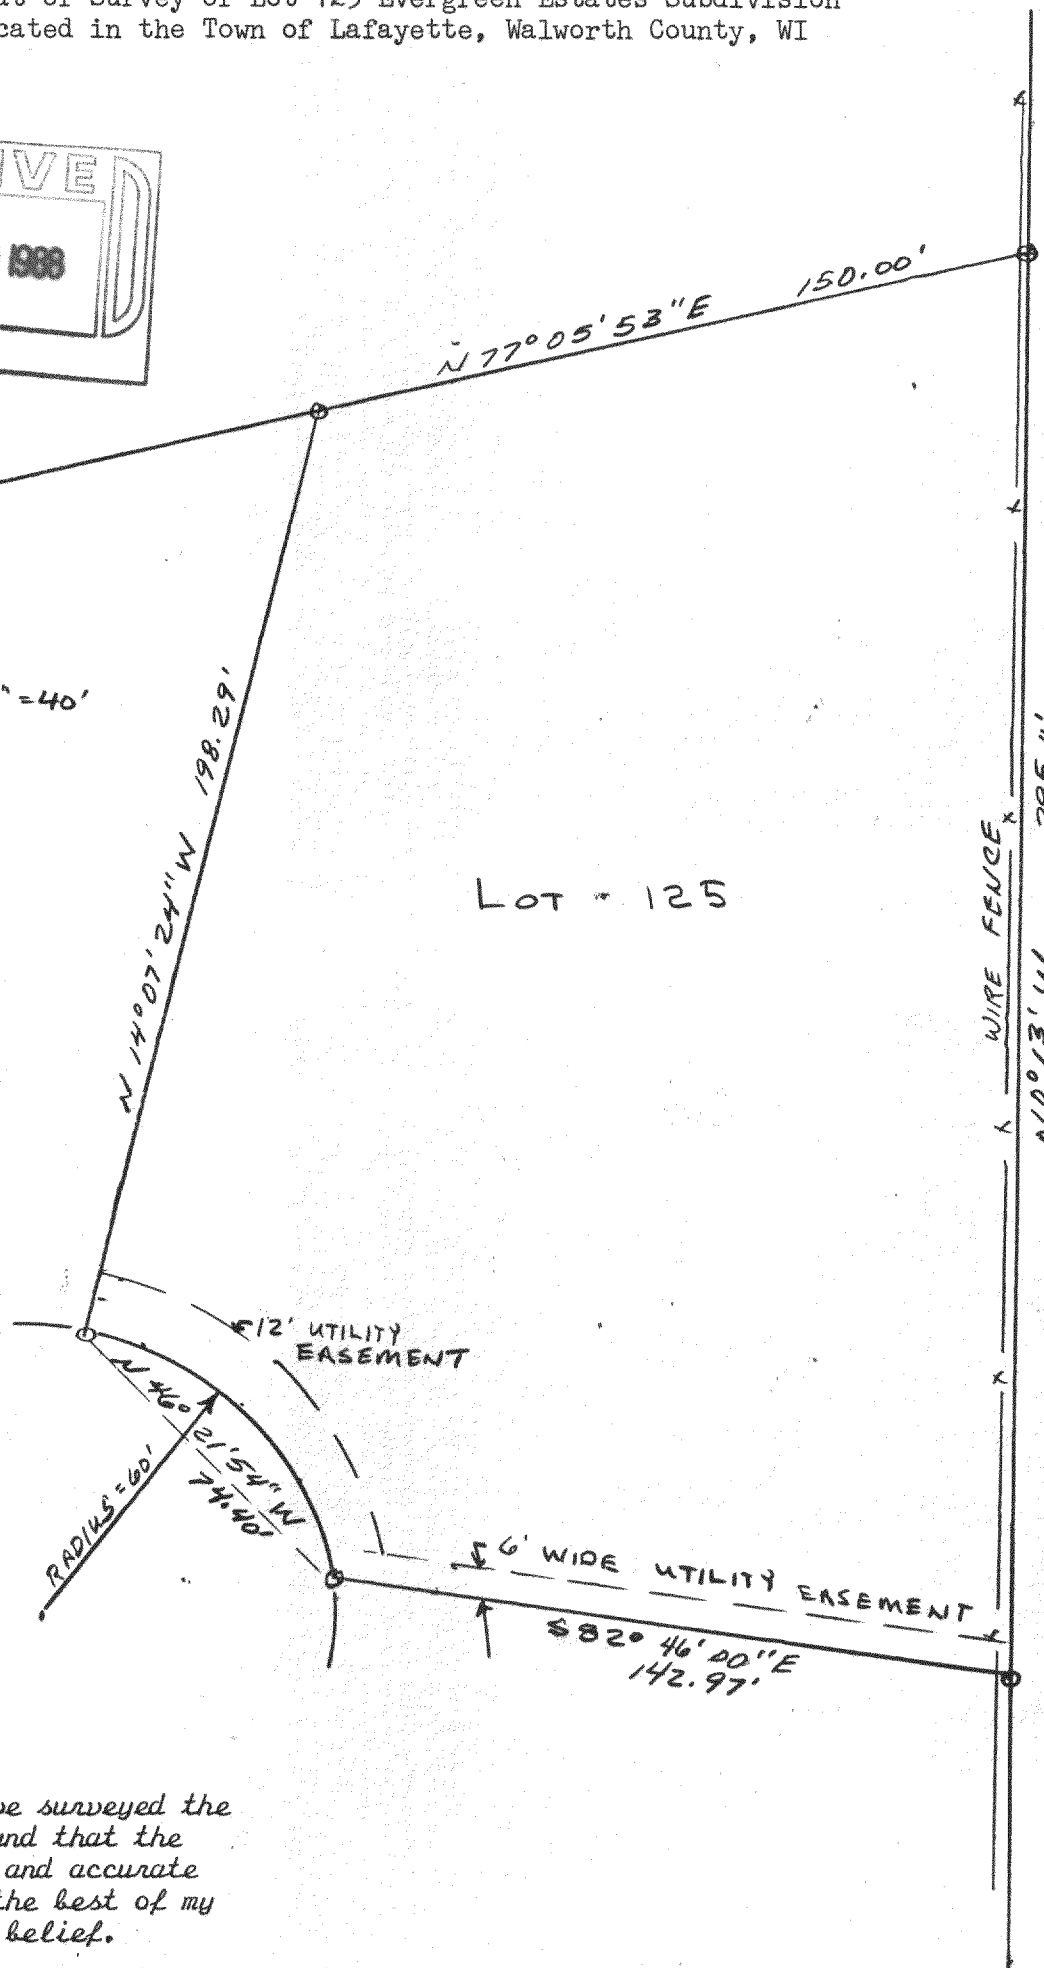

I hereby certify that I have surveyed the
property described hereon and that the
map shown hereon is a true and accurate
representation thereof to the best of my
professional knowledge and belief.

Dated this 18 day of DEC., 1987

Daniel D. Cooper

Daniel D. Cooper, RLS No. S-1464

Bearings referenced to the original Plat

DRAWING NO. 3174-S

317-154