


Farris, Hansen & Associates, Inc.

7 RIDGEWAY COURT, P.O. BOX 487, ELKHORN, WISCONSIN

TEL. 414-723-2098

LOCATION: LOT 29 EVERGREEN ESTATES IN SW 1/4 SECTION 19,
TOWN 3 NORTH, RANGE 17 EAST WALWORTH COUNTY WISCONSIN

WORK ORDERED BY: JAMES TIMMS

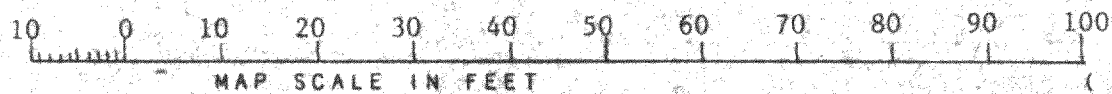


MAP LEGEND



- = IRON PIPE STAKE FOUND
- = IRON PIPE STAKE SET
- = IRON ROD STAKE FOUND
- = IRON ROD STAKE SET
- = CONCRETE MONUMENT FOUND
- (XXXXX) = RECORD DIMENSION

OVERLOOK COURT

EDGE OF 23'- WIDE BITUMINOUS PAVEMENT

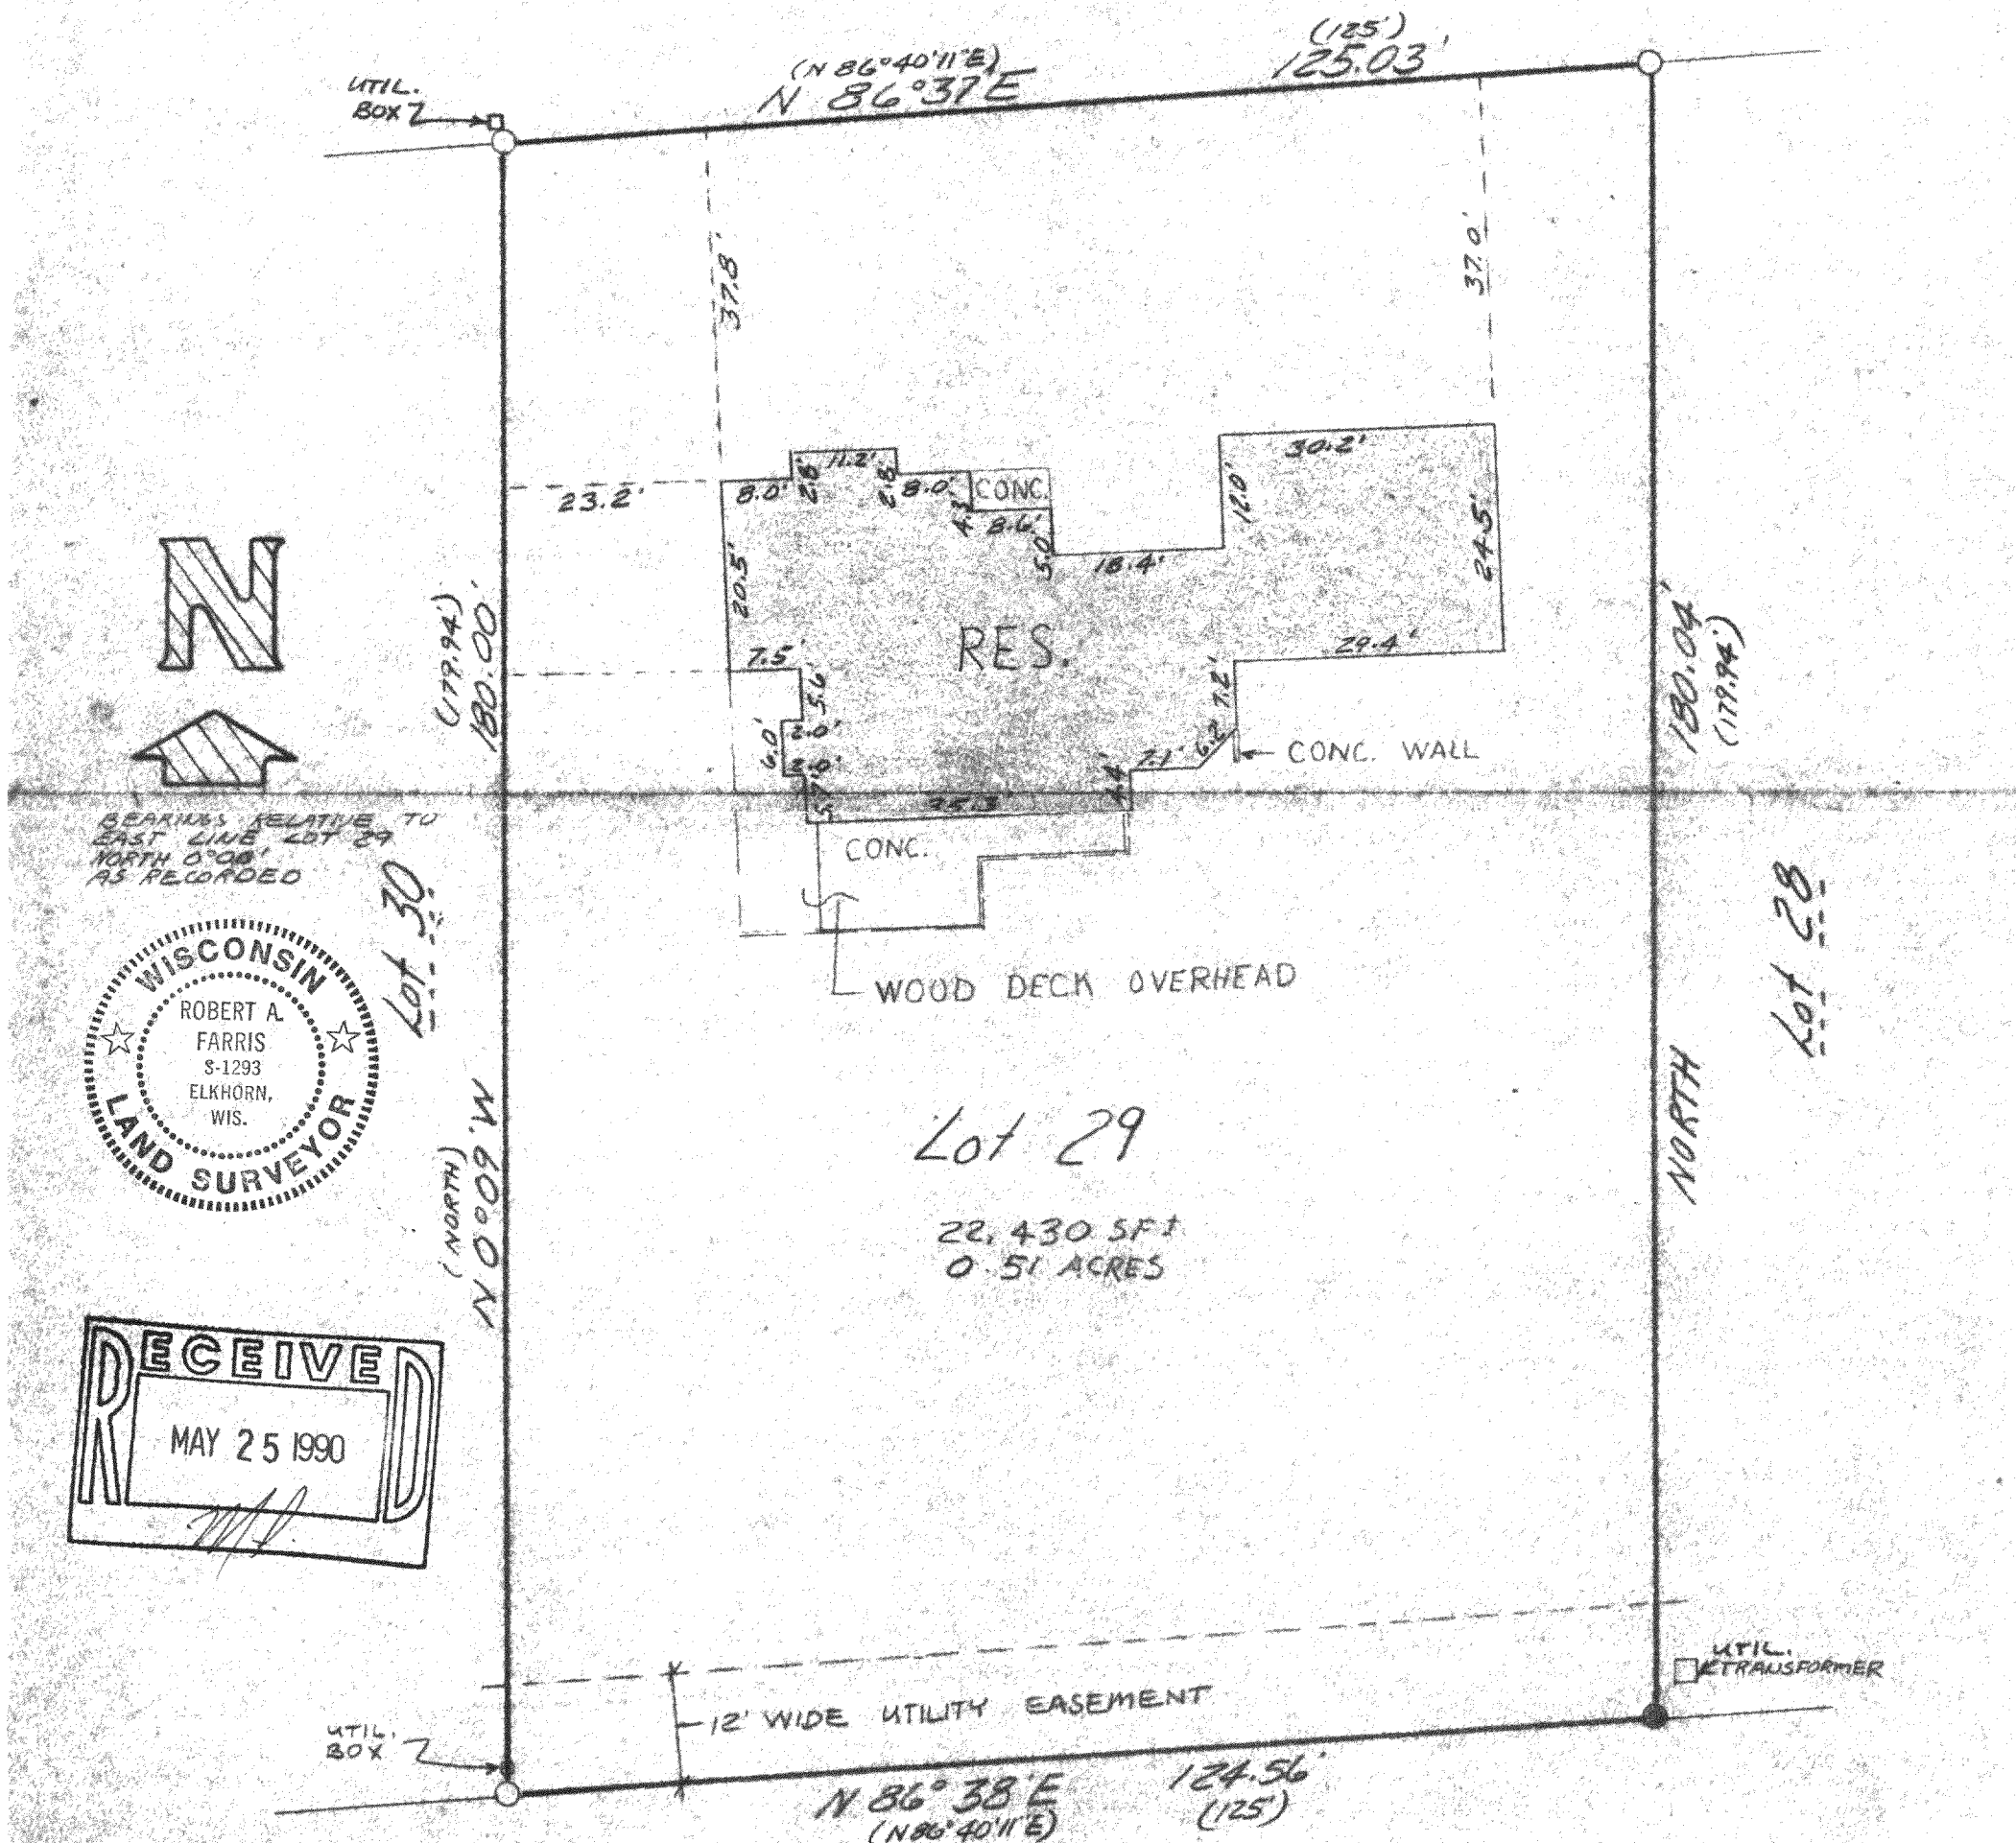

BEARINGS RELATIVE TO
EAST LINE LOT 29
NORTH 0° 00' AS RECORDED

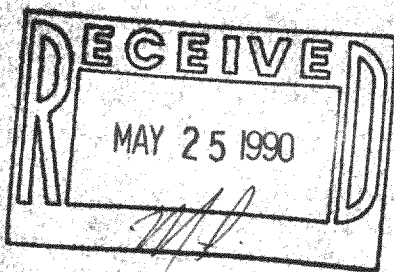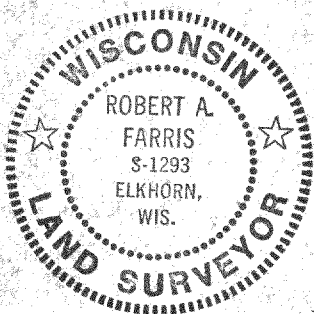

NOTE: COPIES OF THIS MAP TO WHICH THE FOLLOWING CERTIFICATE WILL APPLY ARE BLUE LINE PRINTS SHOWING SURVEYOR'S SEAL AND SIGNATURE IN BLACK INK. COPIES BY ANY OTHER MEANS MAY HAVE ALTERATIONS WHICH DO NOT REPRESENT THE SURVEYOR'S WORK PRODUCT.

I hereby certify that the above described property has been surveyed under my direction and that the above map is a true representation thereof and shows the size and location of the property, its exterior boundaries, the location of all visible structures and dimensions of all principal buildings thereon, boundary fences, apparent easements, roadways and visible encroachments, if any. This survey is made for the use of the present owners of the property, and also those who purchase, mortgage, or guarantee the title thereto within one year from the date hereof.

NOTE: SNOW COVER 1"± ON 12/19/89

DATED: 05/04/88

Robert A. Farris

PROJ. NO. 3017

REVISED: 12/19/89 TO SHOW NEW RESIDENCE CONSTRUCTED ON THIS LOT

Tax # KE-29

317-191