


ABELL
SURVEYING & MAPPING
DELAVAL, WISCONSIN 53115
414-728-6787

FOUND IRON PIPE LEANING FROM
 CORRECT CORNER




NOTE: THE BEARING ON THE WEST LINE OF LOTS 113 AND
 114 IS ASSUMED N 0°50'54" W AS SHOWN ON THE
 SUBDIVISION PLAT.

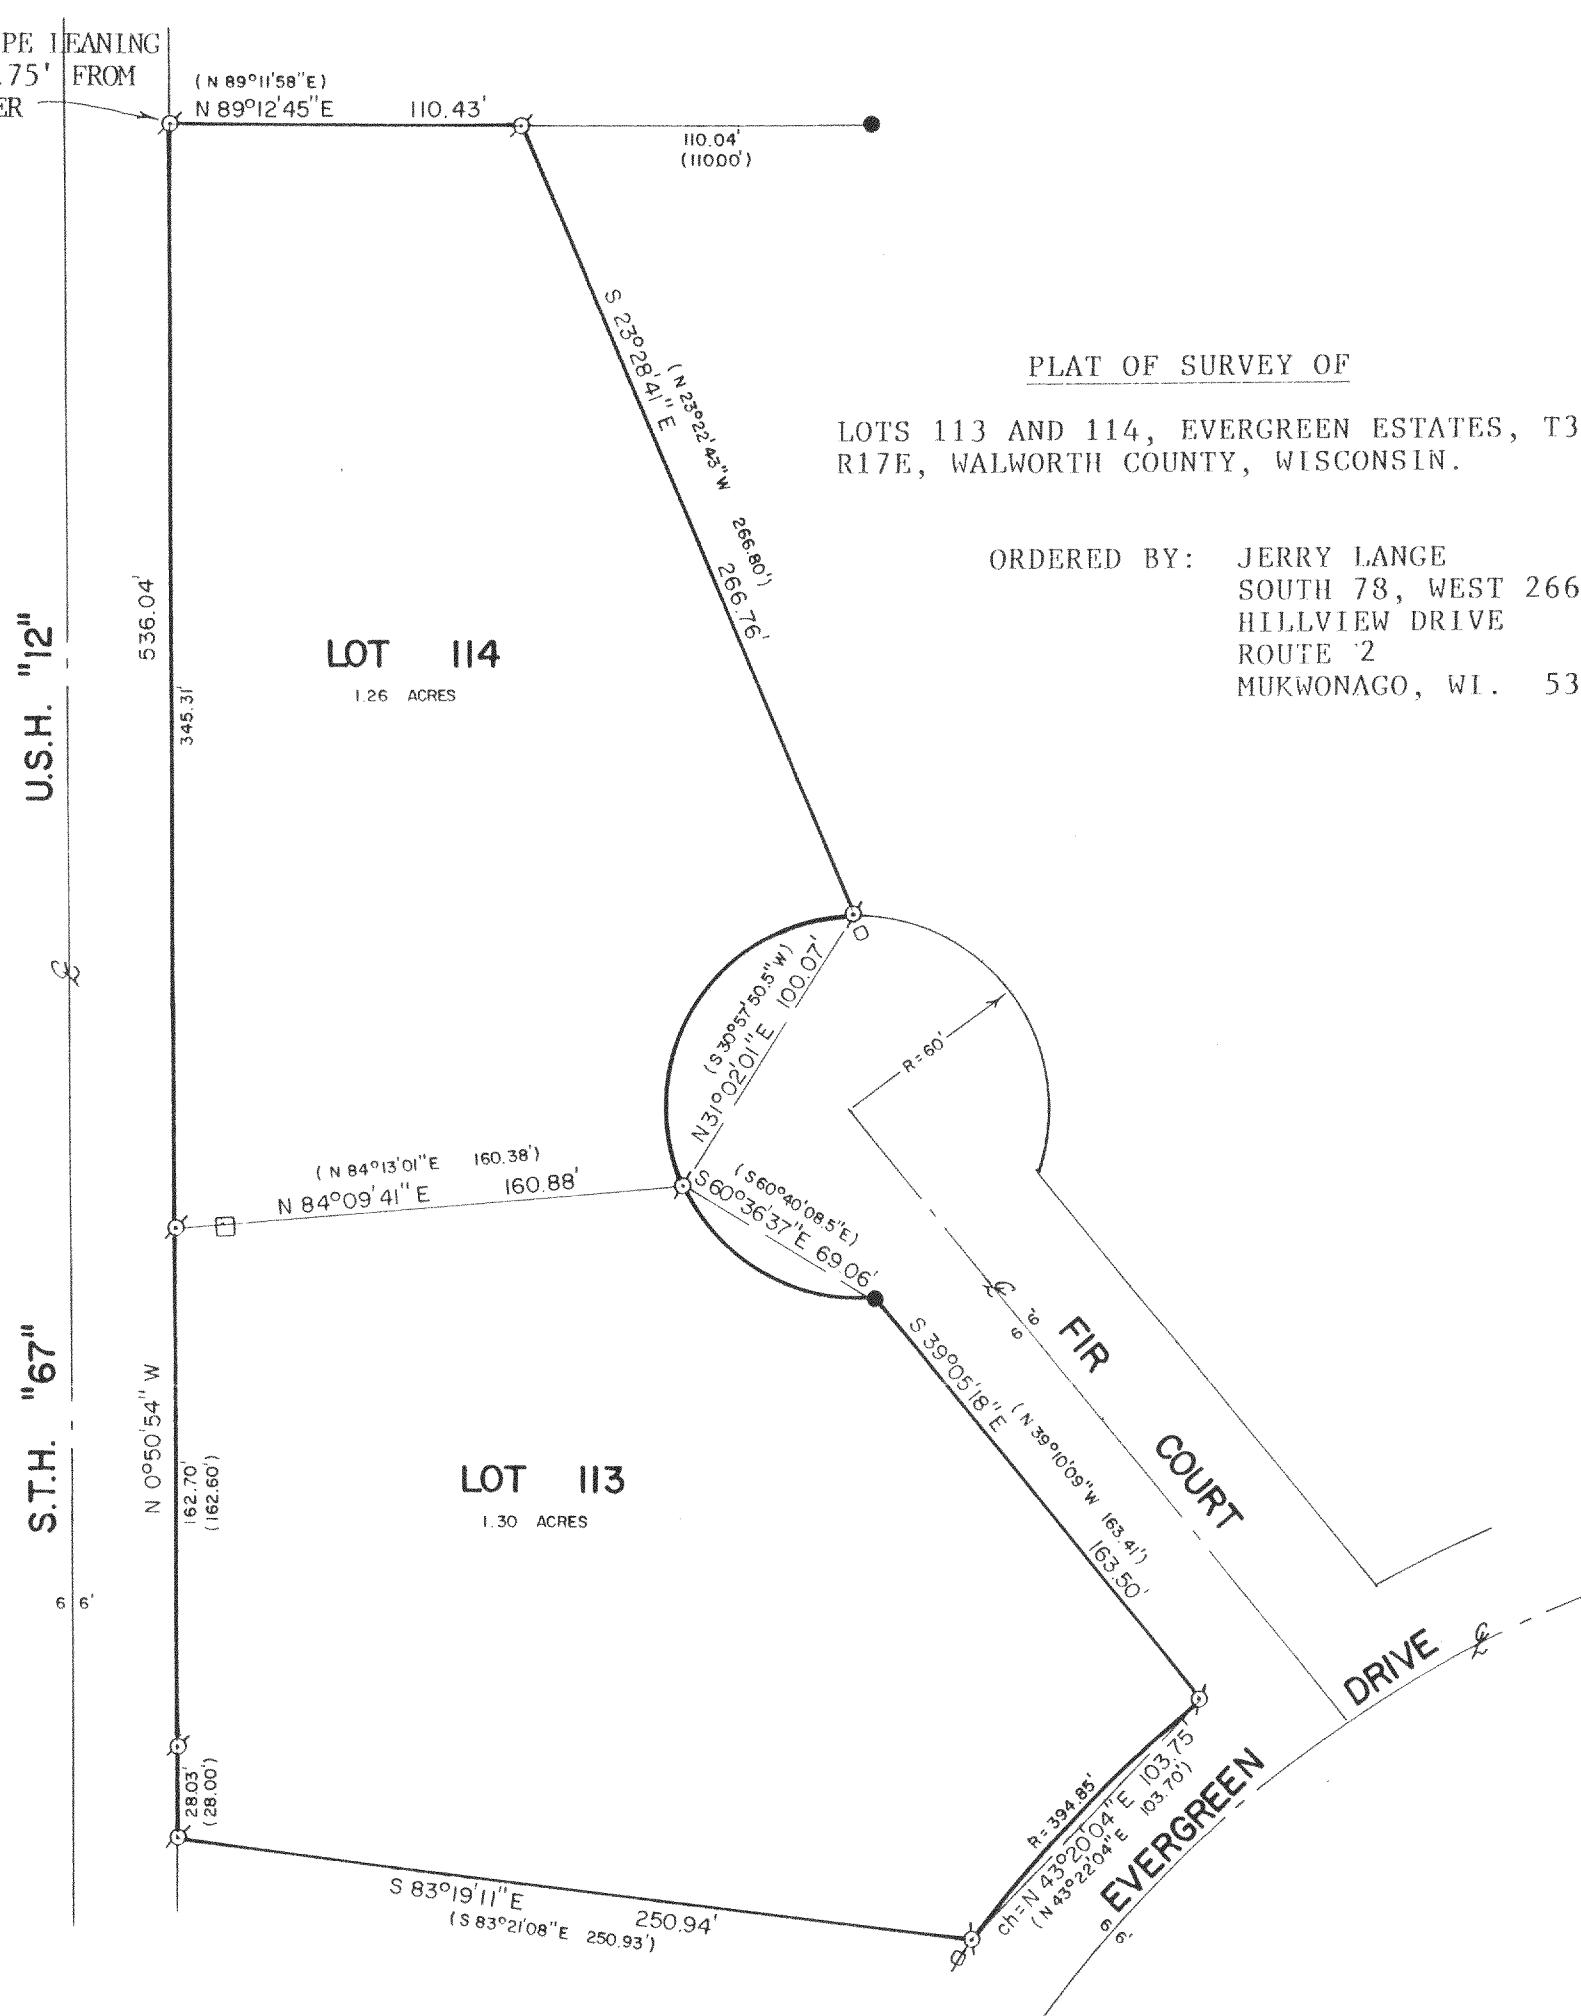

SCALE - 1"=60'

LEGEND

- - IRON PIPE FOUND
- - IRON ROD FOUND
- () - RECORDED AS
- - UTILITY BOXES

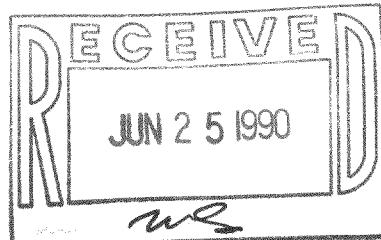

I HEREBY CERTIFY THAT I HAVE SURVEYED THE ABOVE
 DESCRIBED PROPERTY AND THAT THE ABOVE MAP IS A
 TRUE REPRESENTATION THEREOF AND SHOWS THE SIZE
 AND LOCATION OF THE PROPERTY, ITS EXTERIOR
 BOUNDARIES, THE LOCATION OF ALL VISIBLE STRUCTURES
 AND DIMENSIONS OF ALL PRINCIPAL BUILDINGS THEREON,
 BOUNDARY FENCES, APPARENT EASEMENTS, ROADWAYS AND
 VISIBLE ENCROACHMENTS, IF ANY, TO THE BEST OF MY
 KNOWNLEDGE AND BELIEF.

THIS SURVEY IS MADE FOR THE USE OF THE PRESENT
 OWNERS OF THE PROPERTY, AND ALSO THOSE WHO
 PURCHASE, MORTGAGE, OR GUARANTEE THE TITLE THERETO
 WITHIN ONE (1) YEAR FROM THE DATE HEREOF.

David F. Abell

DAVID F. ABELL
 WISCONSIN REGISTERED LAND SURVEYOR, S-1596

TAX # SKE - 113
 KE - 114

April 11, 1990
 DATE JOB NUMBER - 90067
 NOTE: THIS IS NOT A CERTIFIED COPY UNLESS SEALED.