


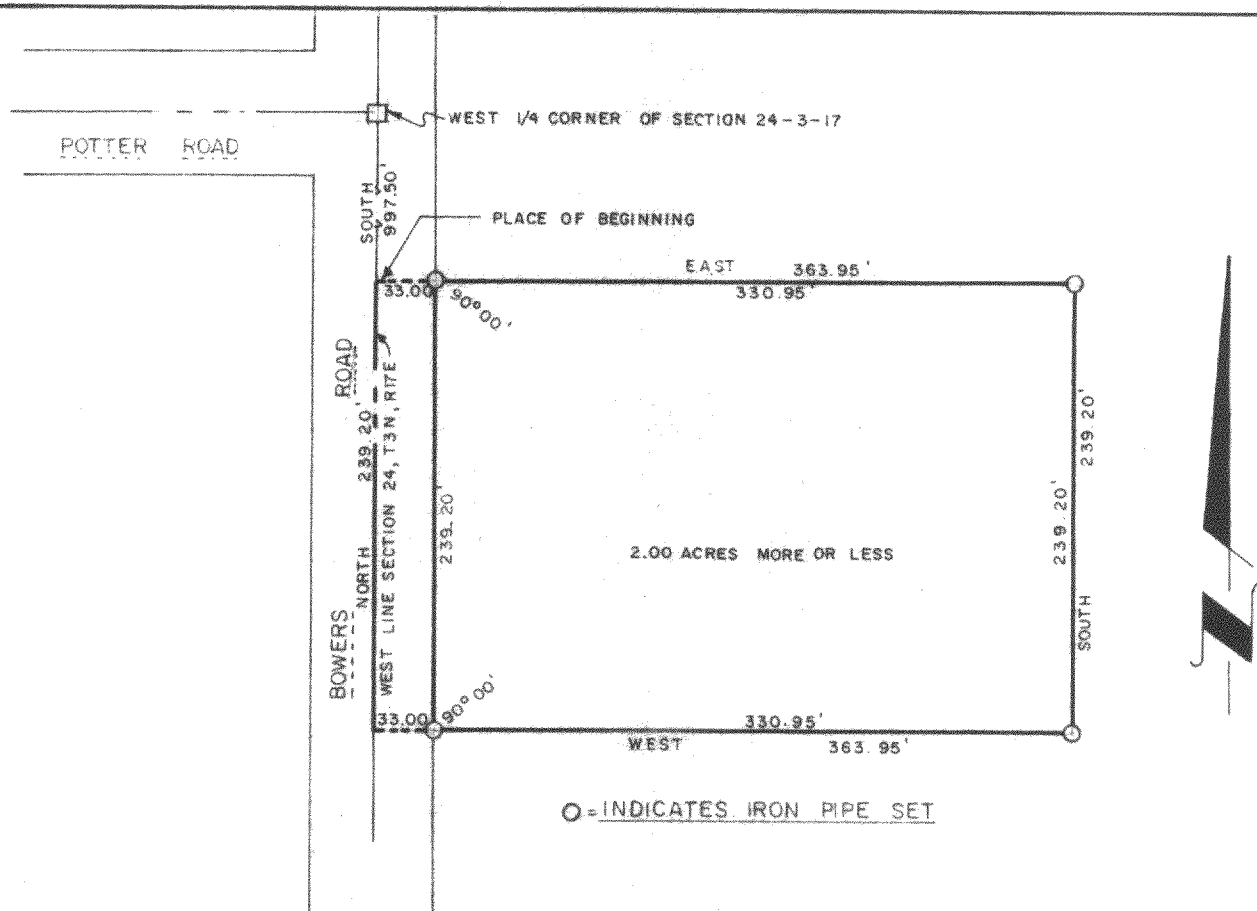

PLAT OF SURVEY OF

A part of the NW $\frac{1}{4}$ of the SW $\frac{1}{4}$ of Section 24, T3N, R17E,
Walworth County, Wisconsin, described as follows, to-wit:

Commencing at the West $\frac{1}{4}$ corner of said Section 24;
Thence South along the West line of said Section 24;
997.50 feet to the place of beginning; Thence East
363.95 feet to an iron pipe; Thence South parallel
with said West line of said Section 24, 239.20 feet
to an iron pipe; Thence West 363.95 feet to said
West line of said Section 24; Thence North along
said West line of said Section 24, 239.20 feet to
the place of beginning containing 2.00 acres of land
more or less.


CERTIFICATE

I, James F. Biagi, surveyor, do hereby
certify that I have surveyed the lands
hereon described.

December 10, 1971

James F. Biagi

R.L.S. 272

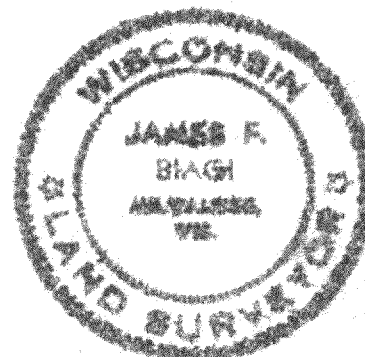

Cont. Survey 460 - Now C.S. 799

317-20