



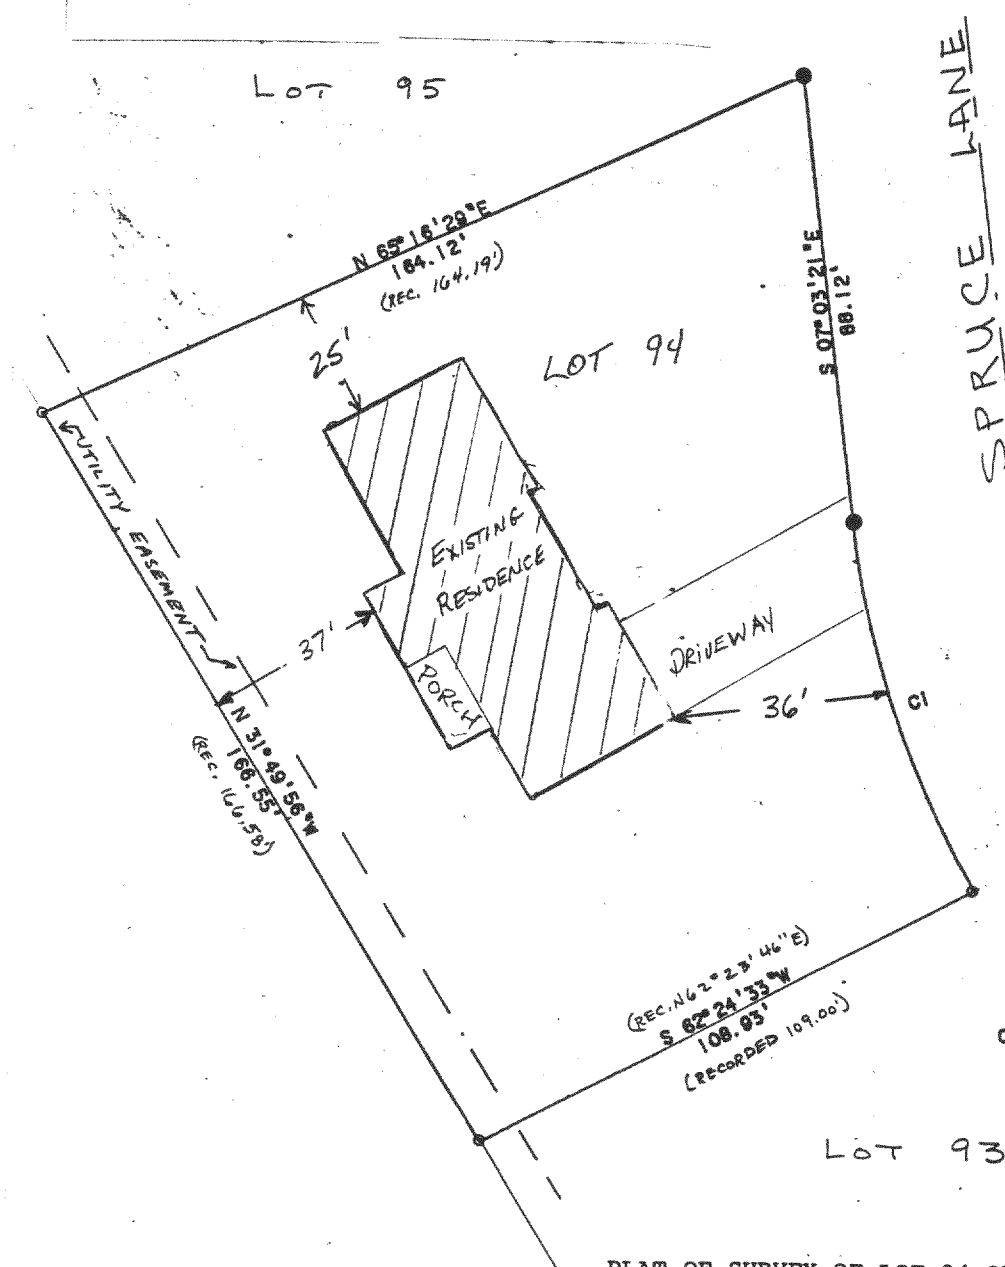

PLAT OF SURVEY OF LOT 94 OF EVERGREEN ESTATES,
LOCATED IN T3N, R17E, WALWORTH COUNTY, WISCONSIN.

D. D. Cooper & CO., INC
Rt 4 Box 508B • Elkhorn WI 53121

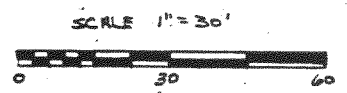

- - FOUND IRON BAR
- - FOUND IRON PIPE

Original copy only if sealed in red.



Bearing Reference: Westerly line of lot assumed to
bear N. 31°49'56" W

CENTRAL ANGLE	RADIUS	ARC	TANGENT	CHORD	CHORD BEARING
23°19'38"	188.66'	76.81'	38.94'	76.28'	S 18°43'24"E

I hereby certify that I have surveyed the
property described hereon and that the
map shown hereon is a true and accurate
representation thereof to the best of my
professional knowledge and belief.

Dated this 5th day of Sept., 1990

Daniel D. Cooper
Daniel D. Cooper, RLS No. 5-1464

DRAWING No. 3524

RECEIVED
FEB 20 1991

Reduced

TAX KEY #
KE 00094

317-202