

DUNHAM SURVEYING, S.C.
SURVEYING & SUBDIVIDING
DELAVER, WISCONSIN 53115



Scale - 1" = 30'

1" = 1" Iron Pipe Found

1 1/2" X 24" Iron Pipe Set

1/2" X 24" Iron Pipe Set


--- = Decorative Fence

Bearings referenced to the previously recorded bearing of
S1°09'E along the west line of Oak Creek Drive

Survey ordered by: Realty World, Carmin Realtors

811 East Geneva Street

Delavan, WI 53115

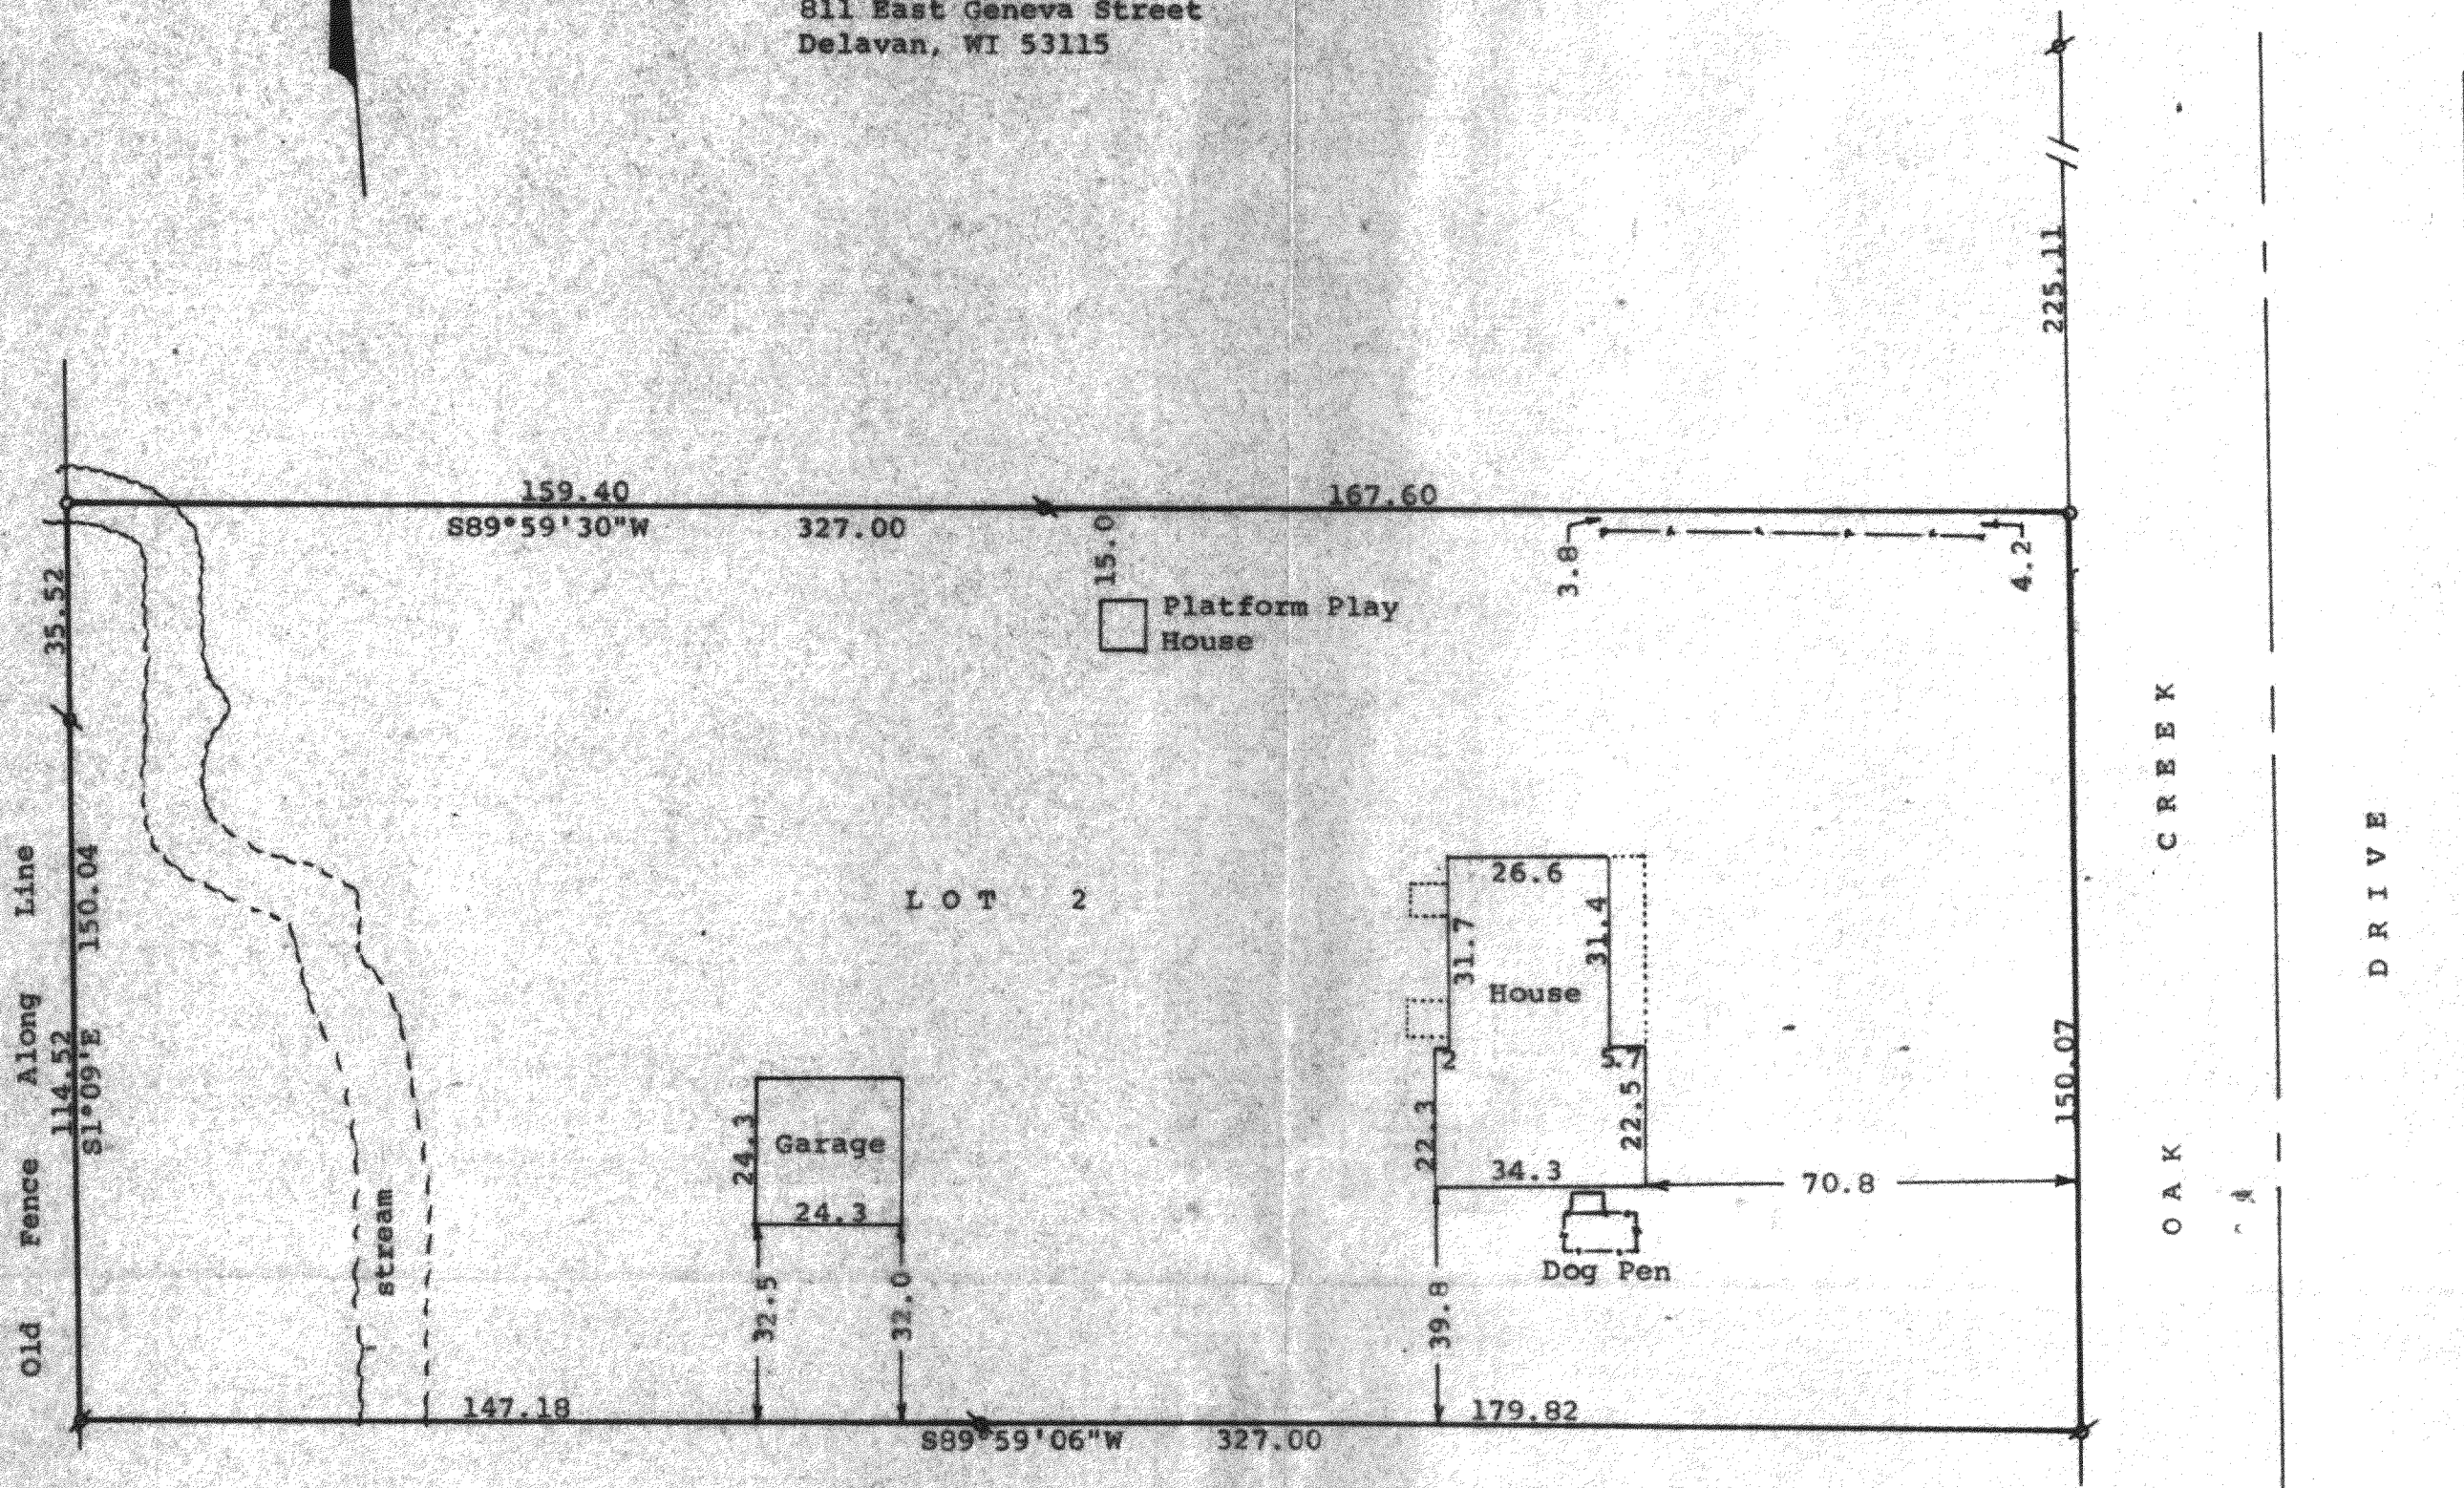

STATE OF WISCONSIN)
COUNTY OF WALWORTH)



I, George T. Dunham, Surveyor, certify that I have surveyed the
property described as follows:

Lot 2 of Certified Survey No. 112 recorded in Volume No. 1 of
Certified Surveys on Page 112, in the Office of the Register of
Deeds, Walworth County, Wisconsin, and being a parcel of land
located in the Northeast 1/4 of the Southwest 1/4 of Section 19,
T 3 N, R 17 E, Walworth County, Wisconsin.

and that the plat shown hereon is a correct representation thereof and shows
the size and location of the property, its exterior boundaries, the location
of all visible structures and dimensions of all principal buildings thereon,
boundary fences, apparent easements, roadways and visible encroachments, if
any, and that I have surveyed the property hereon described, according to the
official records, to the best of my knowledge and belief.

May 17, 1990

George T. Dunham
George T. Dunham, Surveyor

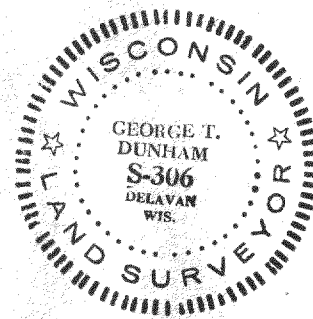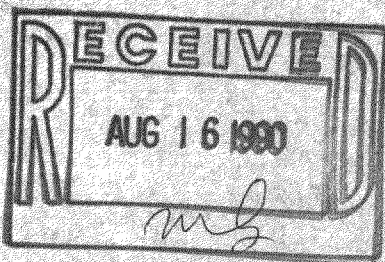

Survey # 317-208

Tax Key # KA11200002