


DUNHAM SURVEYING, S.C.
SURVEYING & SUBDIVIDING
DELAVER, WISCONSIN 53115

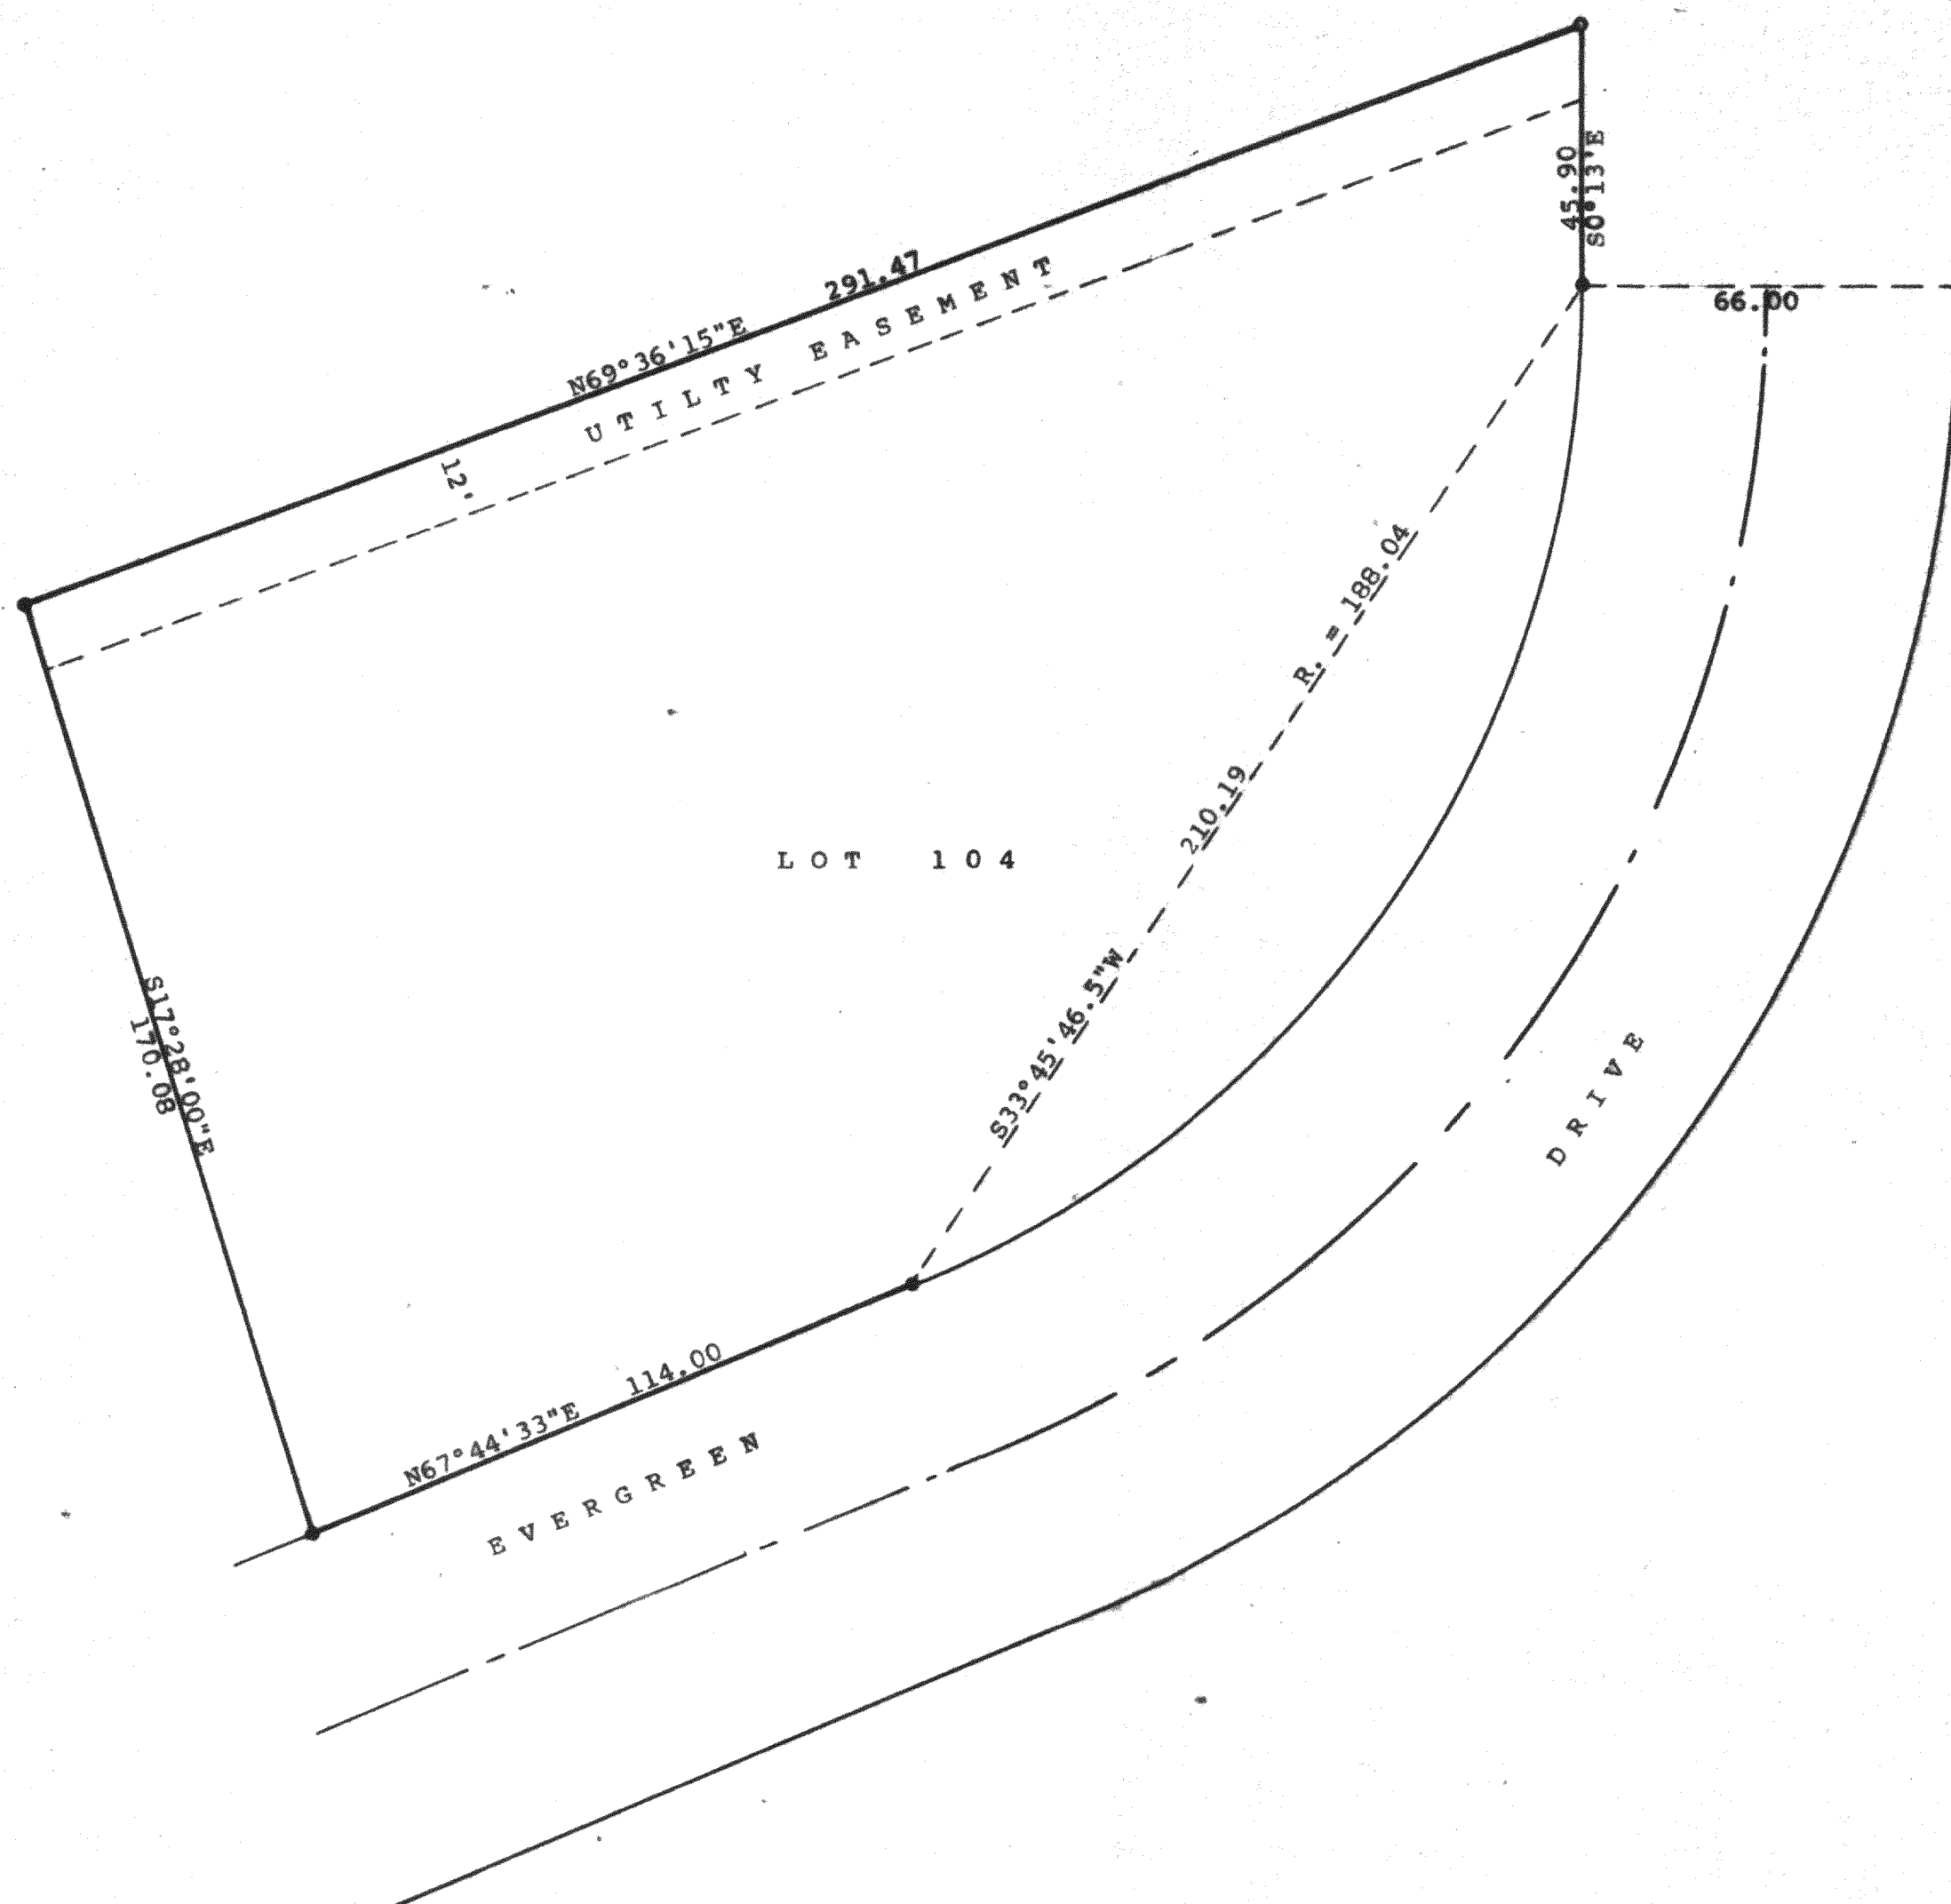

N

Scale - 1" = 30'

● = 1" Iron Rod Found
○ = 1 1/4" X 30" Iron Pipe Found bent. Pulled and reset.

Bearings shown are those on the recorded plat of Evergreen Estates
Survey ordered by:
Realty World, Carmin Realtors
811 East Geneva Street
Delaver, WI 53115

STATE OF WISCONSIN)
COUNTY OF WALWORTH)



I, George T. Dunham, Surveyor, certify that I have surveyed the property described as follows:

Lot 104 in Evergreen Estates, a subdivision located in Sections 18 and 19, T 3 N, R 17 E, Walworth County, Wisconsin.

and that the plat shown hereon is a correct representation thereof and shows the size and location of the property, its exterior boundaries, the location of all visible structures and dimensions of all principal buildings thereon, boundary fences, apparent easements, roadways and visible encroachments, if any, and that I have surveyed the property hereon described, according to the official records, to the best of my knowledge and belief.

August 7, 1989

George T. Dunham
George T. Dunham, Surveyor

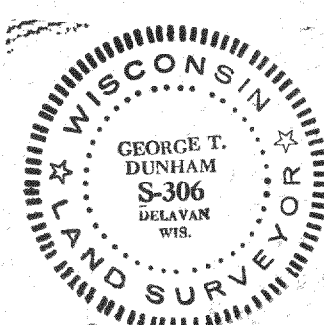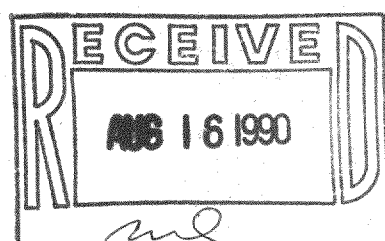

Survey # 217-210

TAX KEY # KE 00104