


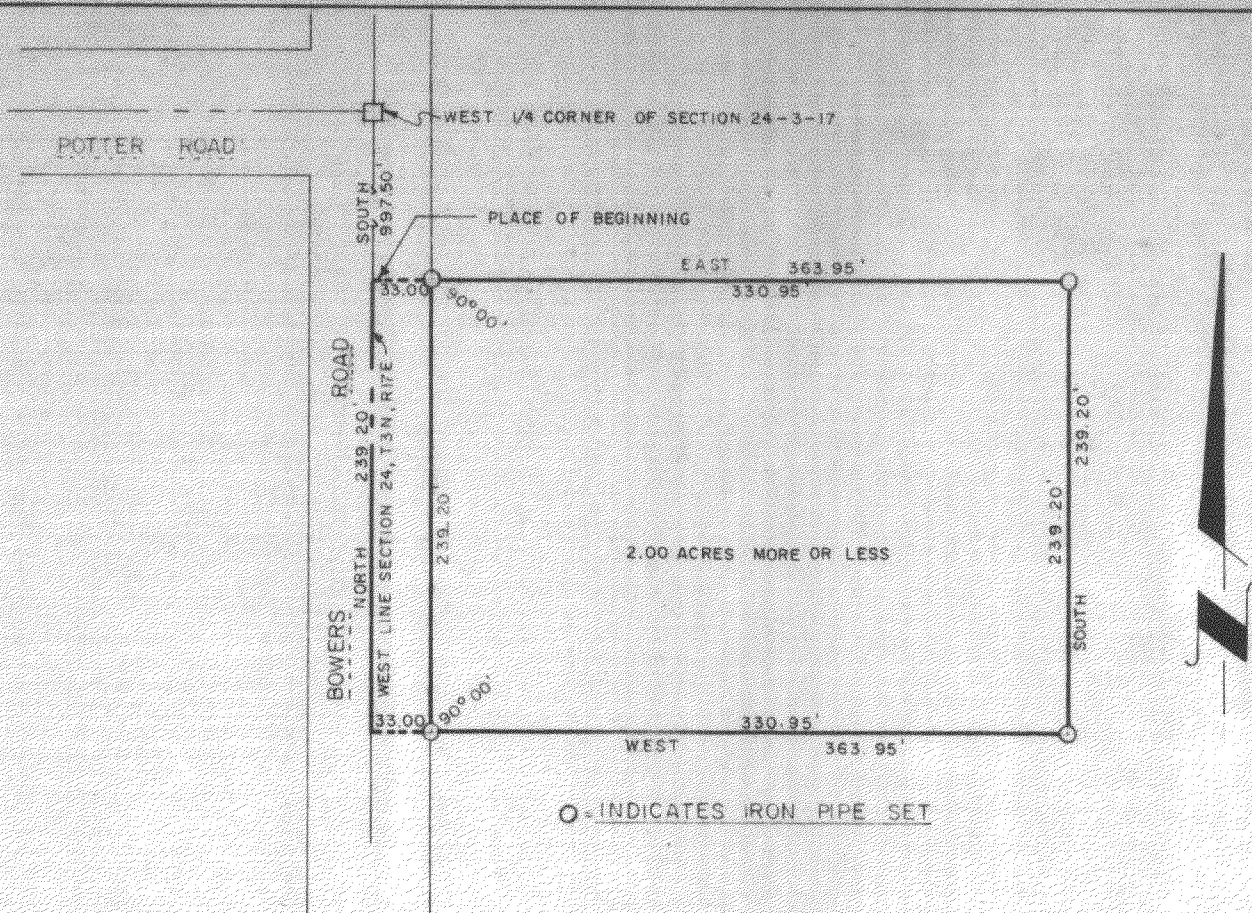

PLAT OF SURVEY OF

A part of the NW $\frac{1}{4}$ of the SW $\frac{1}{4}$ of Section 24, T3N, R17E, Walworth County, Wisconsin, described as follows, to-wit:

Commencing at the West $\frac{1}{4}$ corner of said Section 24; Thence South along the West line of said Section 24, 997.50 feet to the place of beginning; Thence East 363.95 feet to an iron pipe; Thence South parallel with said West line of said Section 24, 239.20 feet to an iron pipe; Thence West 363.95 feet to said West line of said Section 24; Thence North along said West line of said Section 24, 239.20 feet to the place of beginning containing 2.00 acres of land more or less.


CERTIFICATE

I, James F. Biagi, surveyor, do hereby certify that I have surveyed the lands hereon described.

December 10, 1971

James F. Biagi

R.L.S. 272

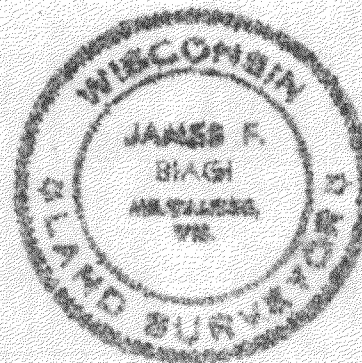

Carl Survey 799 - part of

317-23