


**ABELL
SURVEYING & MAPPING**

DELAVAN, WISCONSIN 53115

414-728-6737

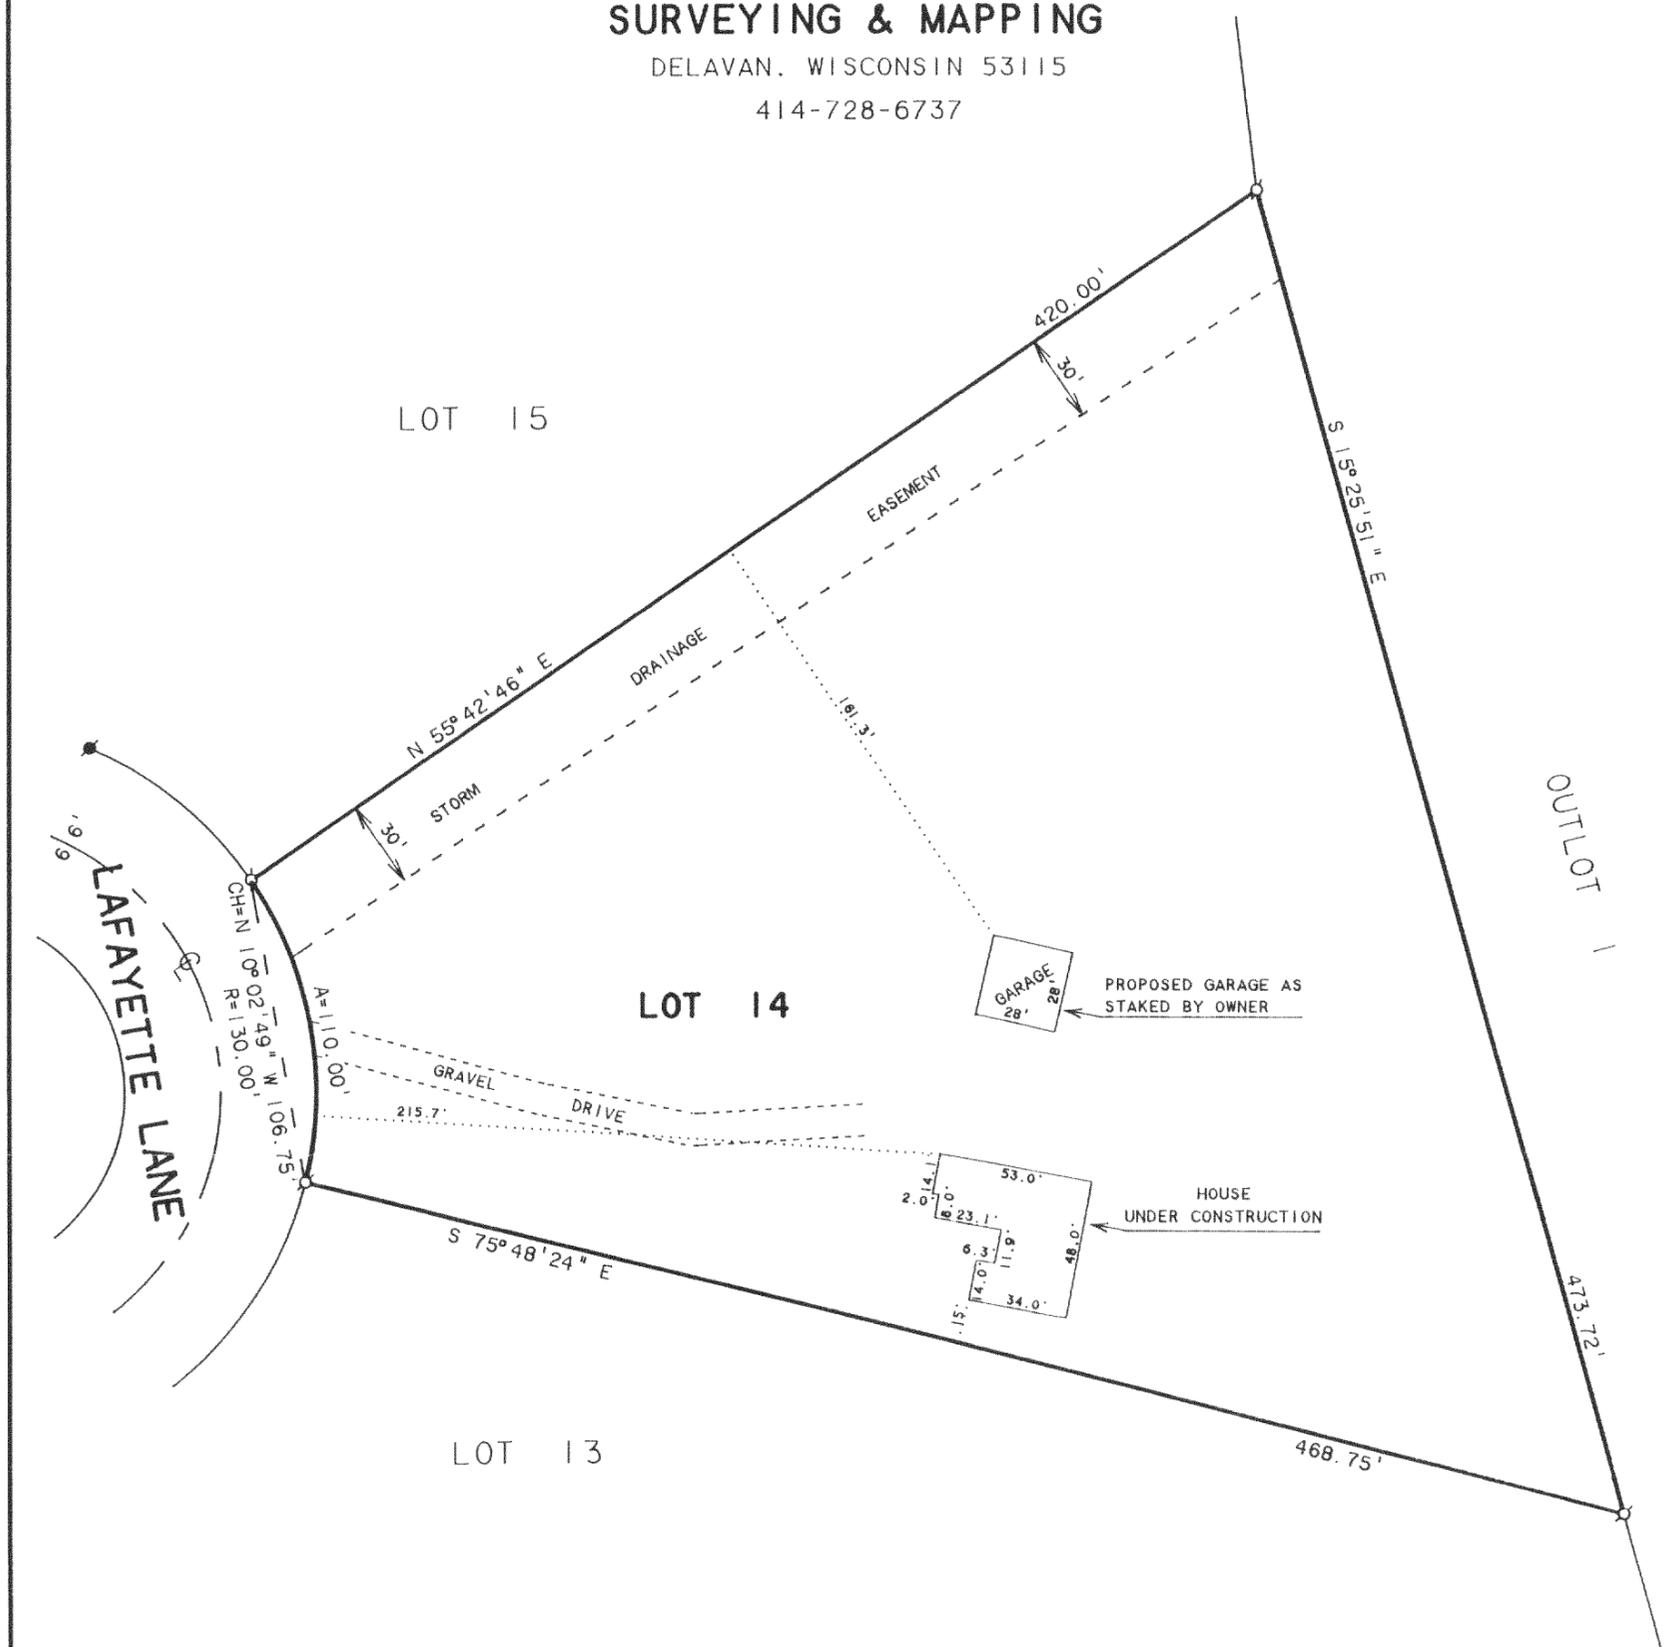

PLAT OF SURVEY OF

LOT 14, SUGAR CREEK FARMS, LOCATED IN
T3N. R17E. WALWORTH COUNTY, WISCONSIN.



SCALE 1"=60'

LEGEND

- - IRON PIPE FOUND
- - IRON BAR FOUND

NOTE: BEARINGS ARE REFERENCED TO THE
RECORDED SUBDIVISION PLAT.

ORDERED BY: HACKBARTH BUILDERS
P.O. BOX 316
EAST TROY, WI. 53120



I, DAVID F. ABELL, DO HEREBY CERTIFY THAT I HAVE SURVEYED THE PROPERTY HEREON DESCRIBED ACCORDING TO THE OFFICAL RECORDS AND THAT THE PLAT HEREON IS A CORRECT REPRESENTATION OF THE PROPERTY LINES TO THE BEST OF MY KNOWLEDGE AND BELIEF.

David F. Abell

DAVID F. ABELL
WISCONSIN REGISTERED LAND SURVEYOR. S-1596

NOVEMBER 15, 1991 REVISED DATE MAY 19, 1992
DATE JOB NUMBER - 91241
NOTE: THIS IS NOT A CERTIFIED COPY UNLESS SEALED.