

AMERICAN SURVEYING COMPANY, INC.


LAND SURVEYORS
11931 Hwy. "K"
FRANKSVILLE, WISCONSIN
TEL. NO. (414) 835-4774

PLAT OF SURVEY

PREPARED FOR: BADGER HOME BUILDERS
DESCRIPTION: LOT 2 BLOCK 4, "ALPINE TOWER ESTATES", BEING A PART OF THE NORTHEAST 1/4, SECTION 13, TOWN 3 NORTH, RANGE 17 EAST, IN THE TOWN OF LAFAYETTE, COUNTY OF WALWORTH, STATE OF WISCONSIN.

OWNER:
SIGNER



E KNIER ROAD

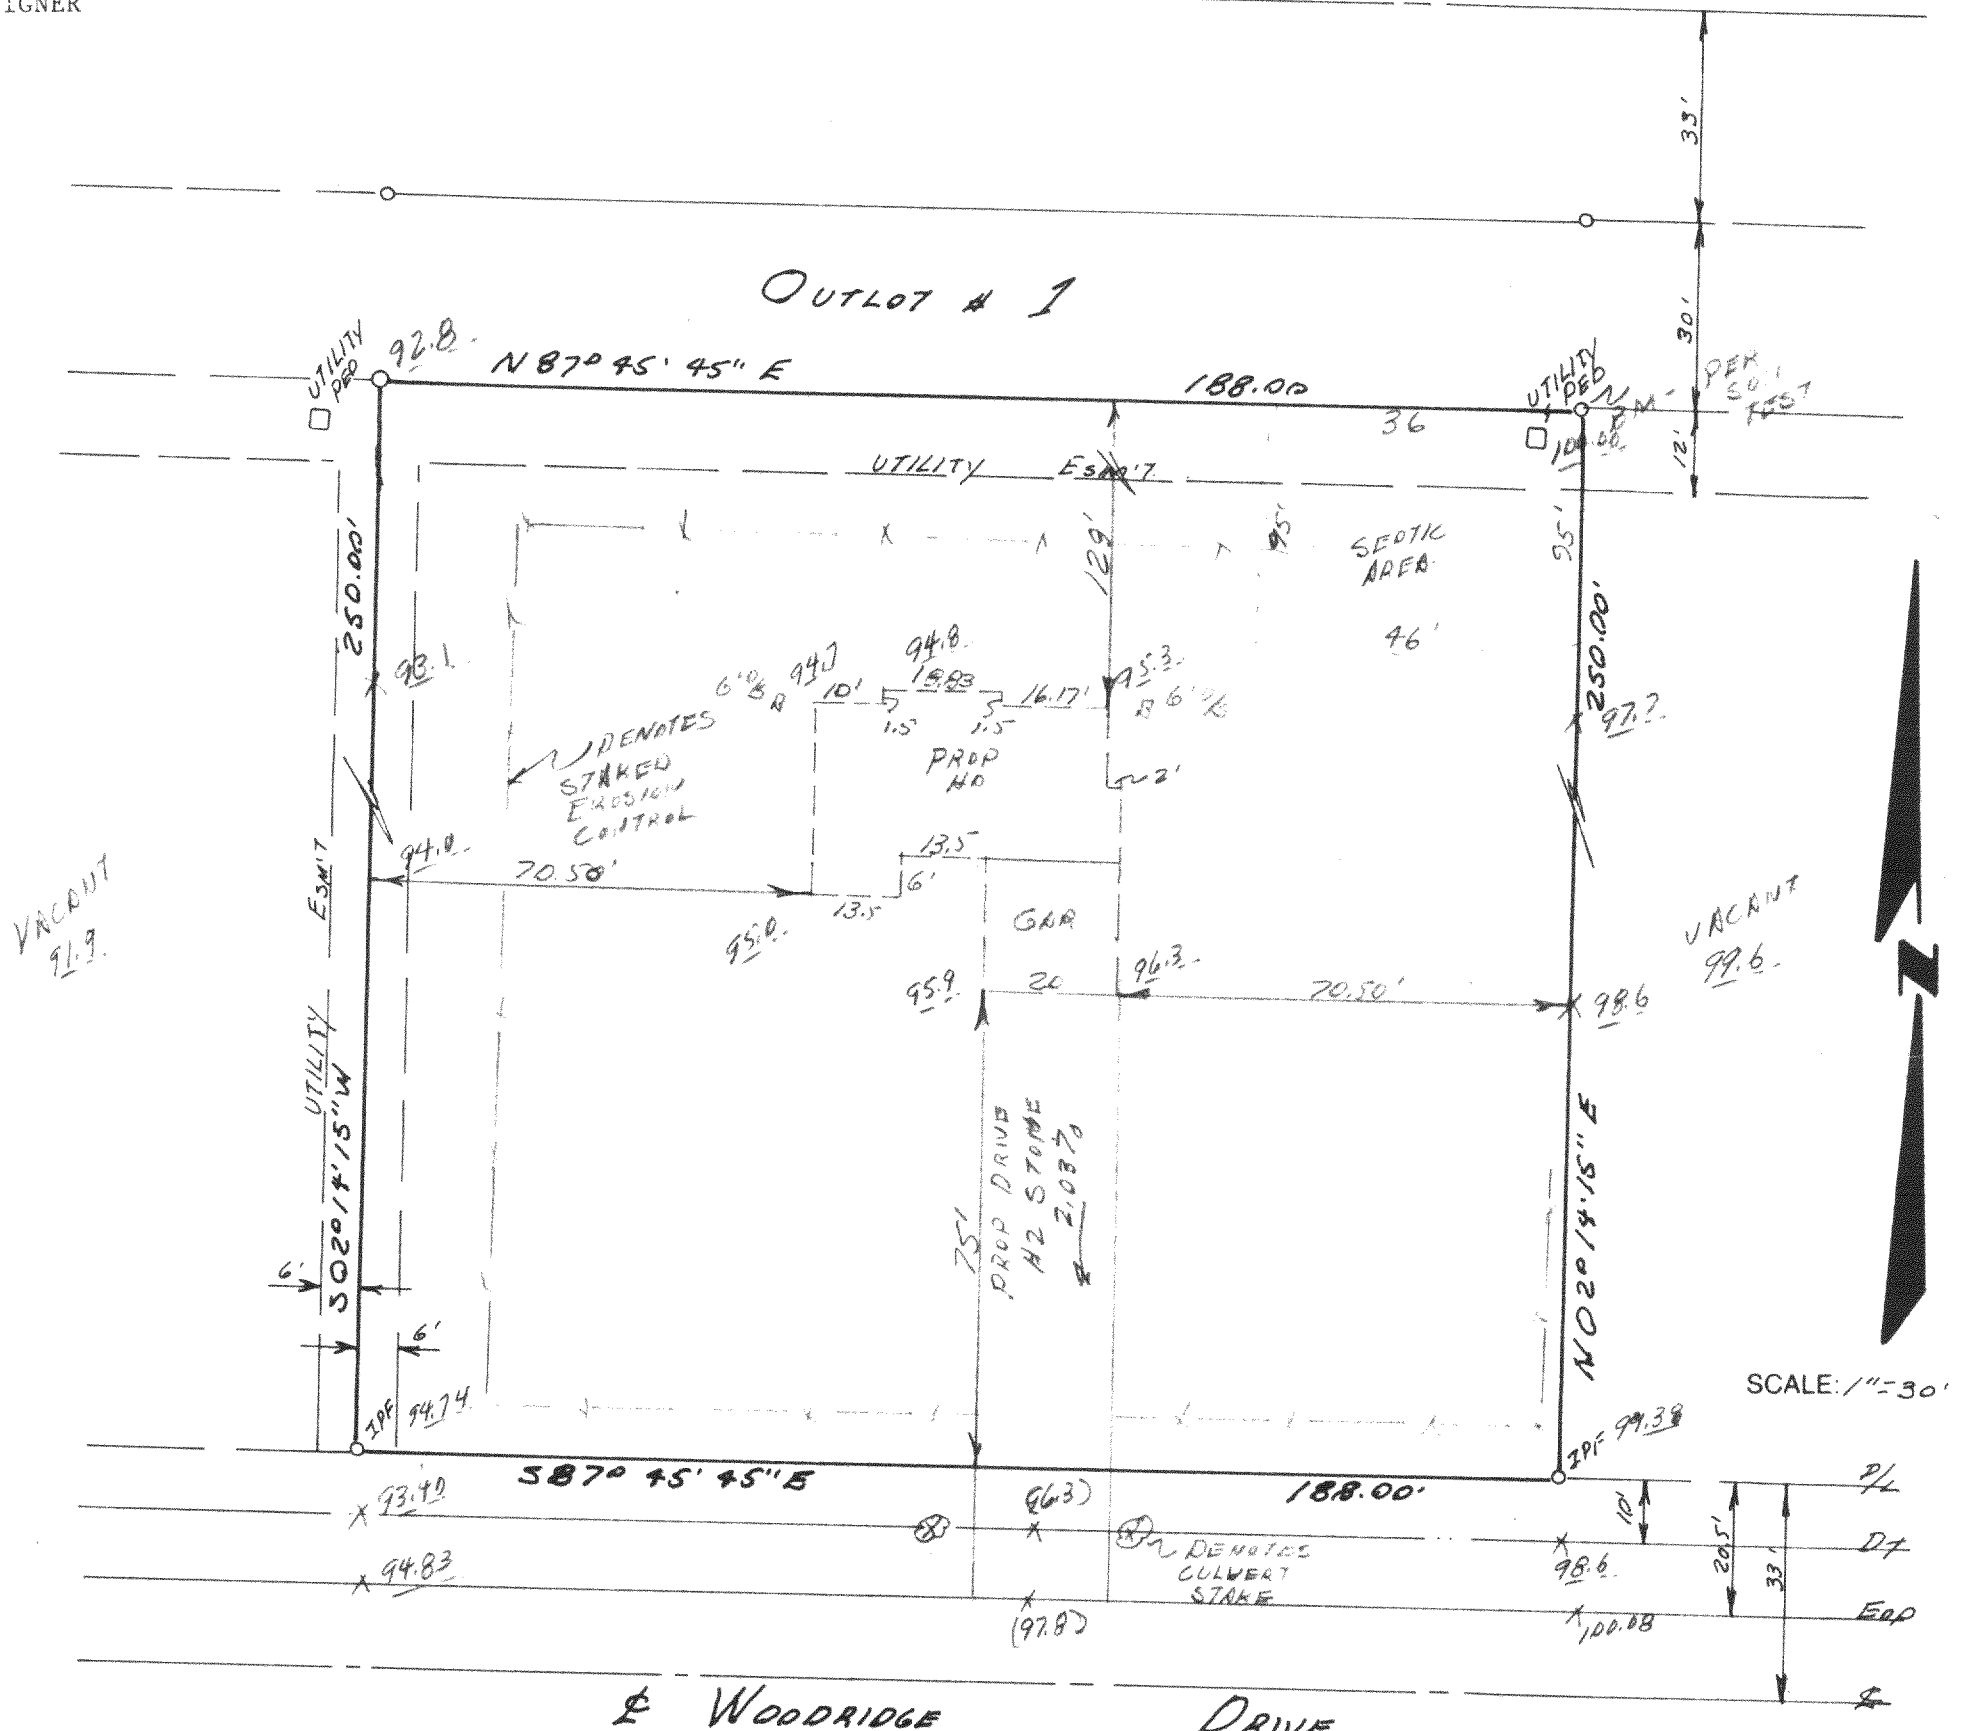

- HOUSE STAKED ON LINE
- ELEV'S BASED ON ASSUMED DATUM
- SUGG YARD GRD: 99.4
- SUGG GAR SLAB: 93.7

NOTE: SEPTIC AREA IS GREATER
THAN 25' FROM PROP. DWELLING.

NOTE: SUGGESTED YARD GRADE
MUST BE APPROVED BY THE
OWNER AND MUNICIPALITY.

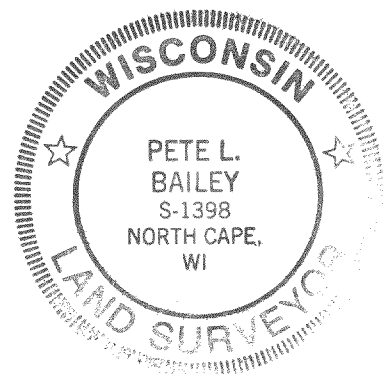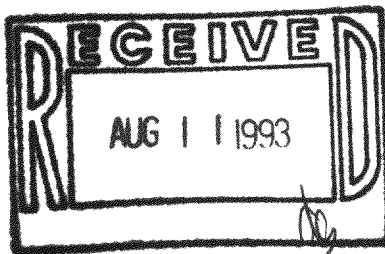

STATE OF WISCONSIN
COUNTY OF RACINE

I hereby certify that I have surveyed the above described property and the above map is a true representation thereof and shows the size and location of the property, its exterior boundaries, the location of all visible structures and dimensions of all principle buildings thereon, boundary fences, apparent easements, roadways and visible encroachments, if any.

This survey is made for the present owners of the property, and also those who purchase, mortgage, or guarantee the title thereto within one (1) year from the date thereof.

Dated at NORTH CAPE, this 28th day of July, 19 93. Recertified

Pete L Bailey
Registered Land Surveyor

Registered Land Surveyor

JOB NO. 93,069