


# Plot of Survey



WILLIAMSON

Survey For: WOLTER BROS. BUILDERS  
Location: Longmeadow Drive

**Description:** LOT 1 BLOCK 2 ALPINE TOWER ESTATES, a Subdivision located in part of the N.E. 1/4 of Section 13, Town 3 North, Range 17 East, of the 4th P.M. Town of Lafayette, Walworth County, Wisconsin.

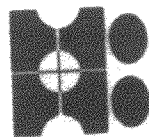

**INTERLINE SURVEY  
SERVICES, INC.**  
11221 W. FOREST HOME AVE.  
HALES CORNERS, WISCONSIN 53130  
PHONE 425-2060

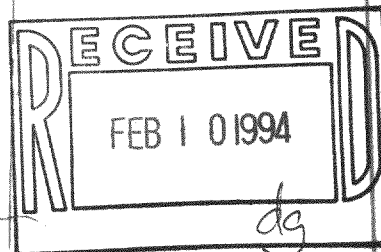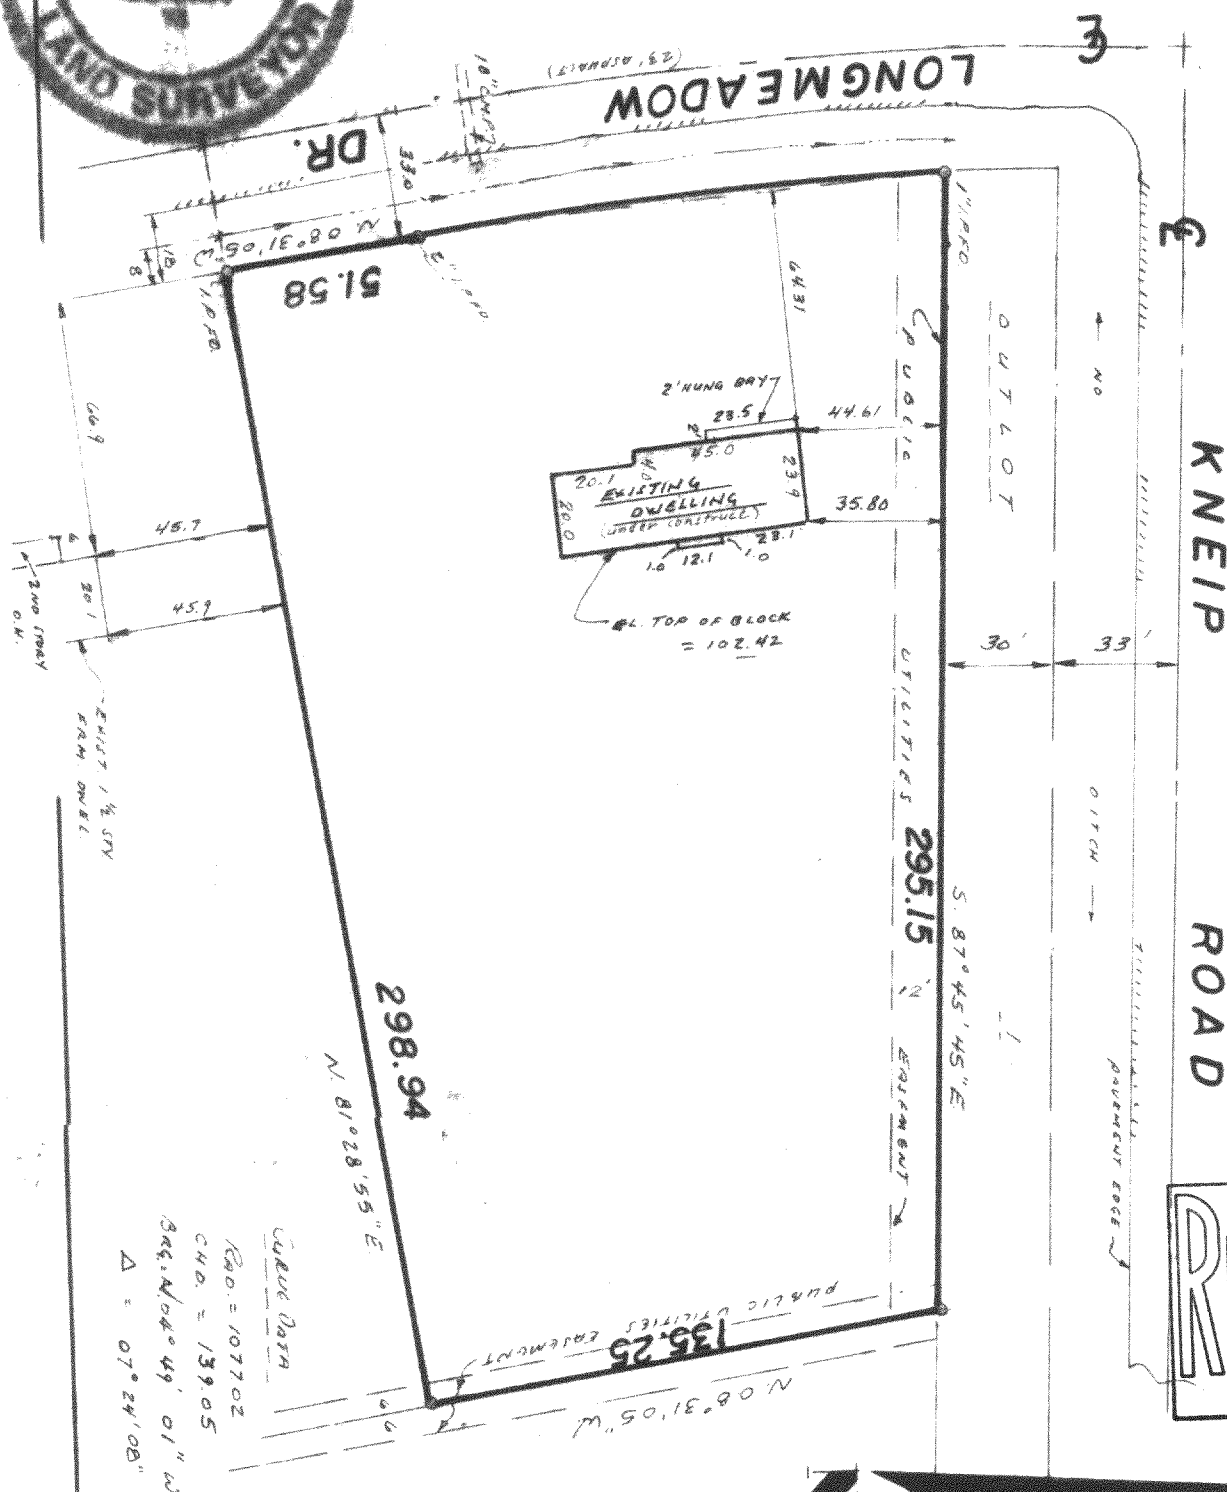

State of Wisconsin) ss  
Milwaukee County

# SURVEY CERTIFICATE

Scale: 1" = 50'

We, Interline Survey Services, Inc., certify that we have surveyed the above described property and the above map is a true representation thereof, and shows the size and location of the property, its exterior boundaries, the location and dimensions of all visible structures thereon, fences, apparent easements and roadways and visible encroachments, if any.

This survey is made for the exclusive use of the present owners of the Property, and also those who purchase, mortgage, or guarantee the title thereto, within one (1) year from date hereof.

*Randolph L. Baflekki*  
Wisconsin Registered Land Surveyor

Date: 1/12/94  
Job No.: 22652

KAT-23

317-309

Date: 10/19/93  
Job No.: 22442